
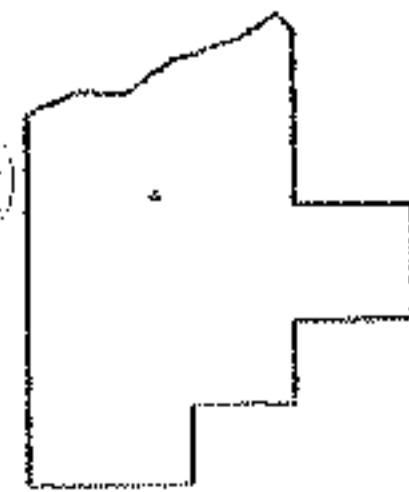
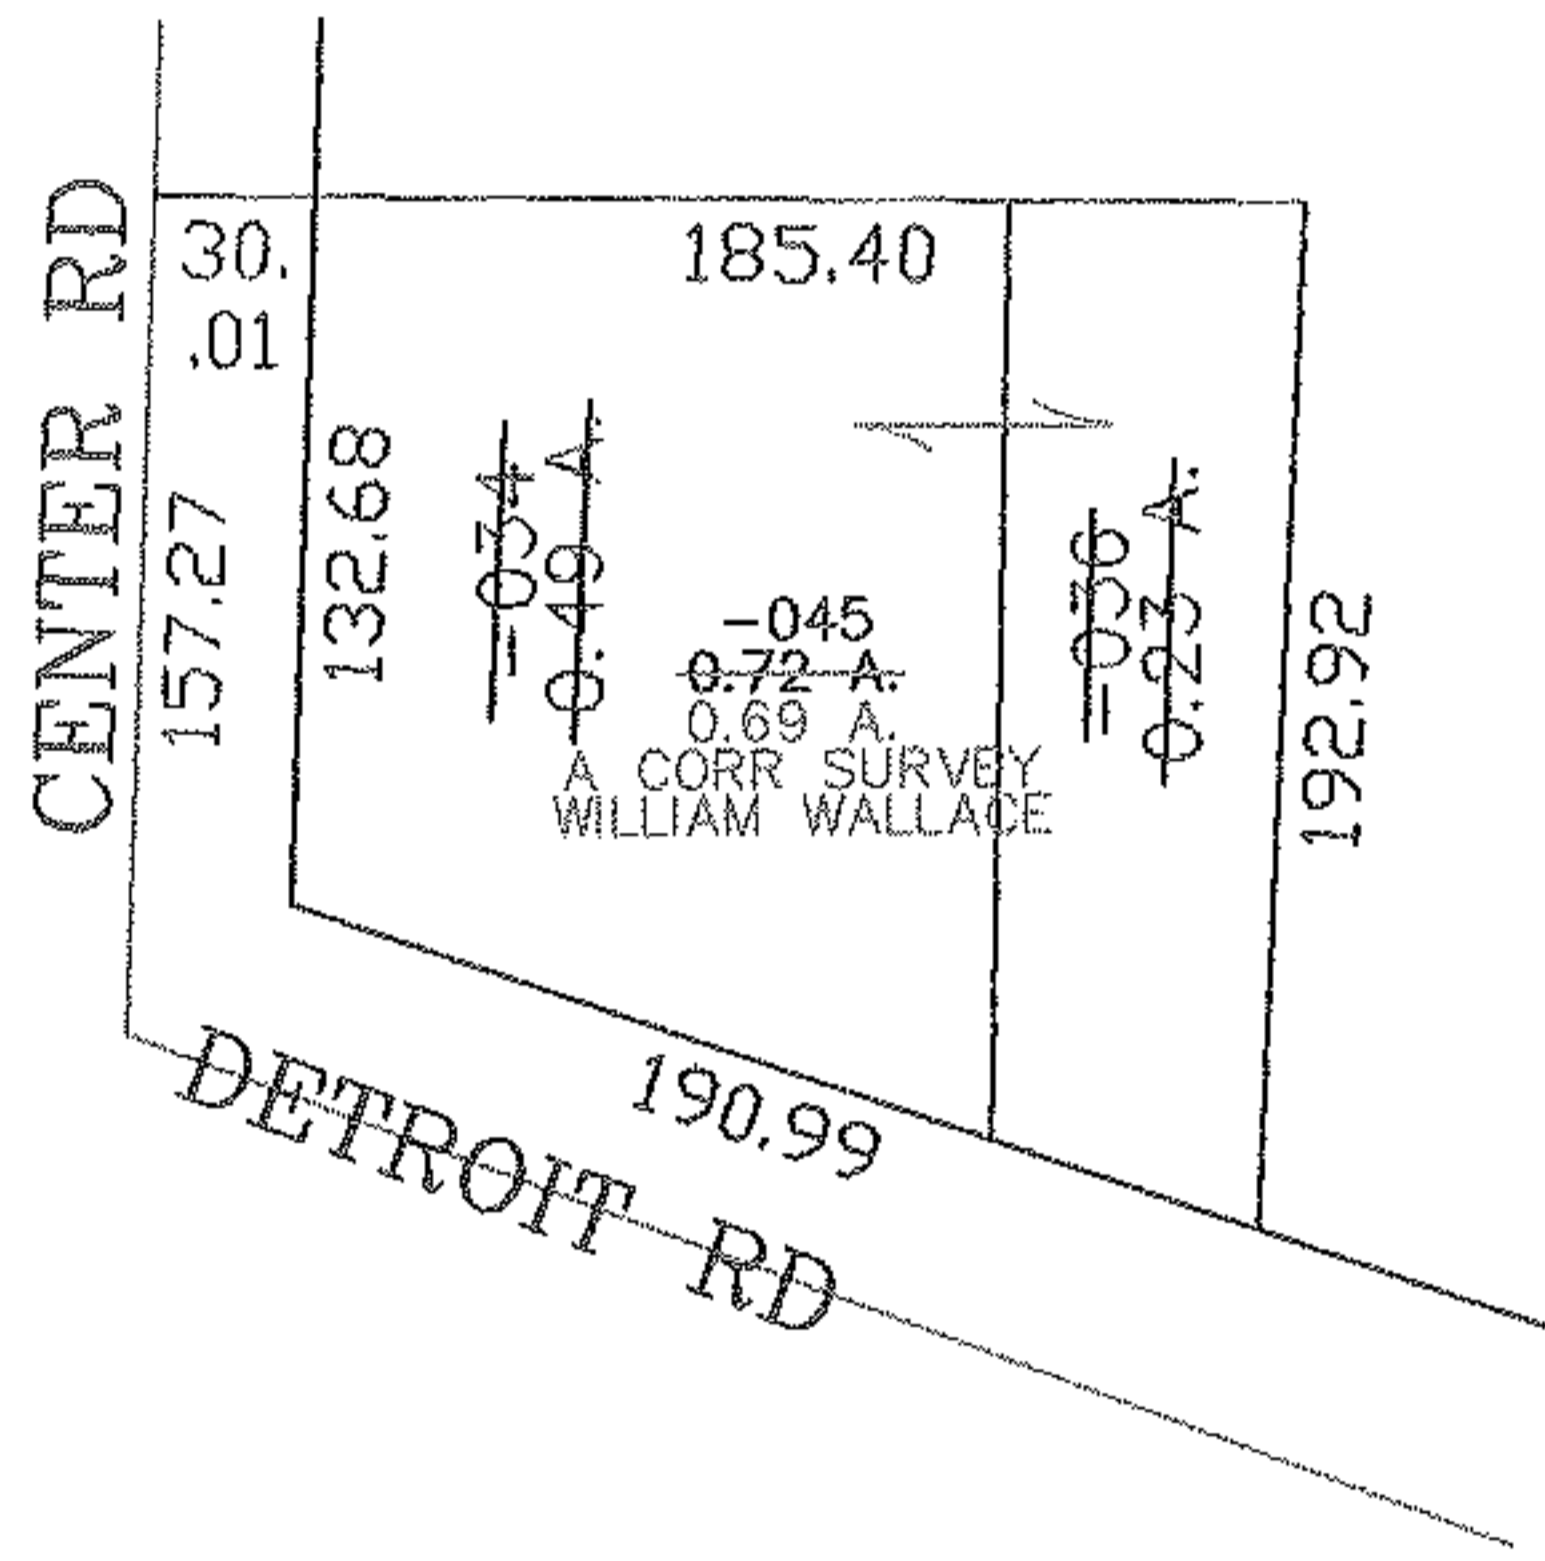


PARENT PARCEL: 04-00-015-102-034 &-036

08-02563

CHILD PARCEL: 04-00-015-102-045

STARTING POINT: CENTERLINE OF CENTER RD & DETROIT RD

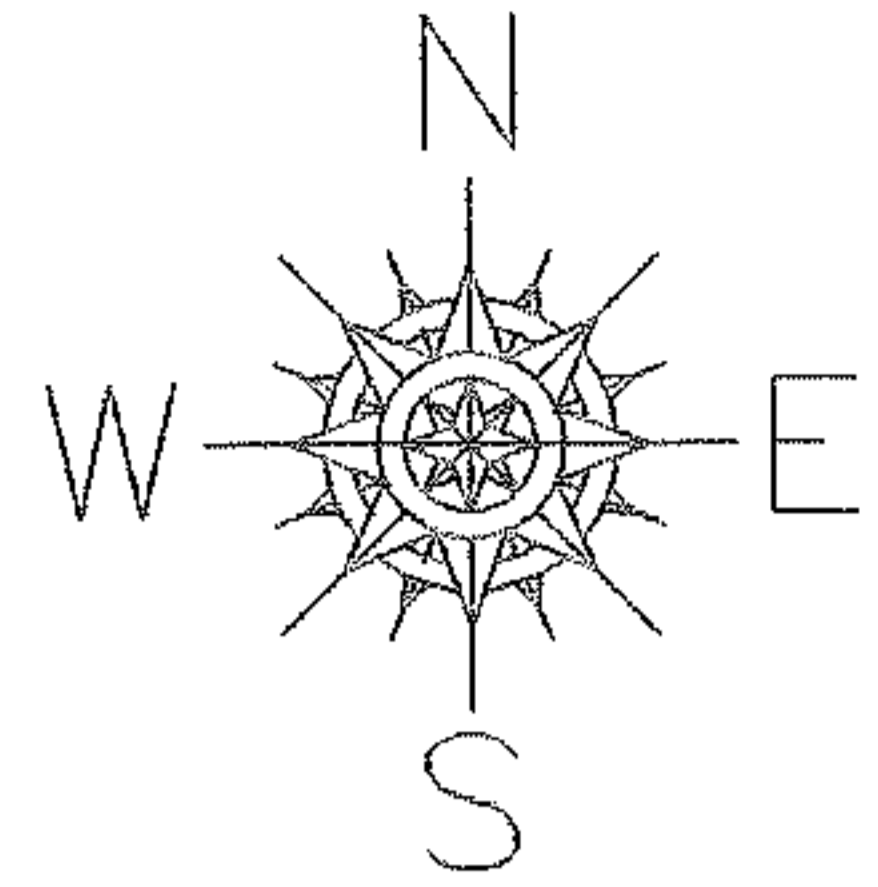

SPLITS/DEEDS PROCESSED

LORAIN COUNTY TAX MAP DEPARTMENT
226 MIDDLE AVE. ELYRIA, OHIO

SURVEYED BY: WILLIAM WALLACE

CLOSURE: 0.00 : 10.000

MAP PAGE(S): 04-00-015-C

APPROVED BY: JAH DATE: 5-1-08

SCALE: 1" = 100 PRIOR INSTRUMENT: 20050061531