
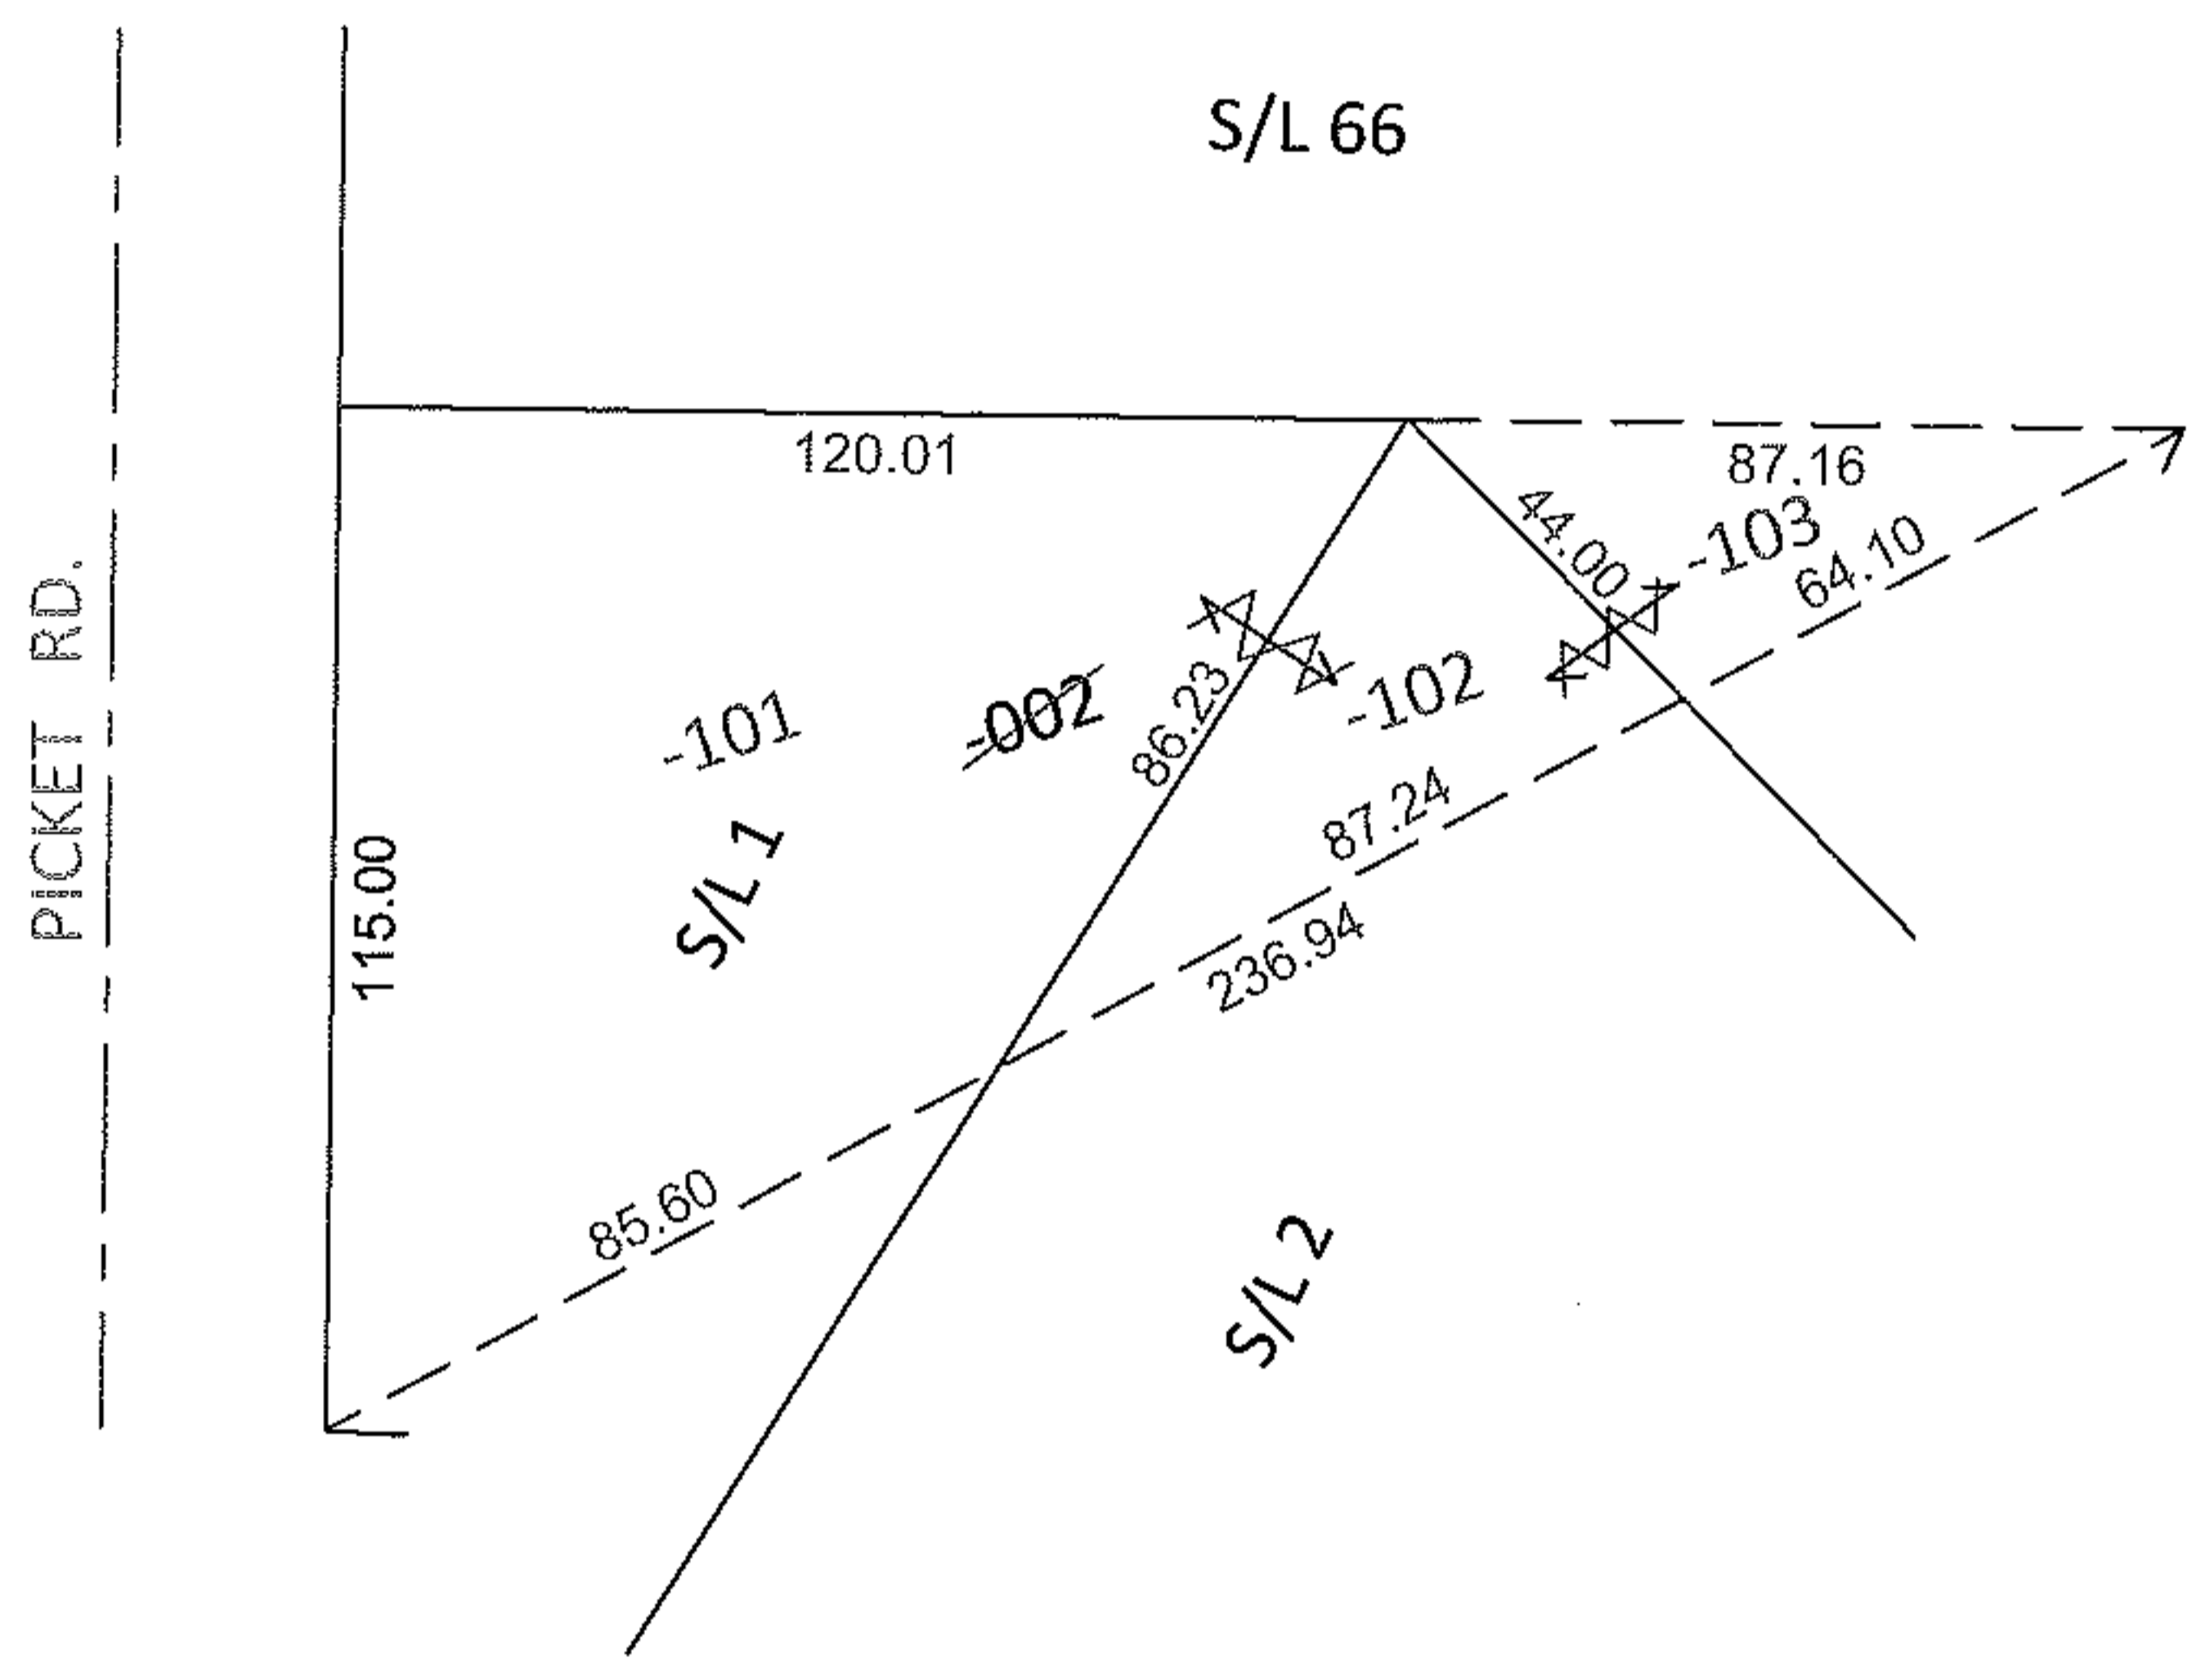


PARENT PARCEL: 02-02-012-104-002
 CHILD PARCEL: 02-02-012-104-101 THRU -103
 STARTING POINT: NORTHWEST CORNER OF S/L 1 IN KNEIRM DRIVE HOMES ALLOT.(VOL.14 PGS.26-27)

12-02565-D

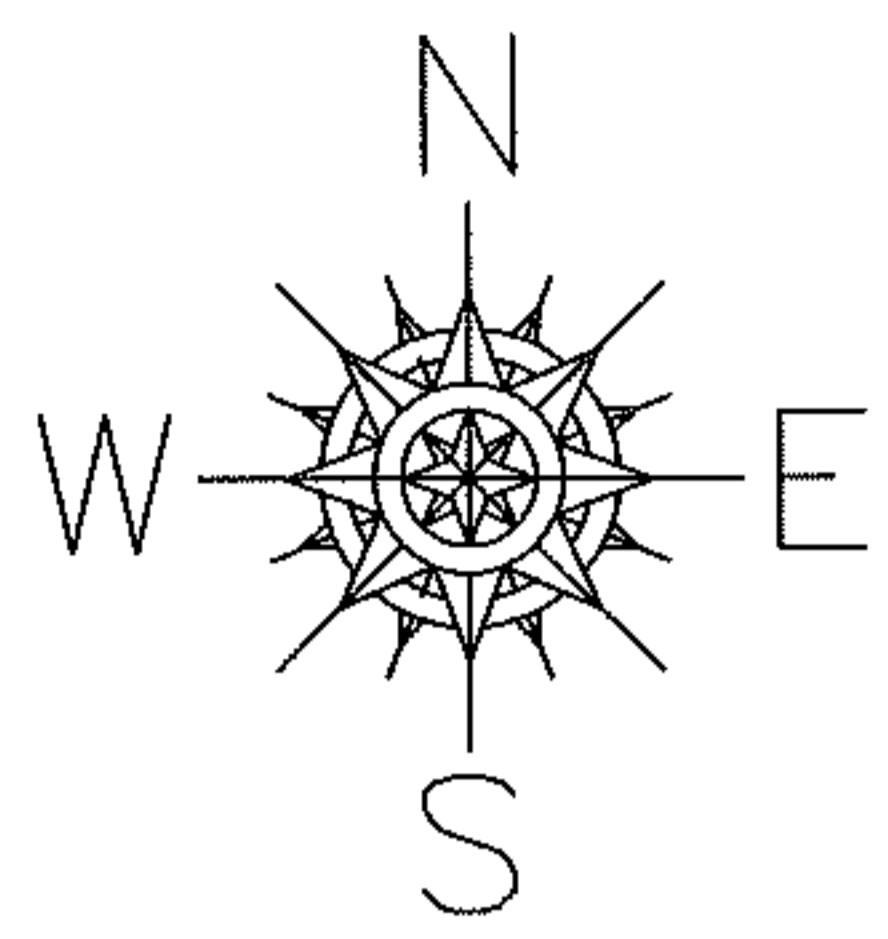


UNCOMBINATION

TO REMOVE COMBINATION OF SUBLOTS

~~02-02-012-104-002~~
~~115 X IRR~~

02-02-012-104-101 02-02-012-104-102 02-02-012-104-103
 115 X 120.01 TRI. 86.23 X 44 X 87.24 TRI. 44 X 87.16 X 64.10

PER SURV. P. MCGANNON

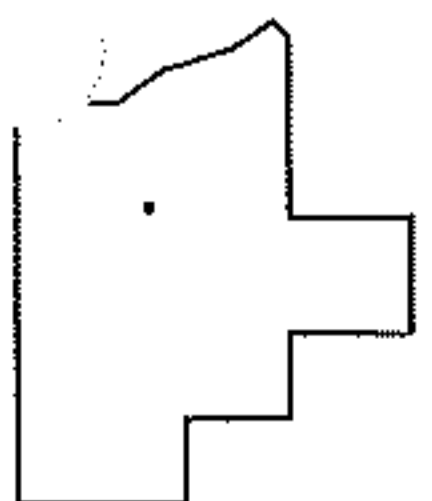

SPLITS/DEEDS PROCESSED

LORAIN COUNTY TAX MAP DEPARTMENT
 226 MIDDLE AVE. ELYRIA, OHIO

SURVEYED BY: PATRICK A. MCGANNON
 CLOSURE: .01:10,000
 MAP PAGE(S): 2-02-012-B
 APPROVED BY: RRM DATE: 8-29-12
 SCALE: 1"= 50' PRIOR INST.: 20050073387