




RASTER

PARENT PARCEL: 07-00-008-115-089

CHILD PARCEL: 07-00-008-115-090 THRU -092

STARTING POINT: CENTERLINE OF CENTER RIDGE RD & O.L. 8

08-02565

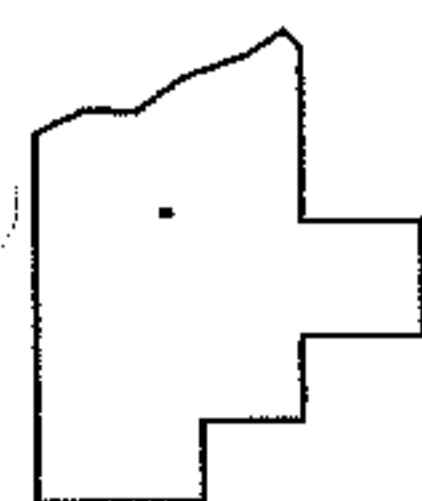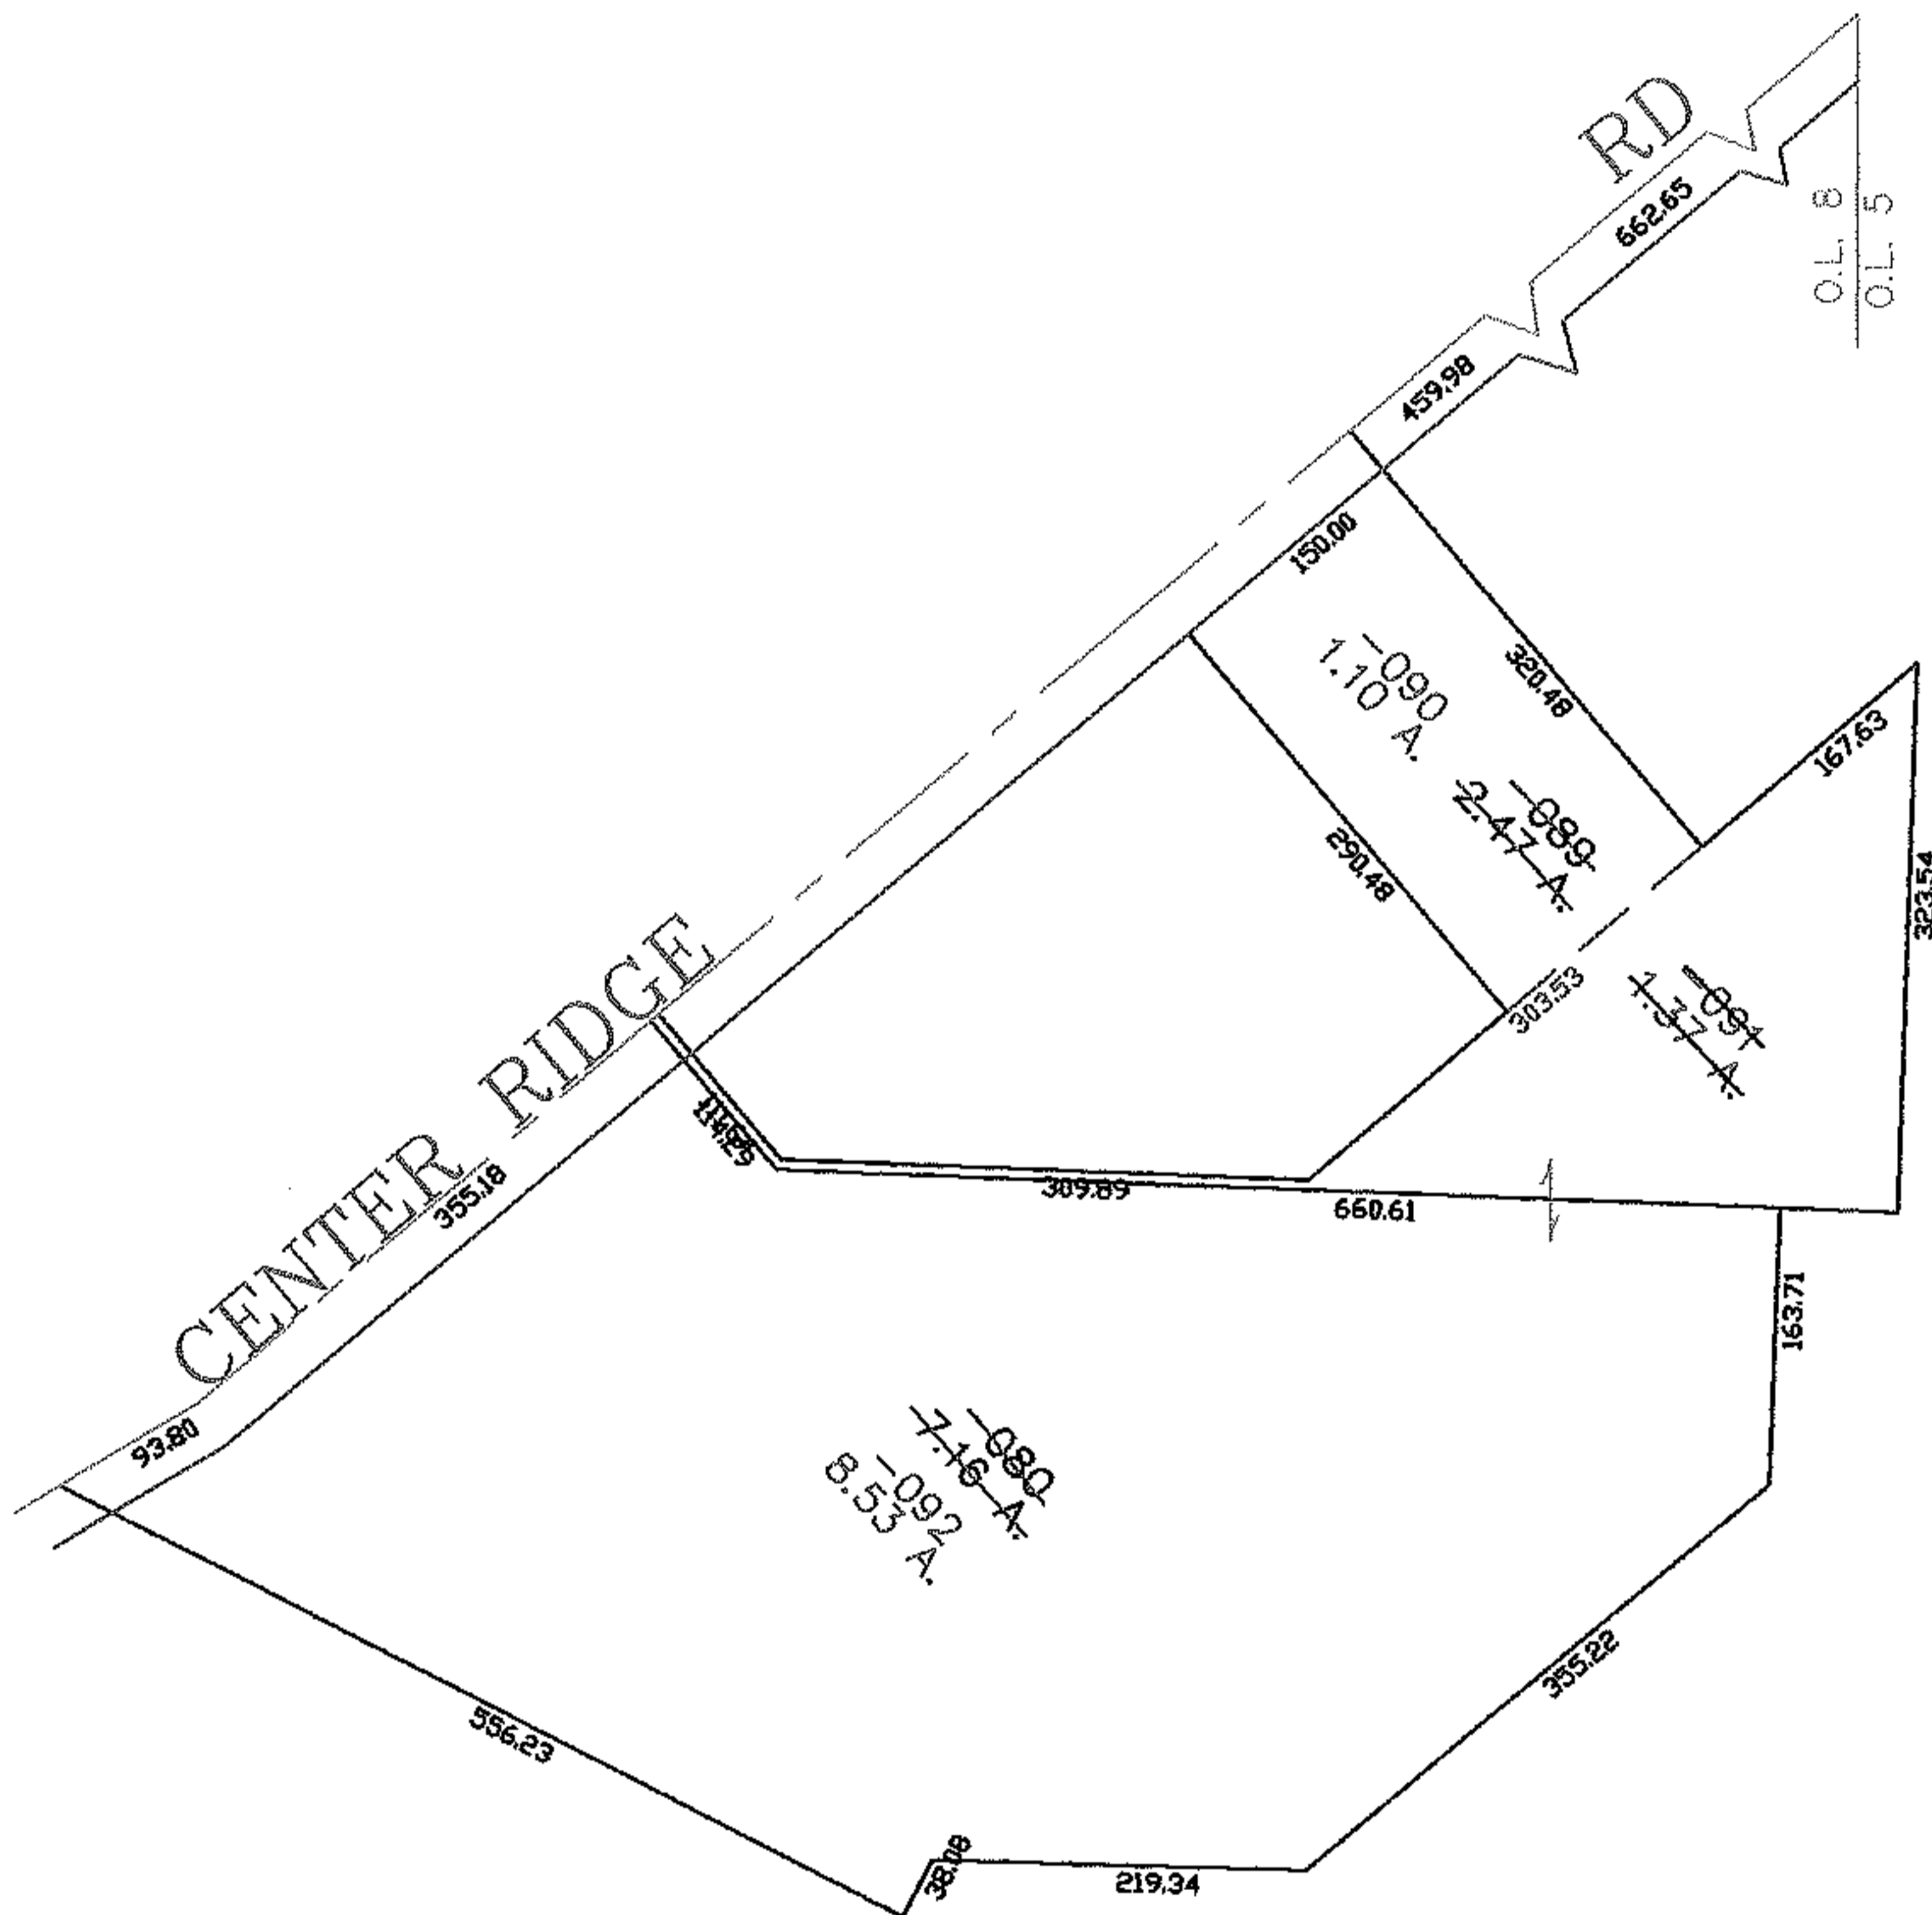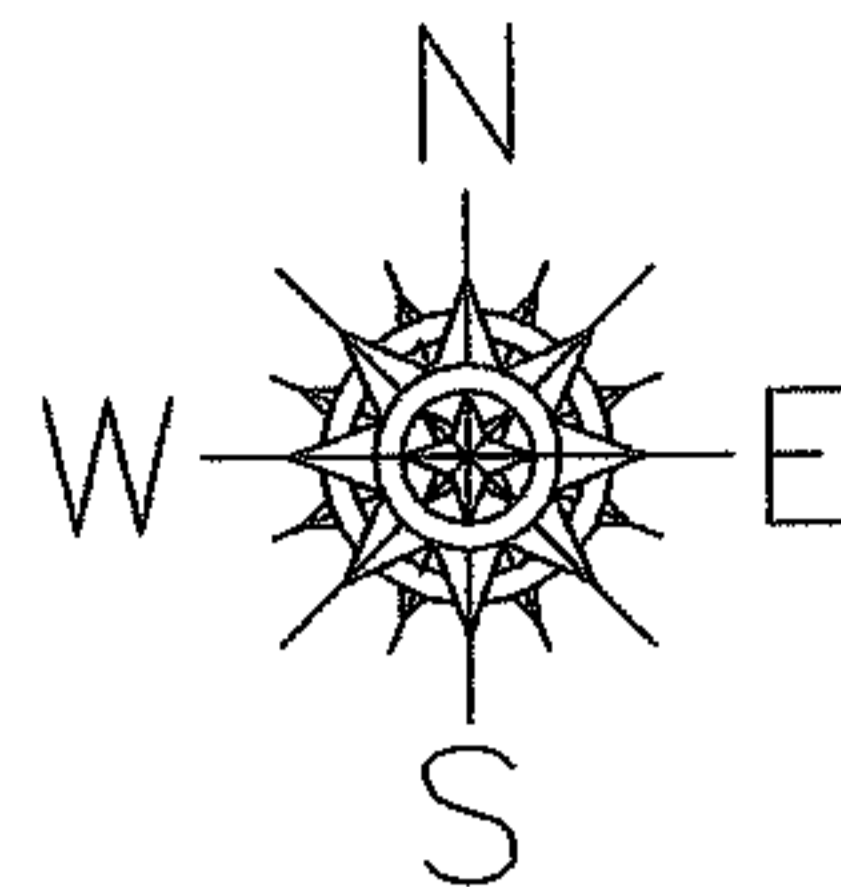

SPLITS/DEEDS PROCESSED
 LORAIN COUNTY TAX MAP DEPARTMENT
 226 MIDDLE AVE. ELYRIA, OHIO

SURVEYED BY: CHRISTOPHER HIRZEL
 CLOSURE: 0.00 : 10.000
 MAP PAGE(S): 07-00-008-D
 APPROVED BY: JAH DATE: 5-5-08
 SCALE: 1" = 200 PRIOR INSTRUMENT: 20080236865