
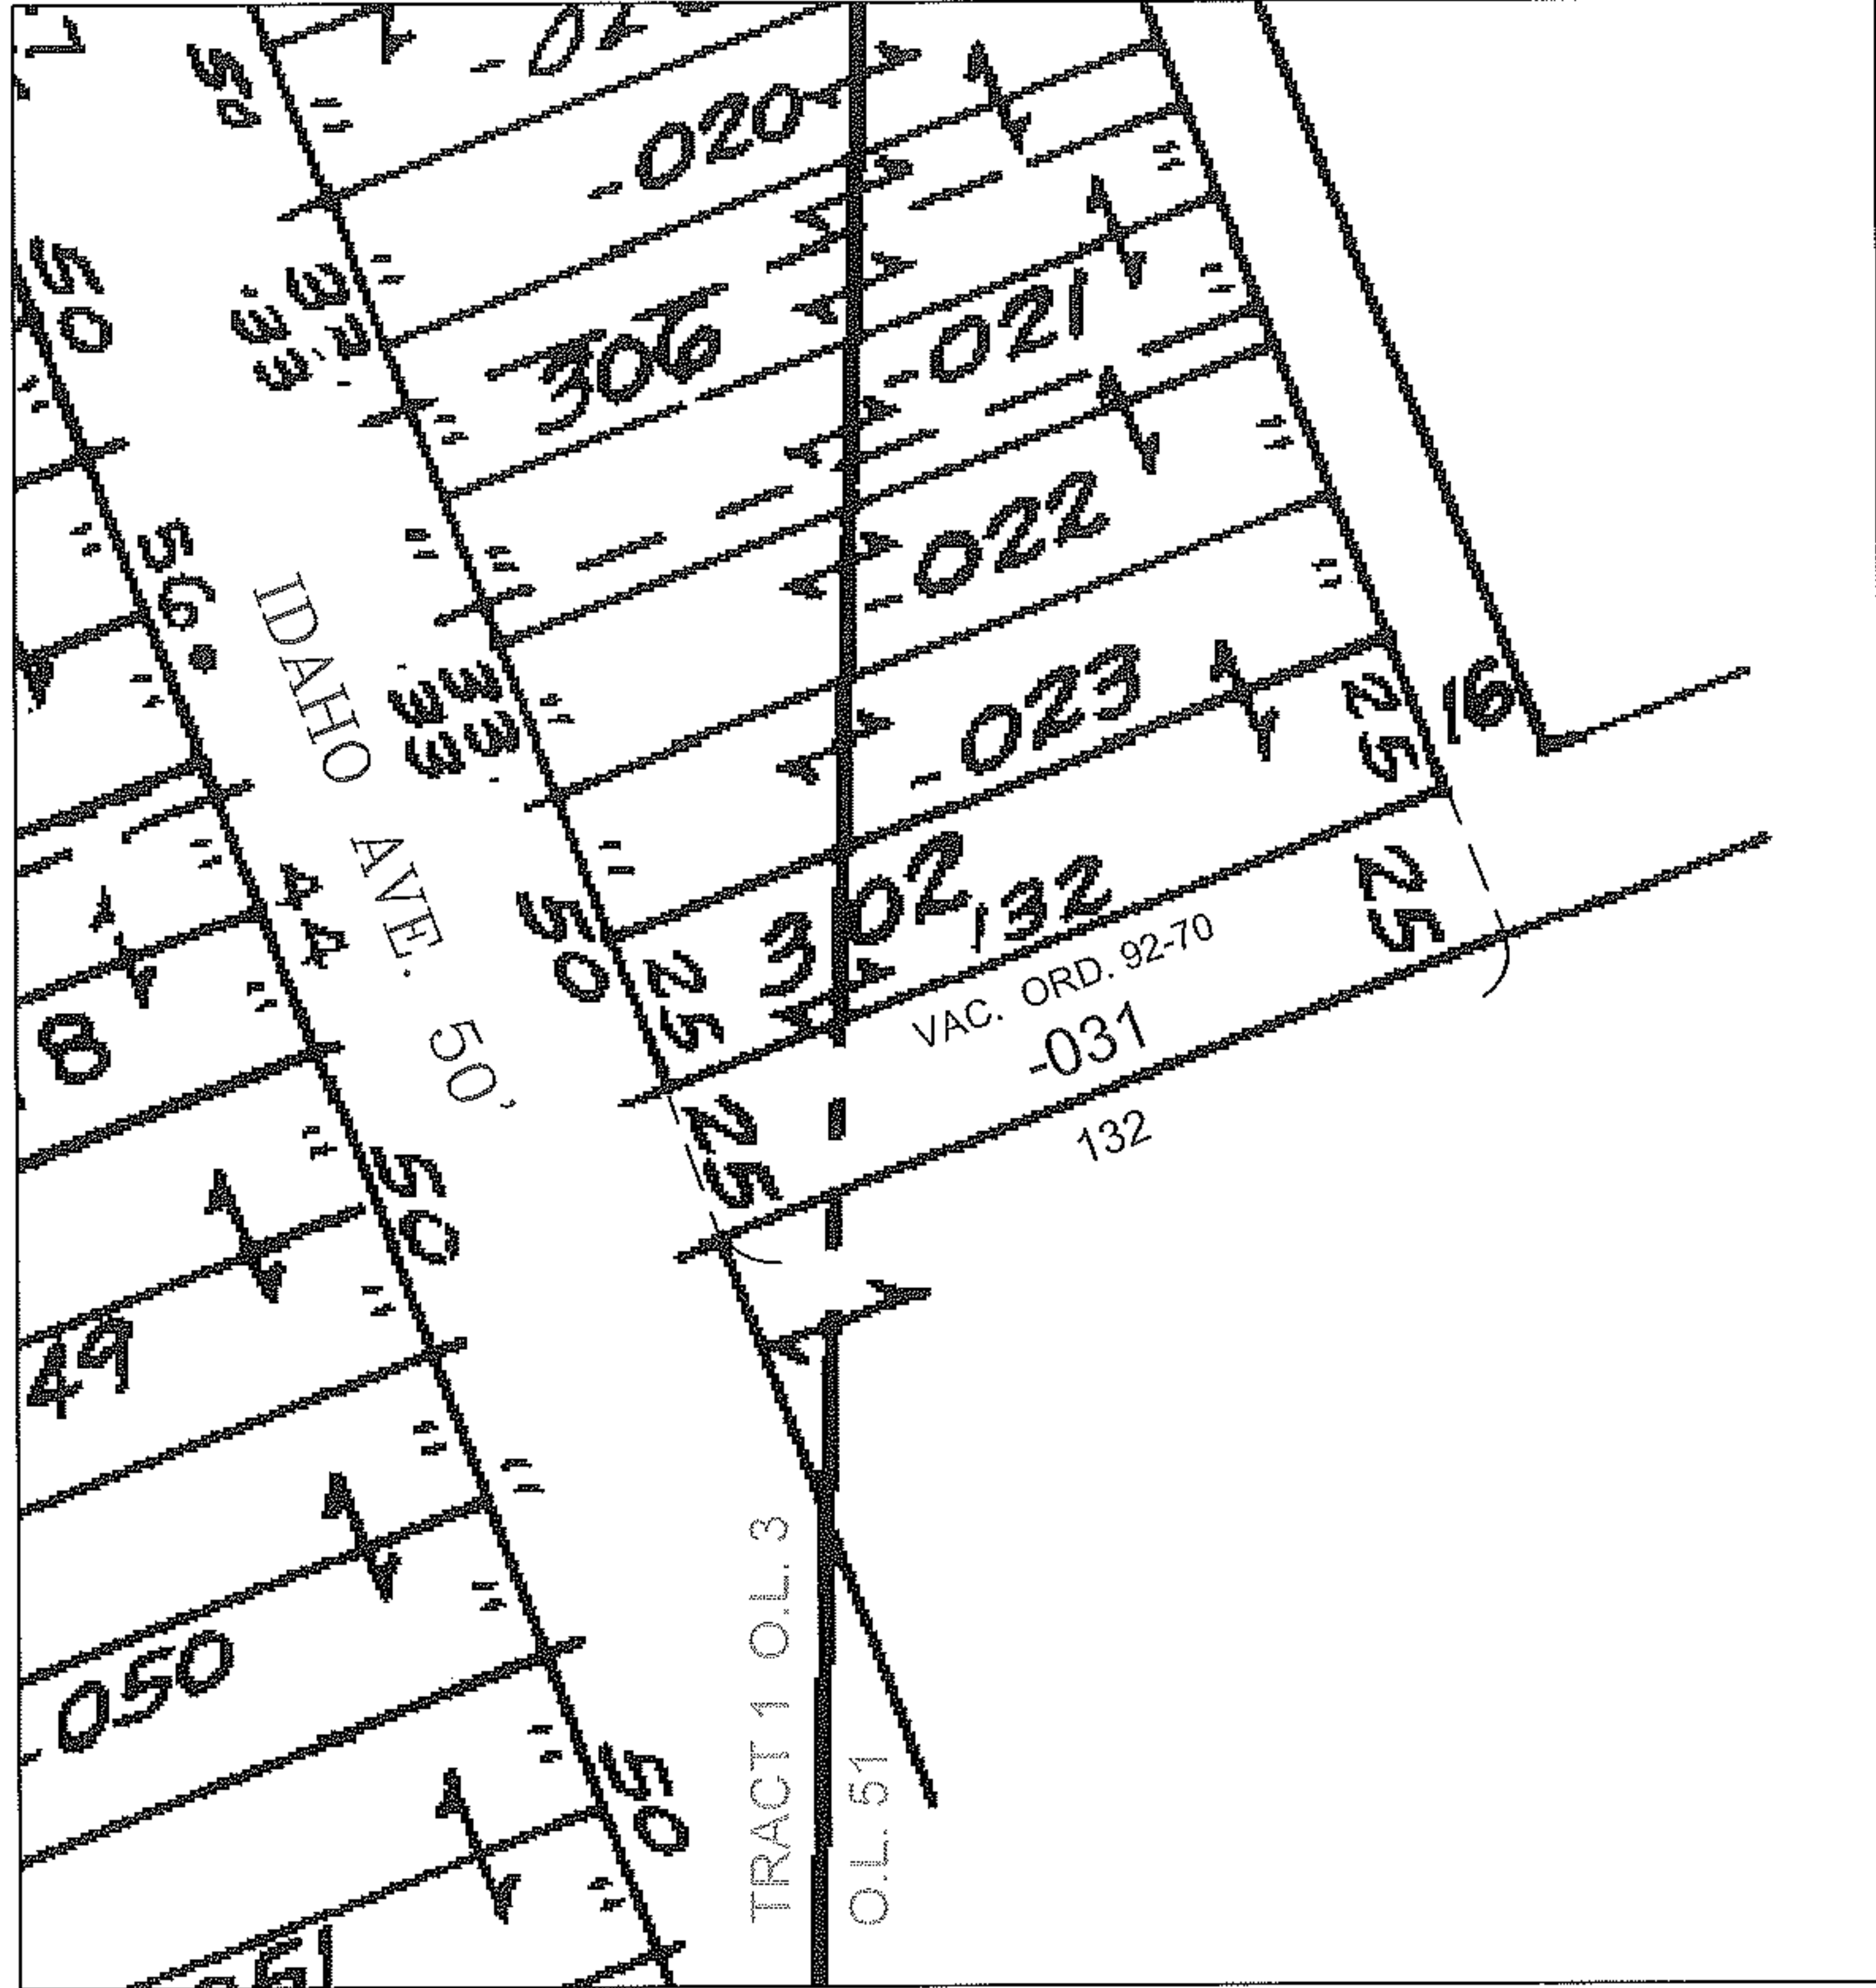


PARENT PARCEL: ALLEY VACATION  
CHILD PARCEL: 02-00-051-102-031  
STARTING POINT: XXXXXX

12-02566-V

ADD TO DUPLICATE  
02-00-051-102-031  
25 X 132  
PER VACATION ORD. 92-70

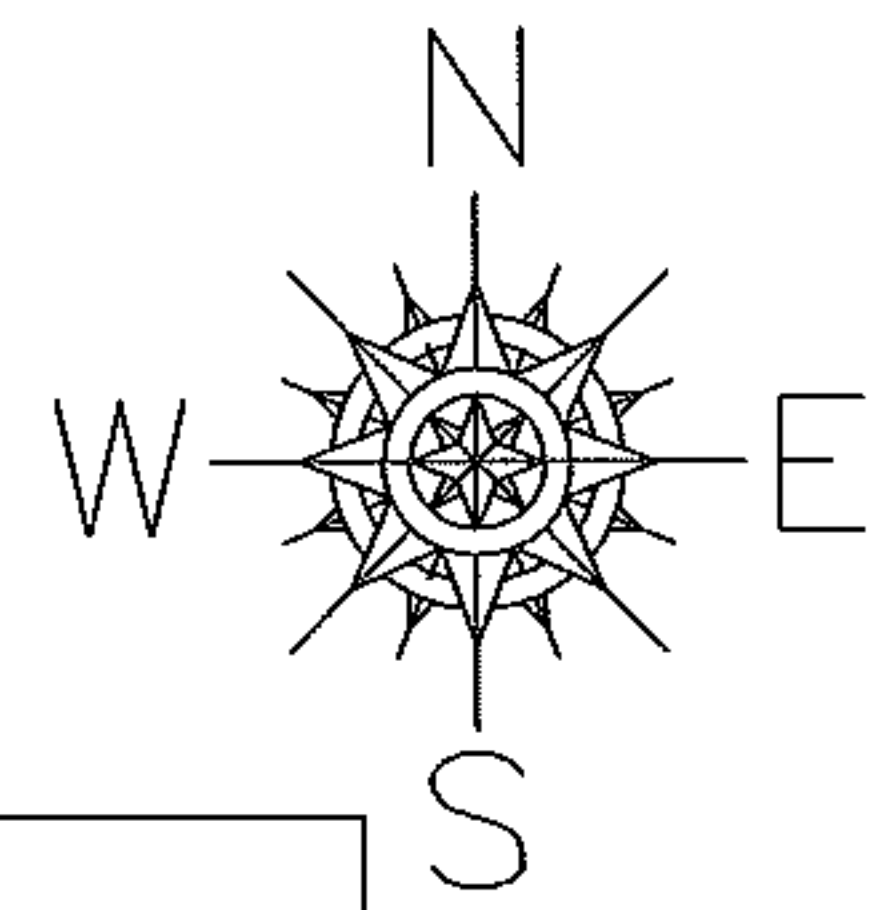

SPLITS/DEEDS PROCESSED

LORAIN COUNTY TAX MAP DEPARTMENT  
226 MIDDLE AVE. ELYRIA, OHIO

SURVEYED BY: NA  
CLOSURE: NA  
MAP PAGE(S): 02-01-003-B & 02-00-051-A  
APPROVED BY: TJS DATE: 8/28/12  
SCALE: 1"= 50' PRIOR INST.: DV XXXX/XXX