
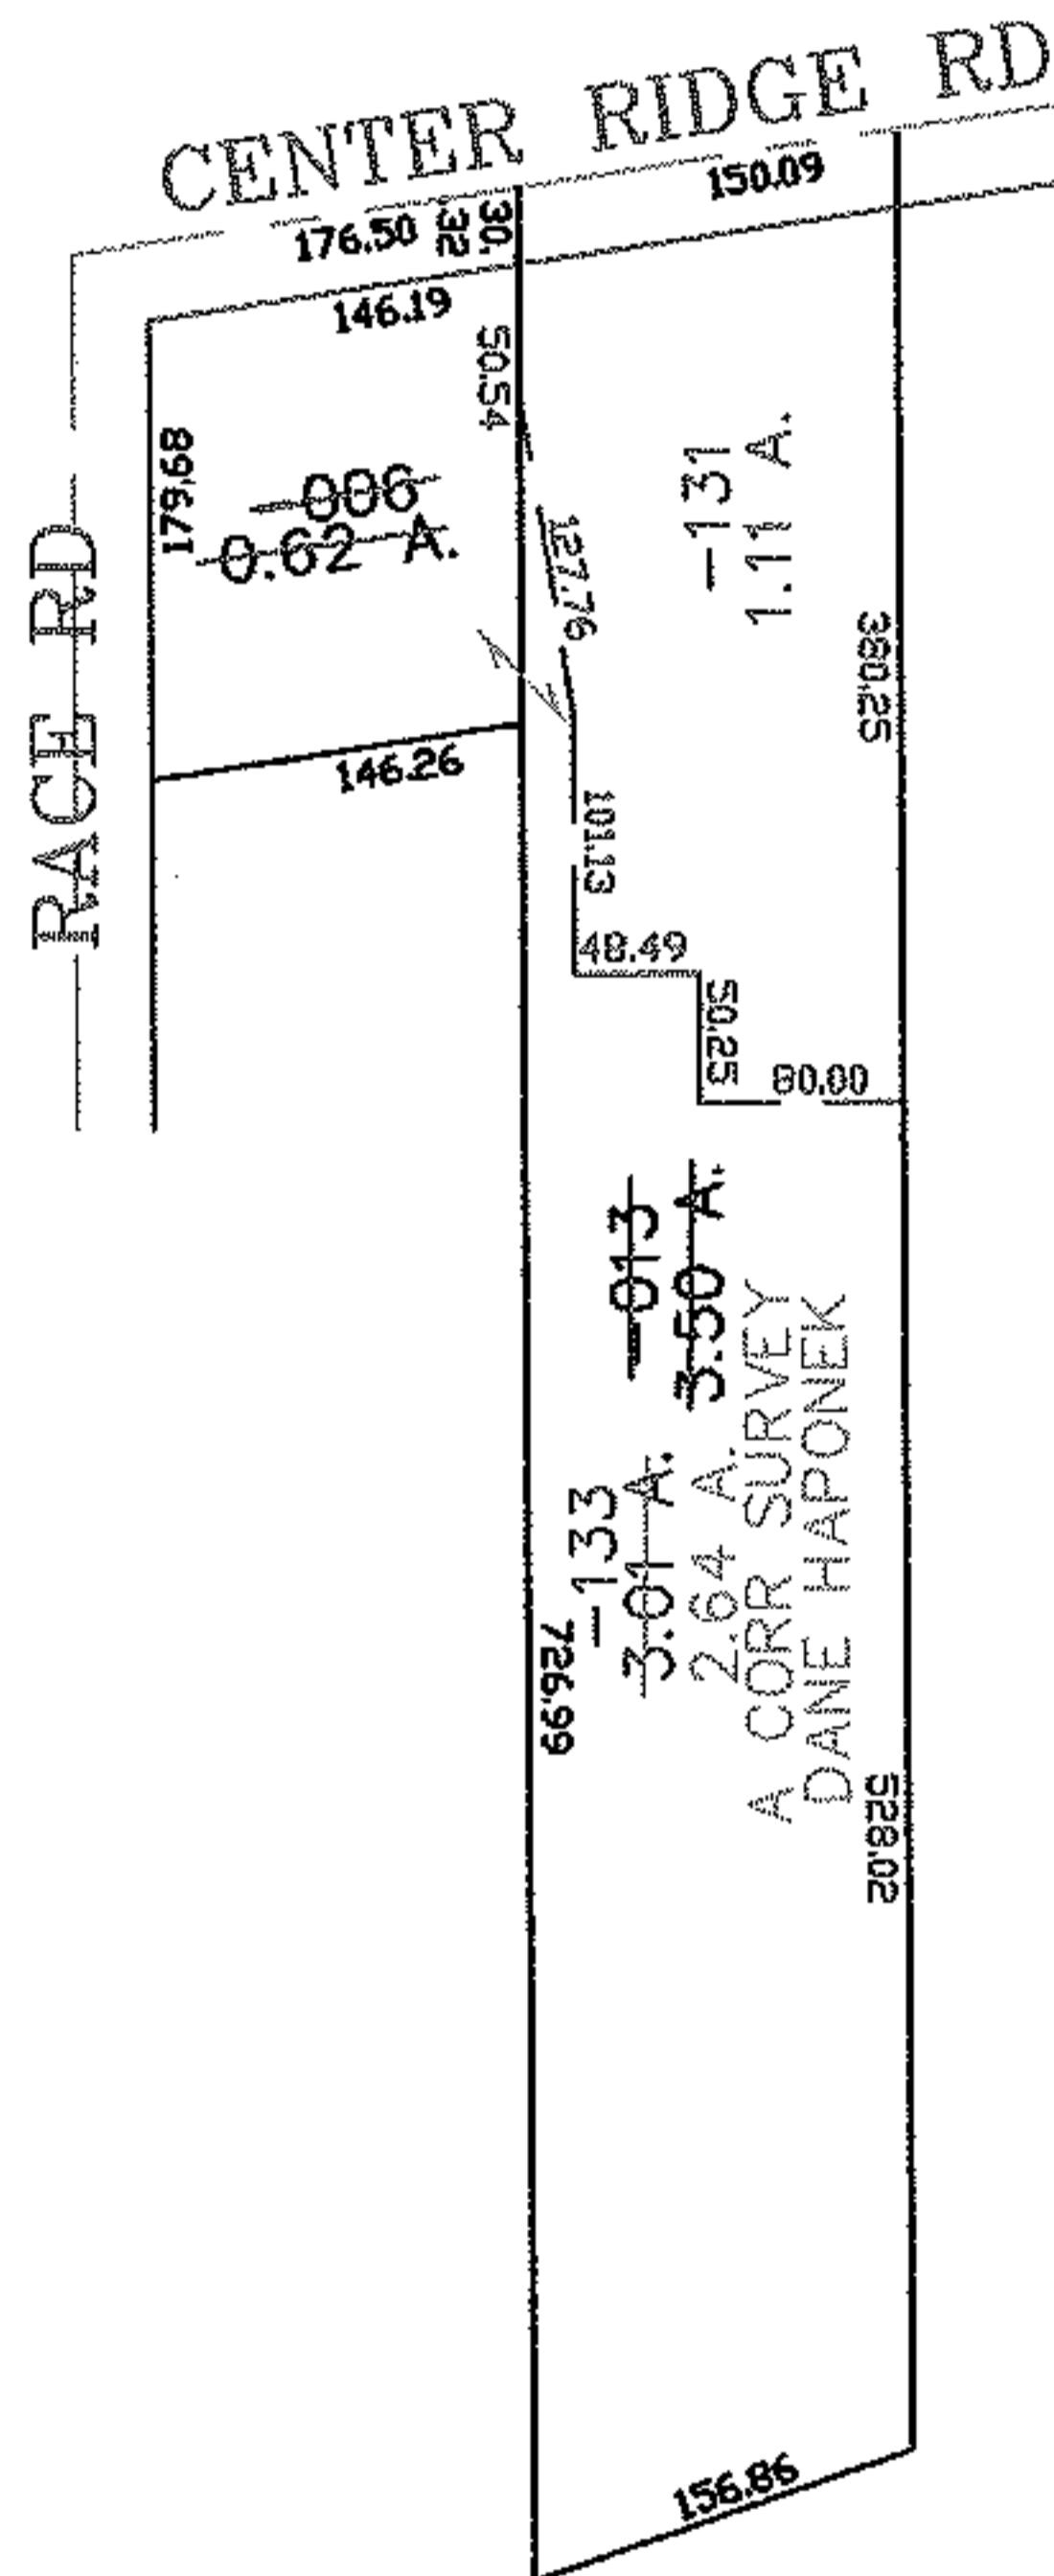


PARENT PARCEL: 07-00-034-000-013

CHILD PARCEL: 07-00-034-000-131 THRU -133

STARTING POINT: CENTERLINE OF CENTER RIDGE RD & RACE RD

08-02566

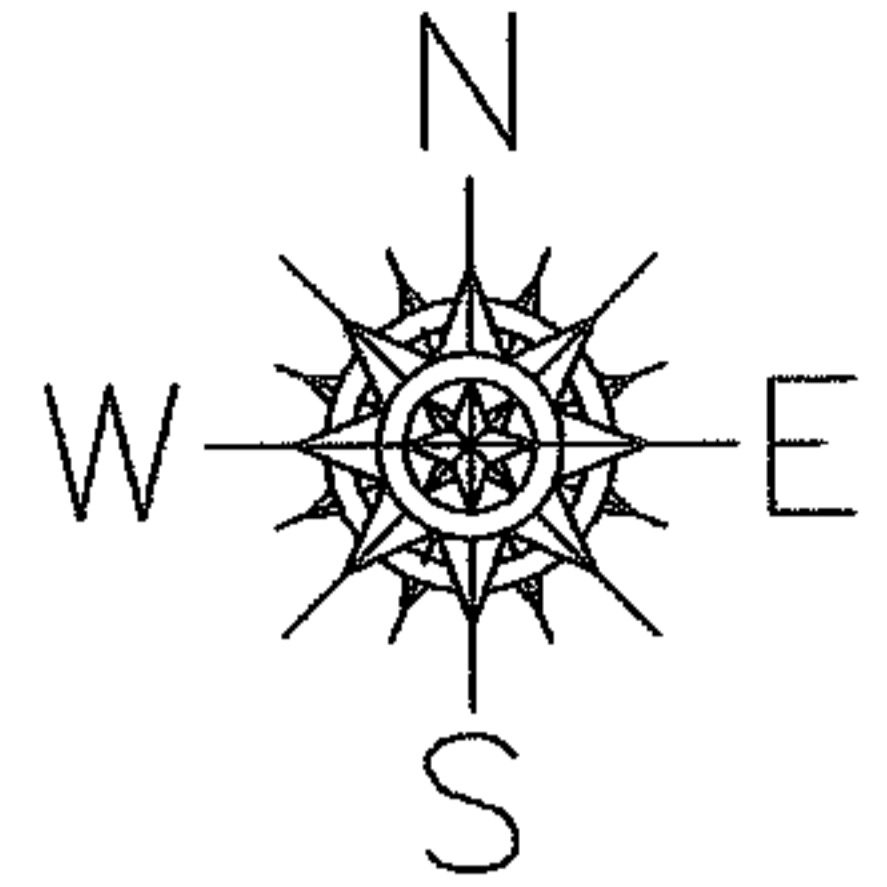

SPLITS/DEEDS PROCESSED

LORAIN COUNTY TAX MAP DEPARTMENT
226 MIDDLE AVE. ELYRIA, OHIO

SURVEYED BY: DANE HAPONEK

CLOSURE: 0.00 : 10.000

MAP PAGE(S): 07-00-034-A

APPROVED BY: JAH DATE: 5-6-08

SCALE: 1" = 200 PRIOR INSTRUMENT: DV 1415/845