
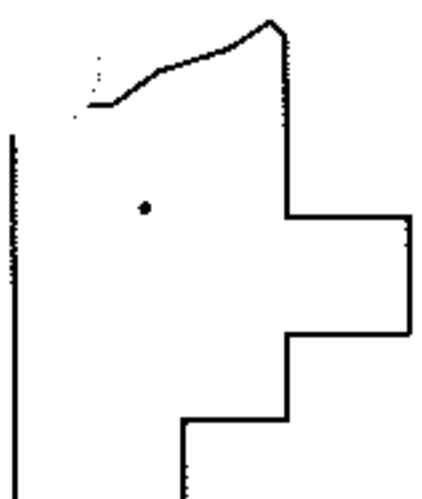
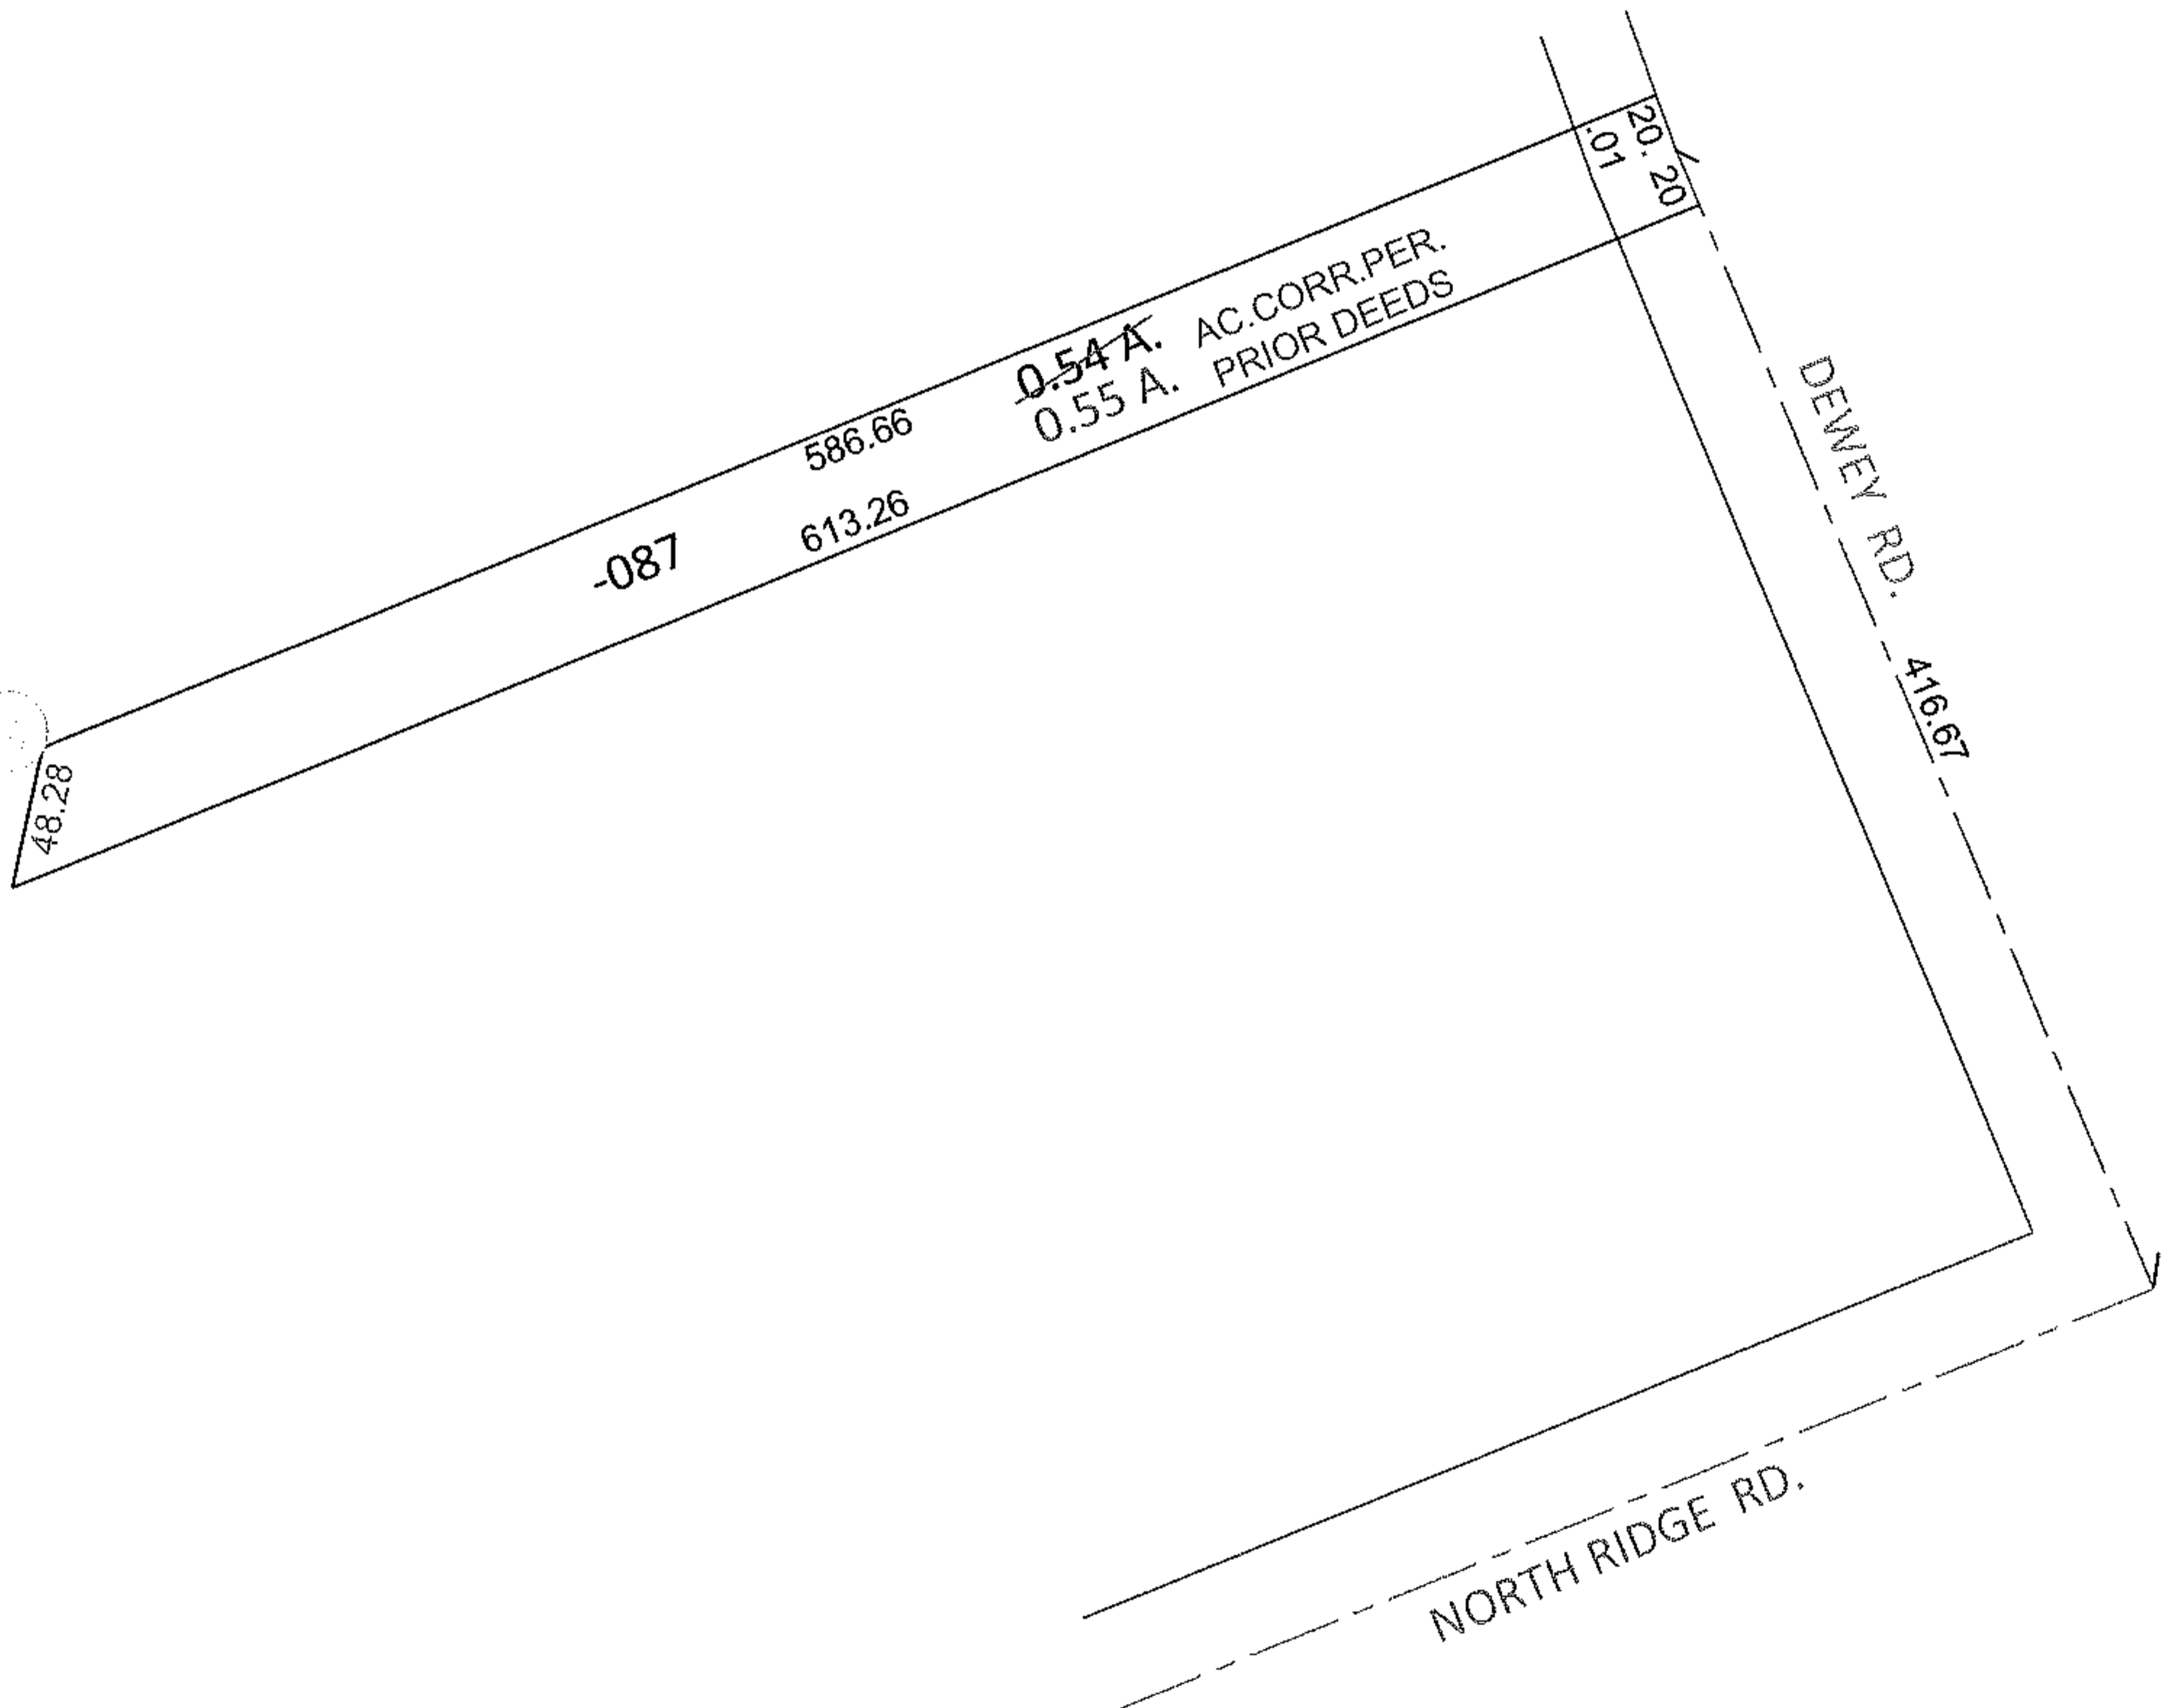


PARENT PARCEL: 05-00-042-104-087

CHILD PARCEL: _____

STARTING POINT: INTERSECTION OF C/L OF DEWEY RD. AND C/L OF NORTH RIDGE RD.

12-02567-A

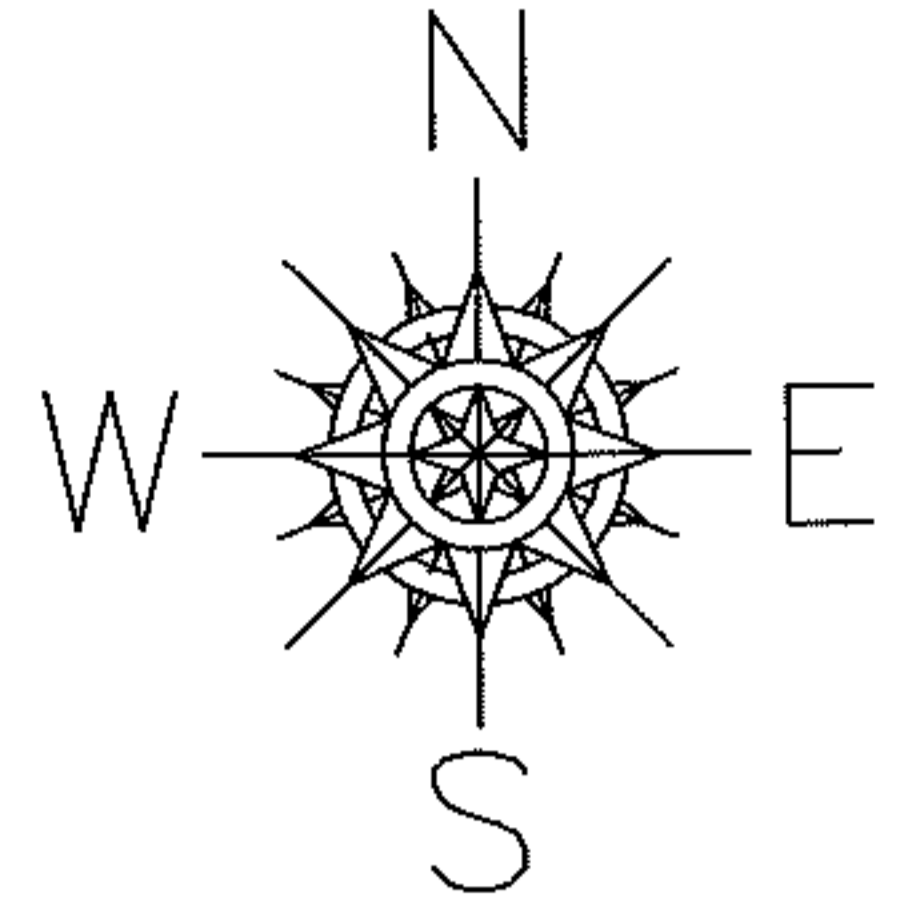

SPLITS/DEEDS PROCESSED

LORAIN COUNTY TAX MAP DEPARTMENT
226 MIDDLE AVE. ELYRIA, OHIO

SURVEYED BY: N/A

CLOSURE: .01:10,000

MAP PAGE(S): 5-00-042-A

APPROVED BY: RRM DATE: 8-30-12

SCALE: 1" = 100 PRIOR INST.: 20120420996