
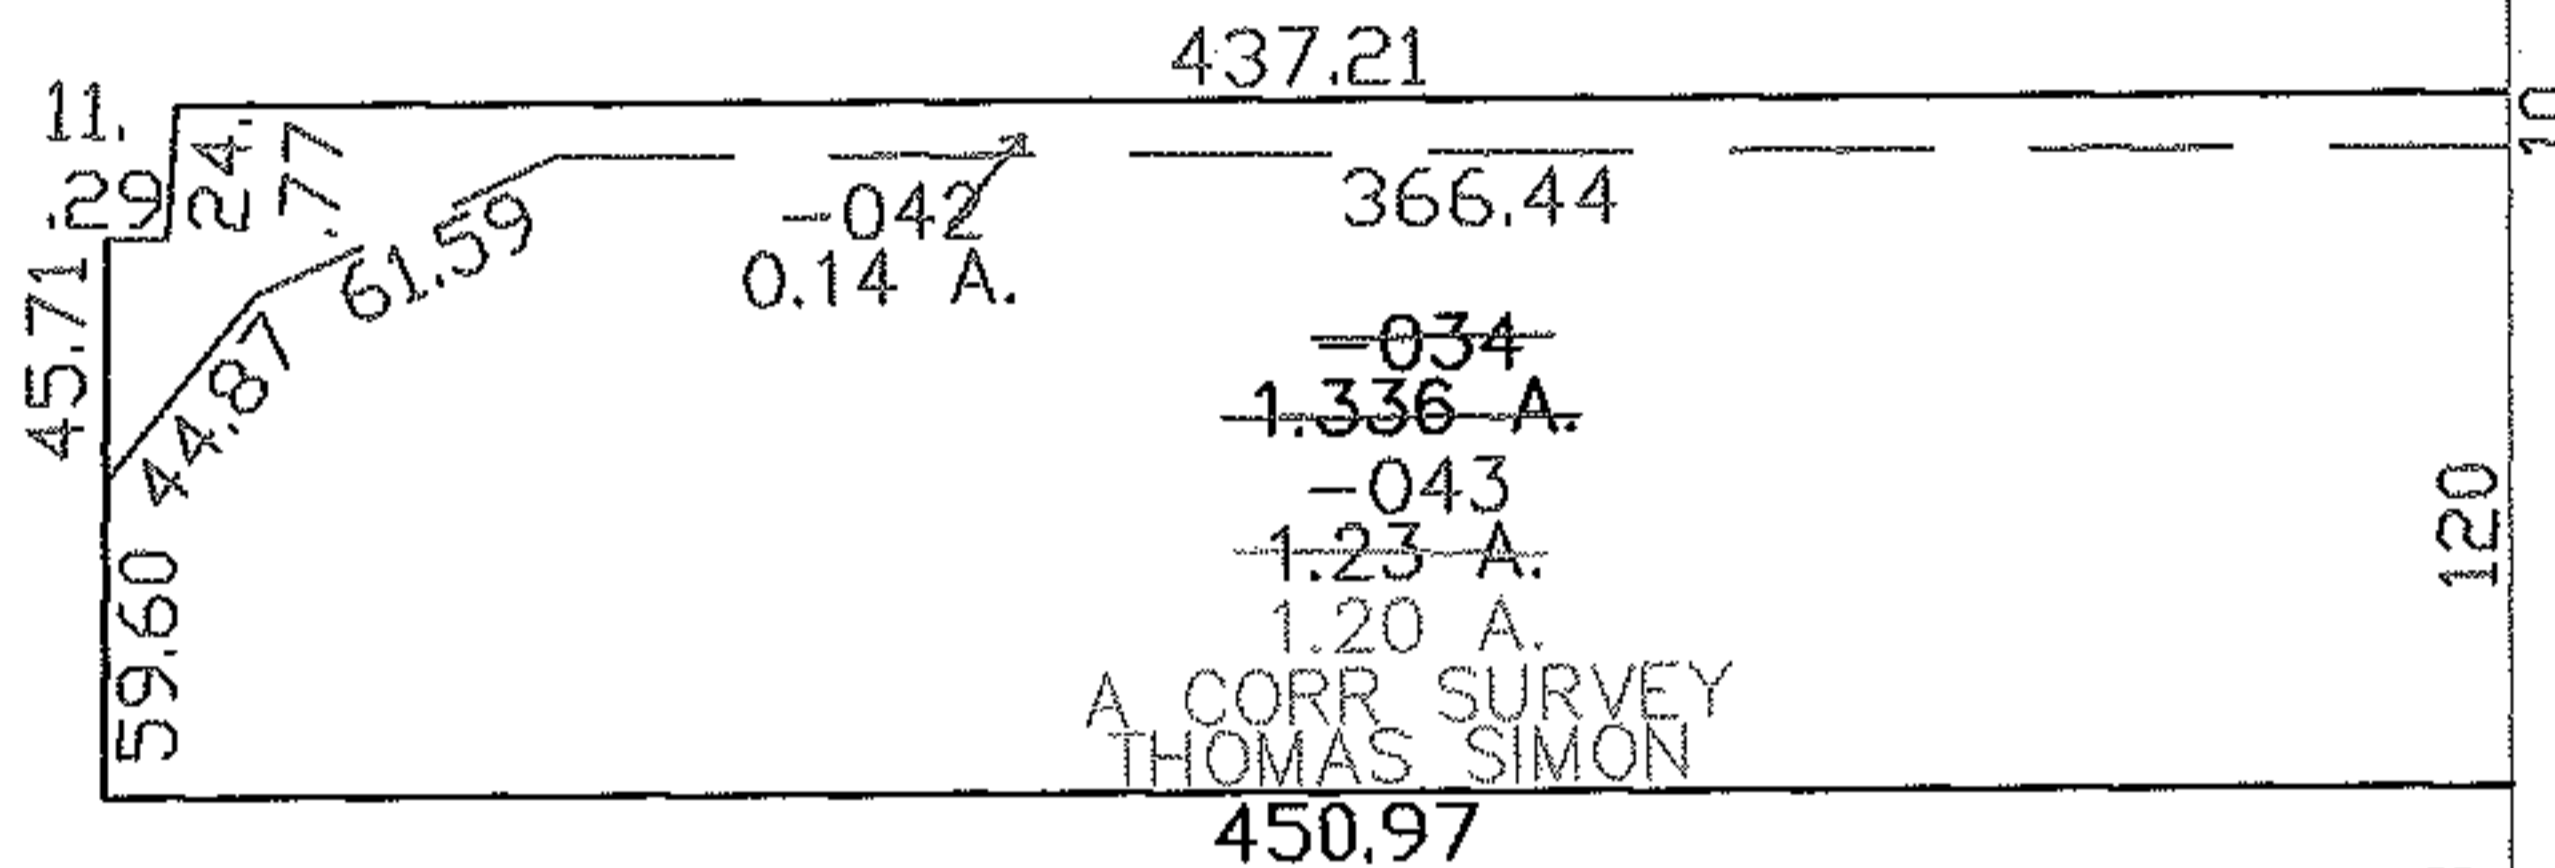


PARENT PARCEL: 05-00-055-000-034


CHILD PARCEL: 05-00-055-000-042, -043

STARTING POINT: SOUTHEASTERLY CORNER OF O.L. 55

08-02570

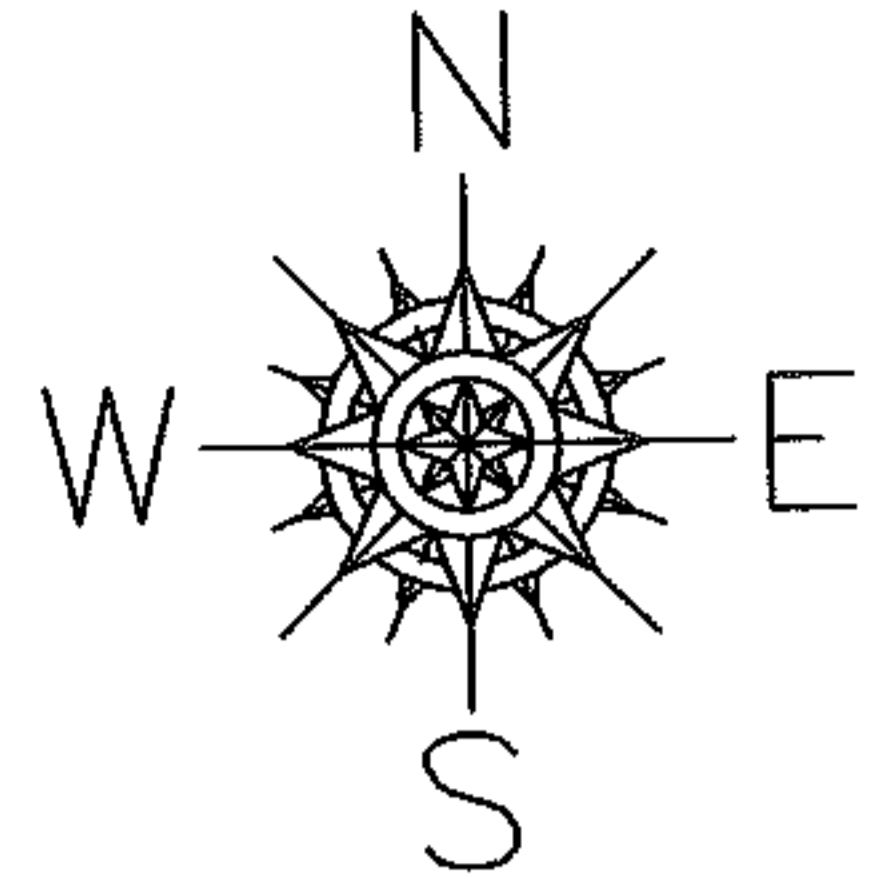

O.L. 55	O.L. 66
O.L. 54	O.L. 67

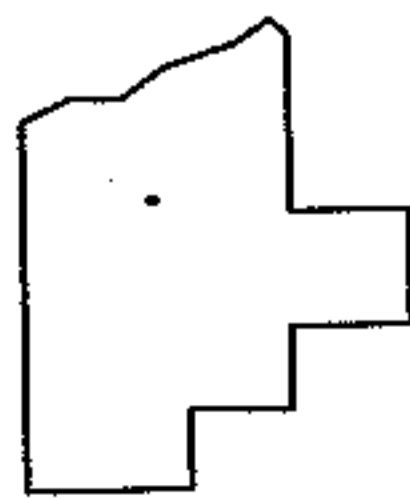

SPLITS/DEEDS PROCESSED

LORAIN COUNTY TAX MAP DEPARTMENT
226 MIDDLE AVE. ELYRIA, OHIO

SURVEYED BY: THOMAS SIMON
 CLOSURE: 0.00 : 10.000
 MAP PAGE(S): 05-00-055-B
 APPROVED BY: JAH DATE: 5-16-08
 SCALE: 1" = 100 PRIOR INSTRUMENT: 20050108573