
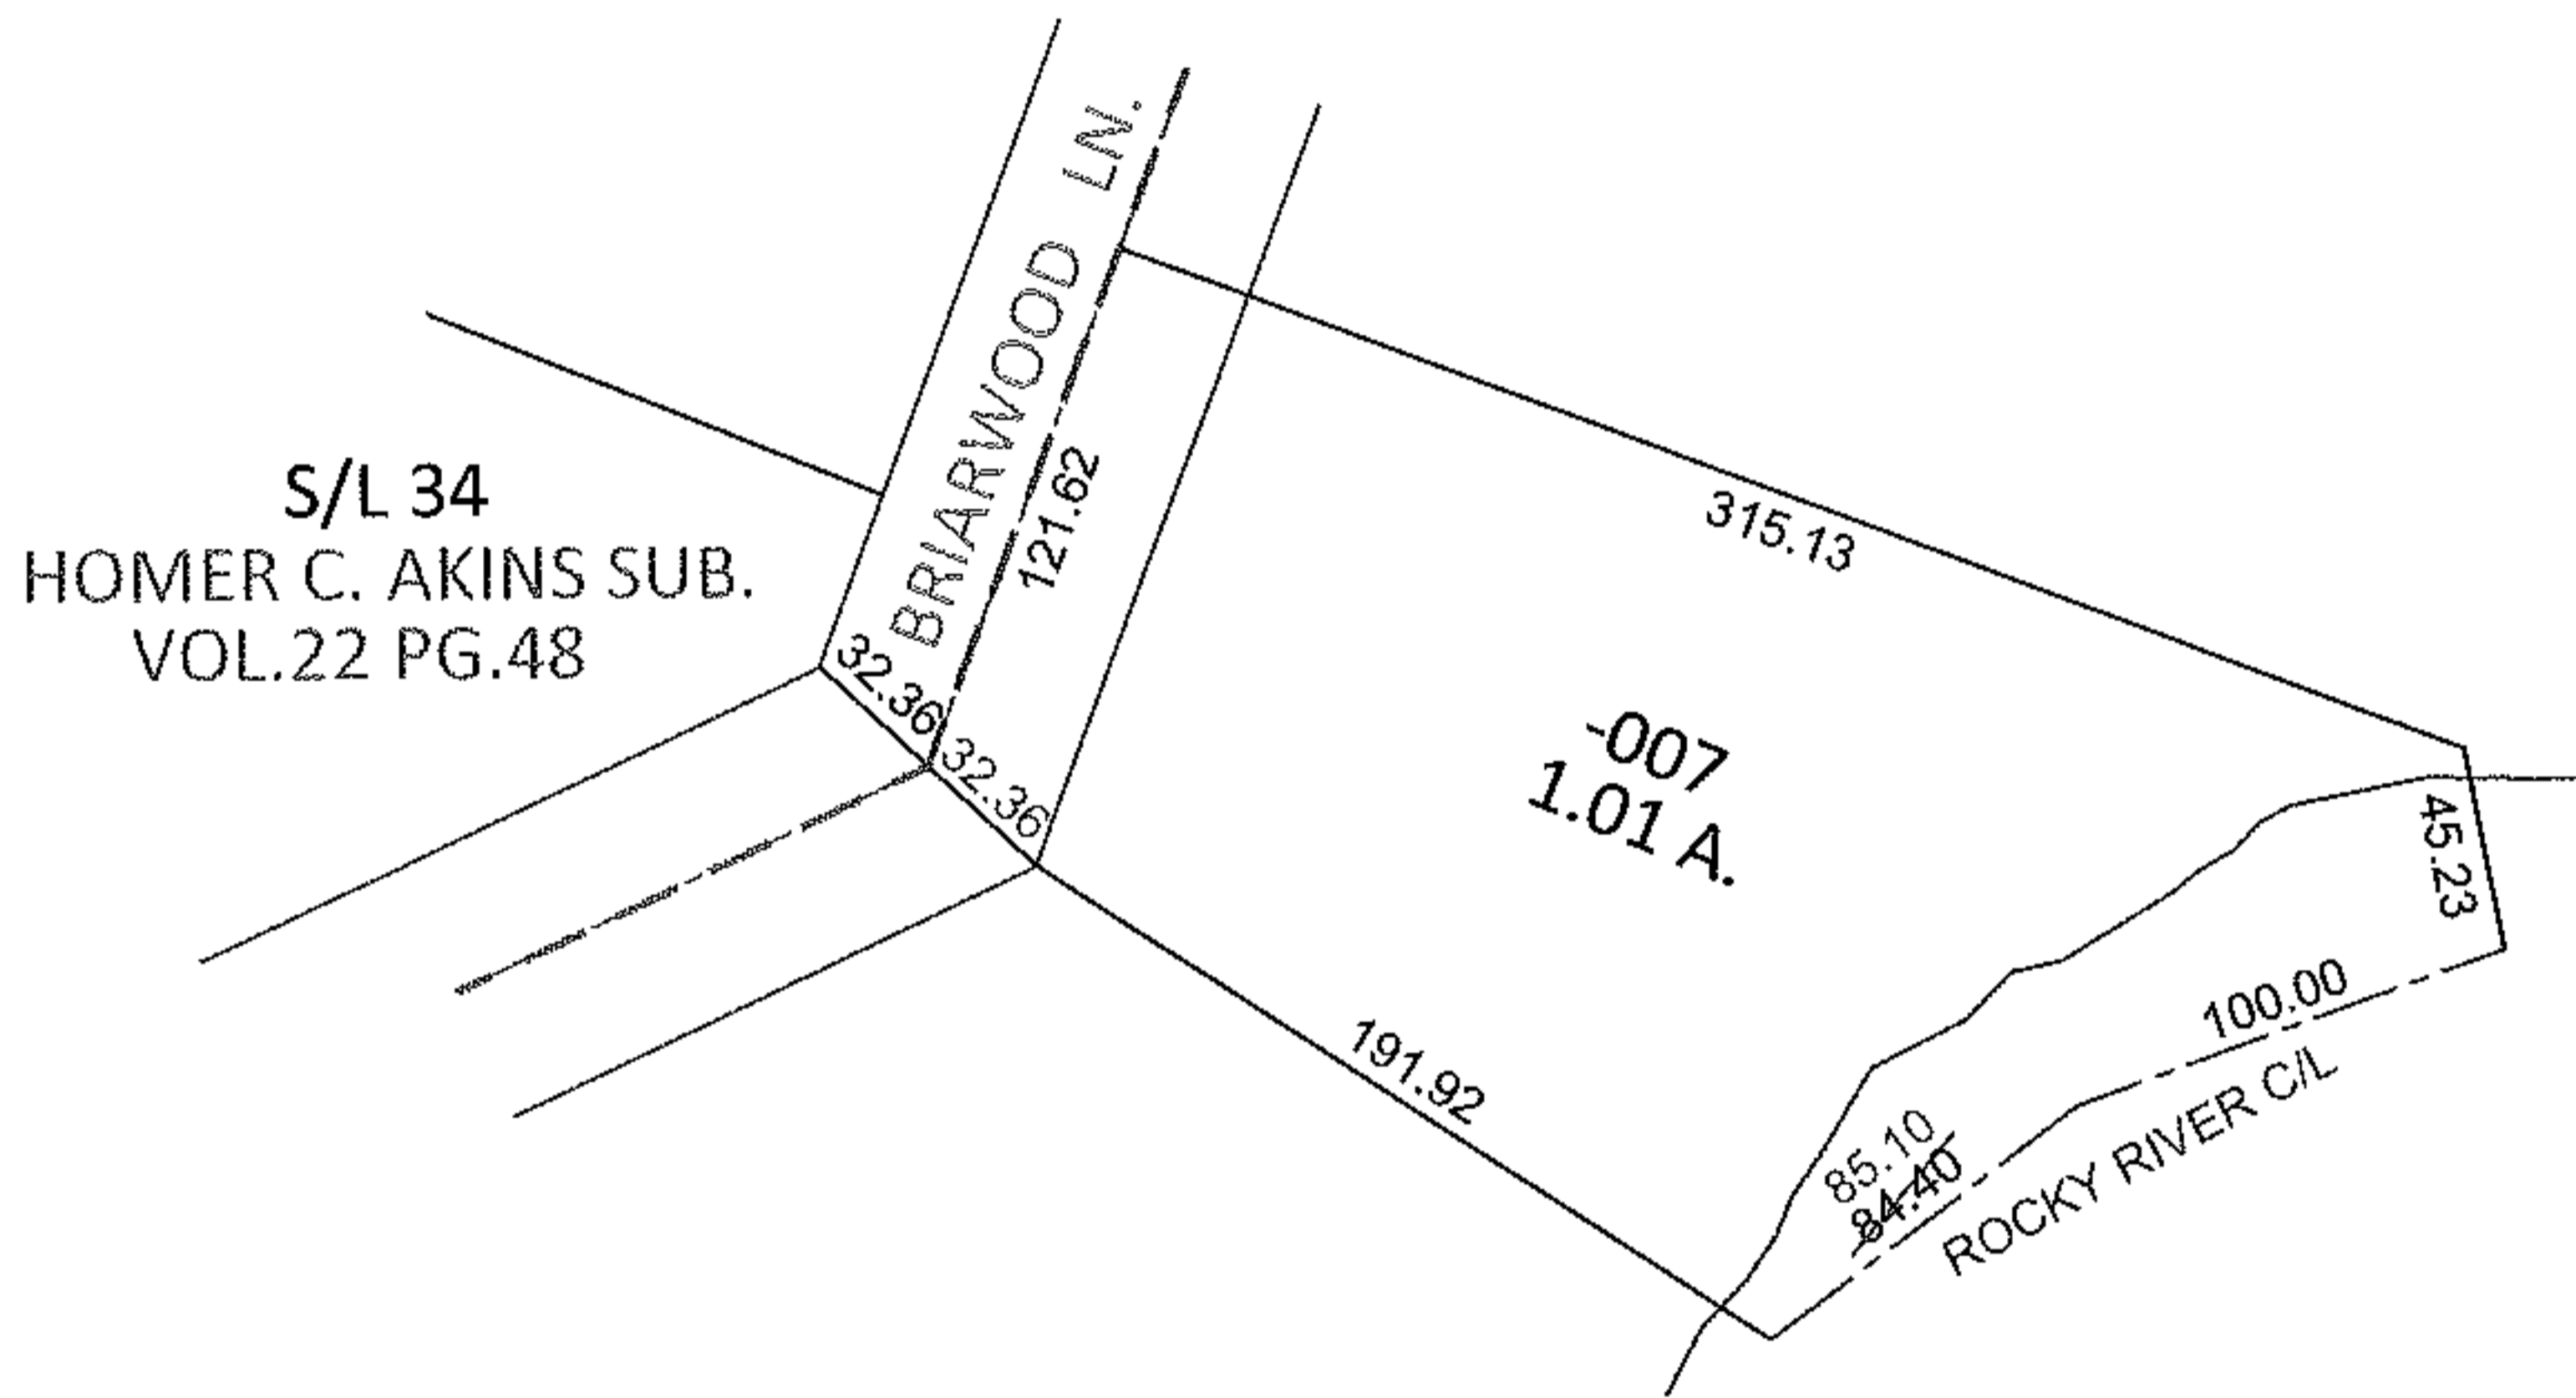


PARENT PARCEL: 12-00-047-103-007

CHILD PARCEL: \_\_\_\_\_


STARTING POINT: SOUTHEAST CORNER OF S/L 34 IN HOMER C AKINS SUB.(VOL.22 PG.48)

12-02575-D

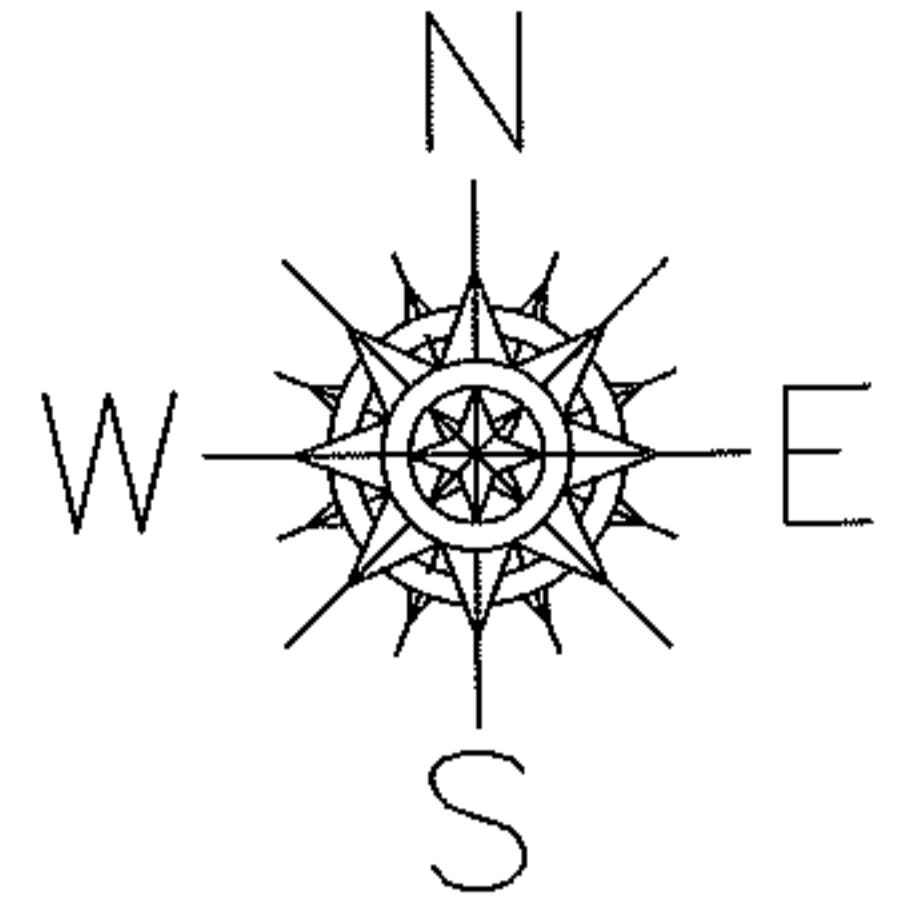

MAP CORRECTION ONLY

PER SURV. D.HAYWOOD

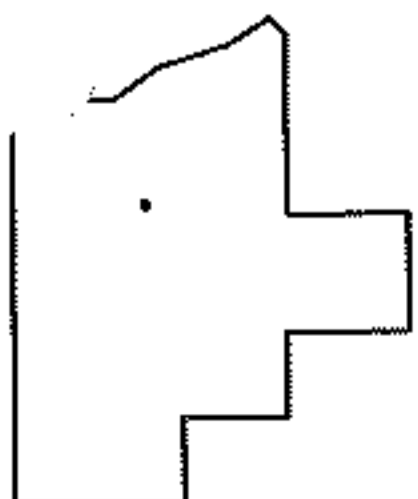

SPLITS/DEEDS PROCESSED

LORAIN COUNTY TAX MAP DEPARTMENT  
226 MIDDLE AVE. ELYRIA, OHIO

SURVEYED BY: DALE R. HAYWOOD

CLOSURE: .01:10,000

MAP PAGE(S): 12-00-047-A

APPROVED BY: RRM DATE: 9-5-12

SCALE: 1"= 100 PRIOR INST.: 20120402717