
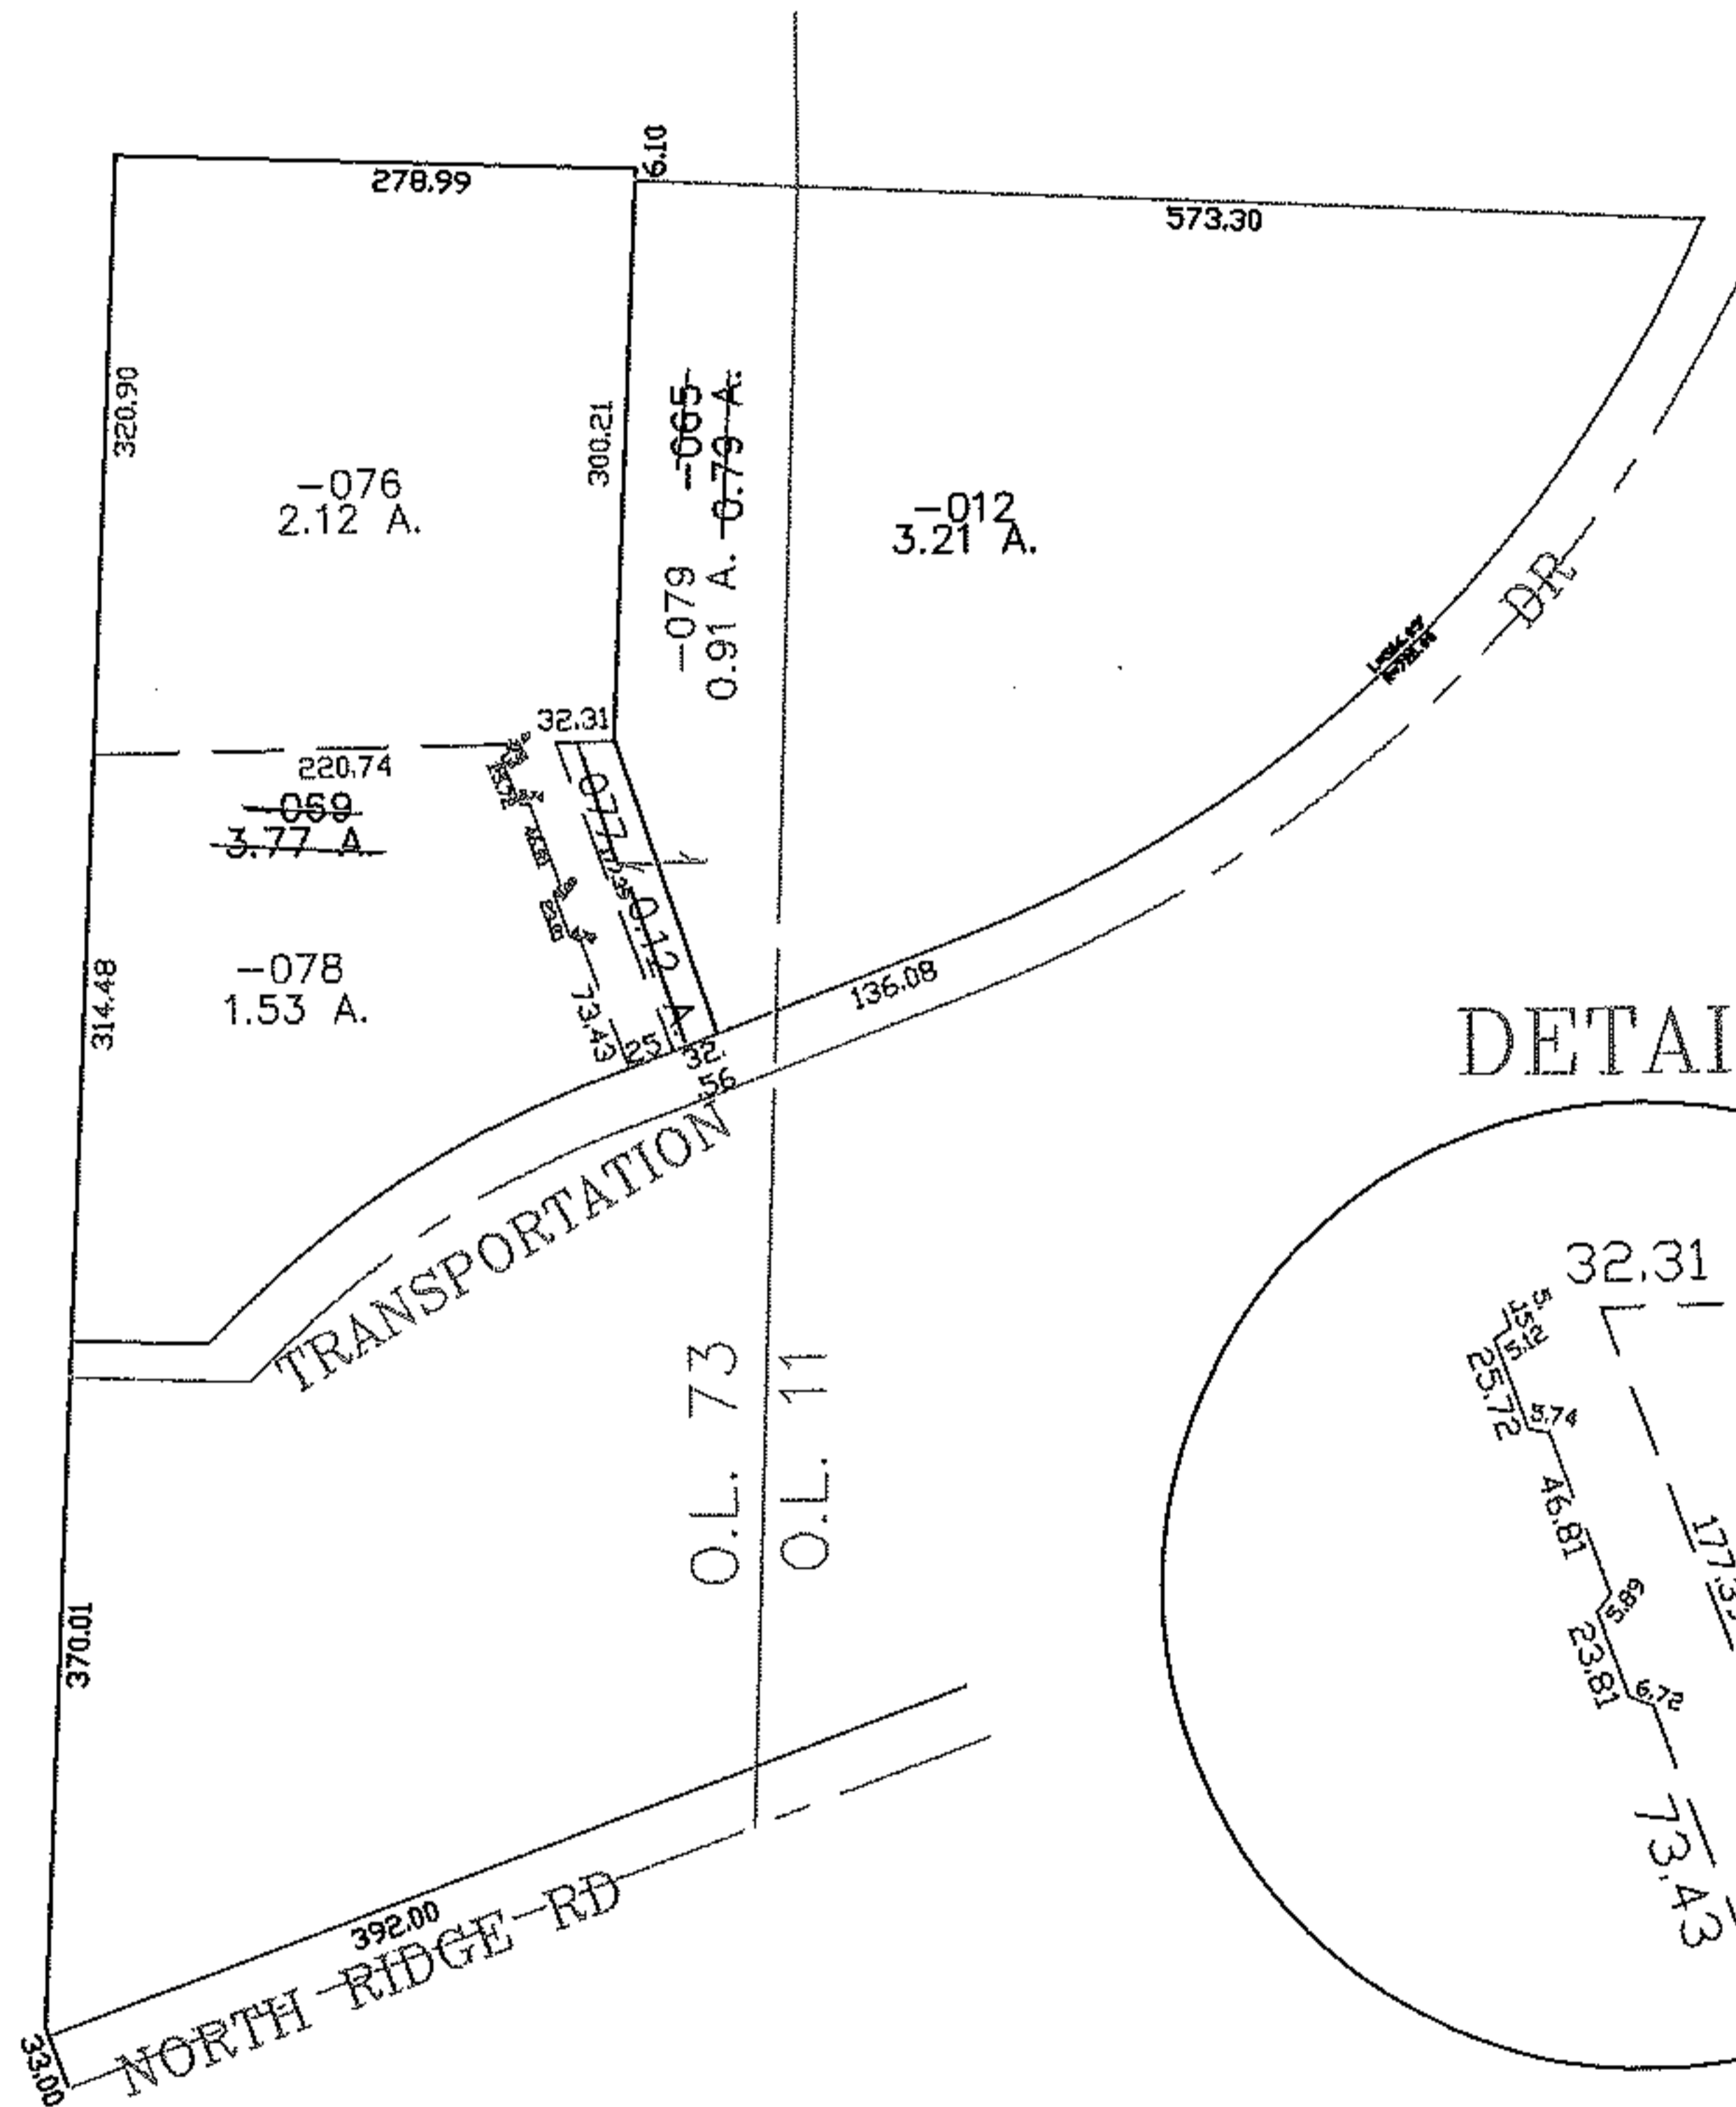


PARENT PARCEL: 03-00-073-000-069, 03-00-011-101-012

CHILD PARCEL: 03-00-073-000-076 THRU -079

STARTING POINT: CENTERLINE OF NORTH RIDGE RD & O.L. 73

08-02575

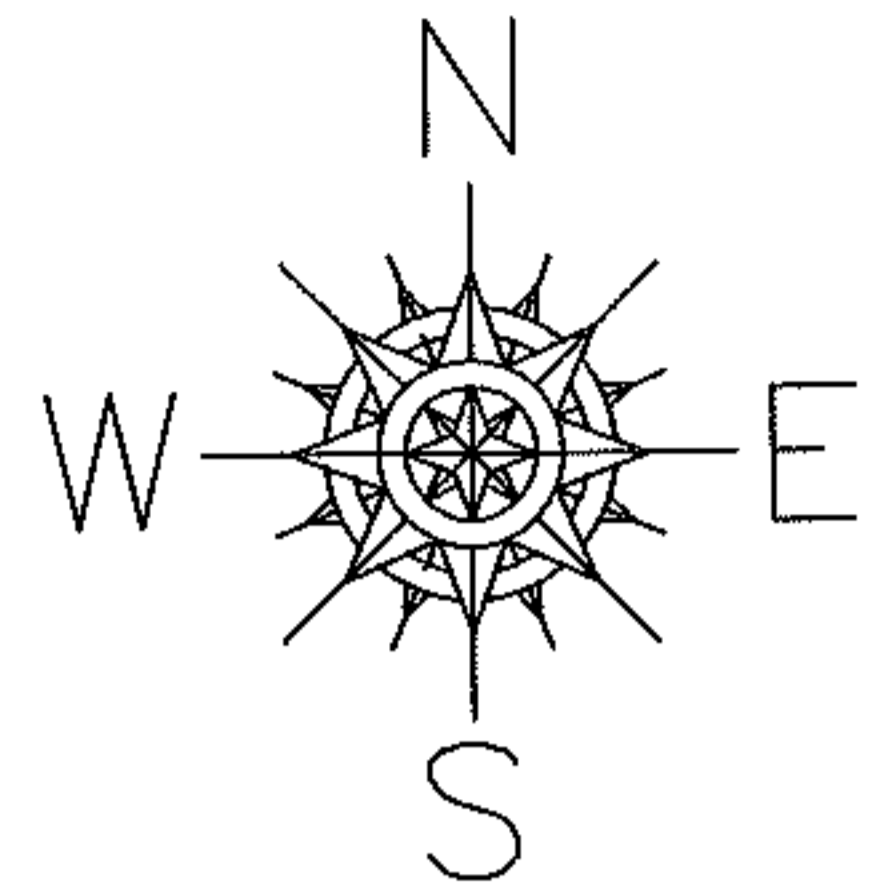

DETAIL

NOT TO SCALE

**SPLITS/DEEDS PROCESSED**

LORAIN COUNTY TAX MAP DEPARTMENT  
226 MIDDLE AVE. ELYRIA, OHIO

SURVEYED BY: DALE HAYWOOD

CLOSURE: 0.00 : 10.000

MAP PAGE(S): 03-00-073-B

APPROVED BY: JAH DATE: 6-5-08

SCALE: 1" = 200 PRIOR INSTRUMENT: 20030918493