
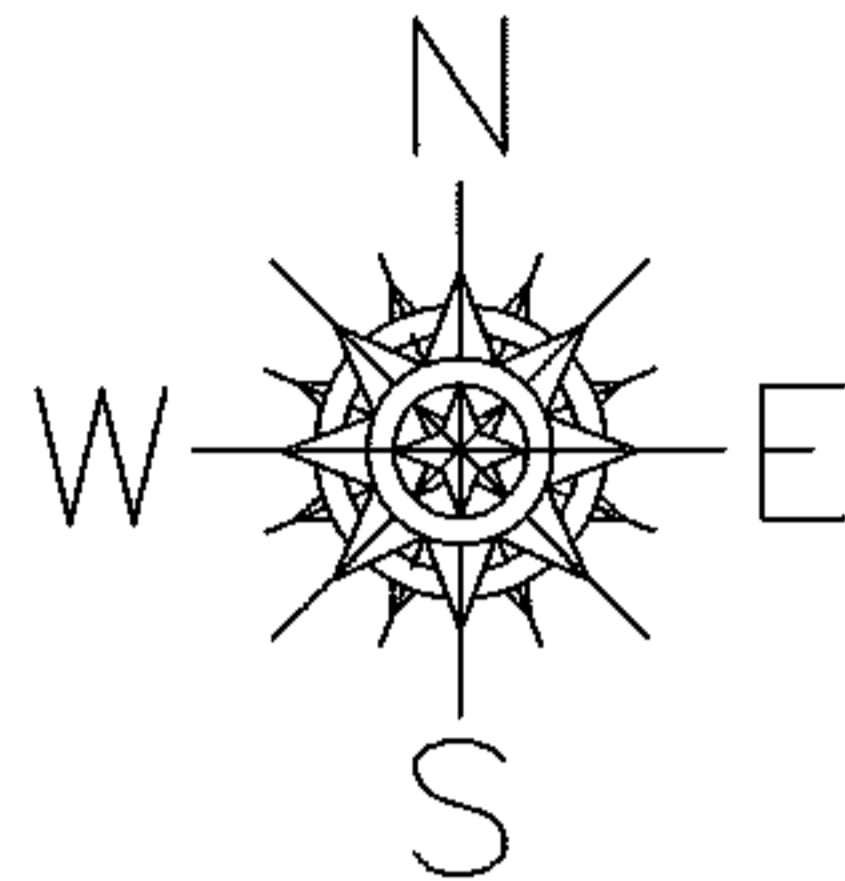


PARENT PARCEL: 19-04-050-000-001 & -002

CHILD PARCEL: 19-04-050-000-003

STARTING POINT: CL OF MEDINA-NORWALK RD. (S.R. 18) & EAST LINE OF O.L. 50

12-02576-C

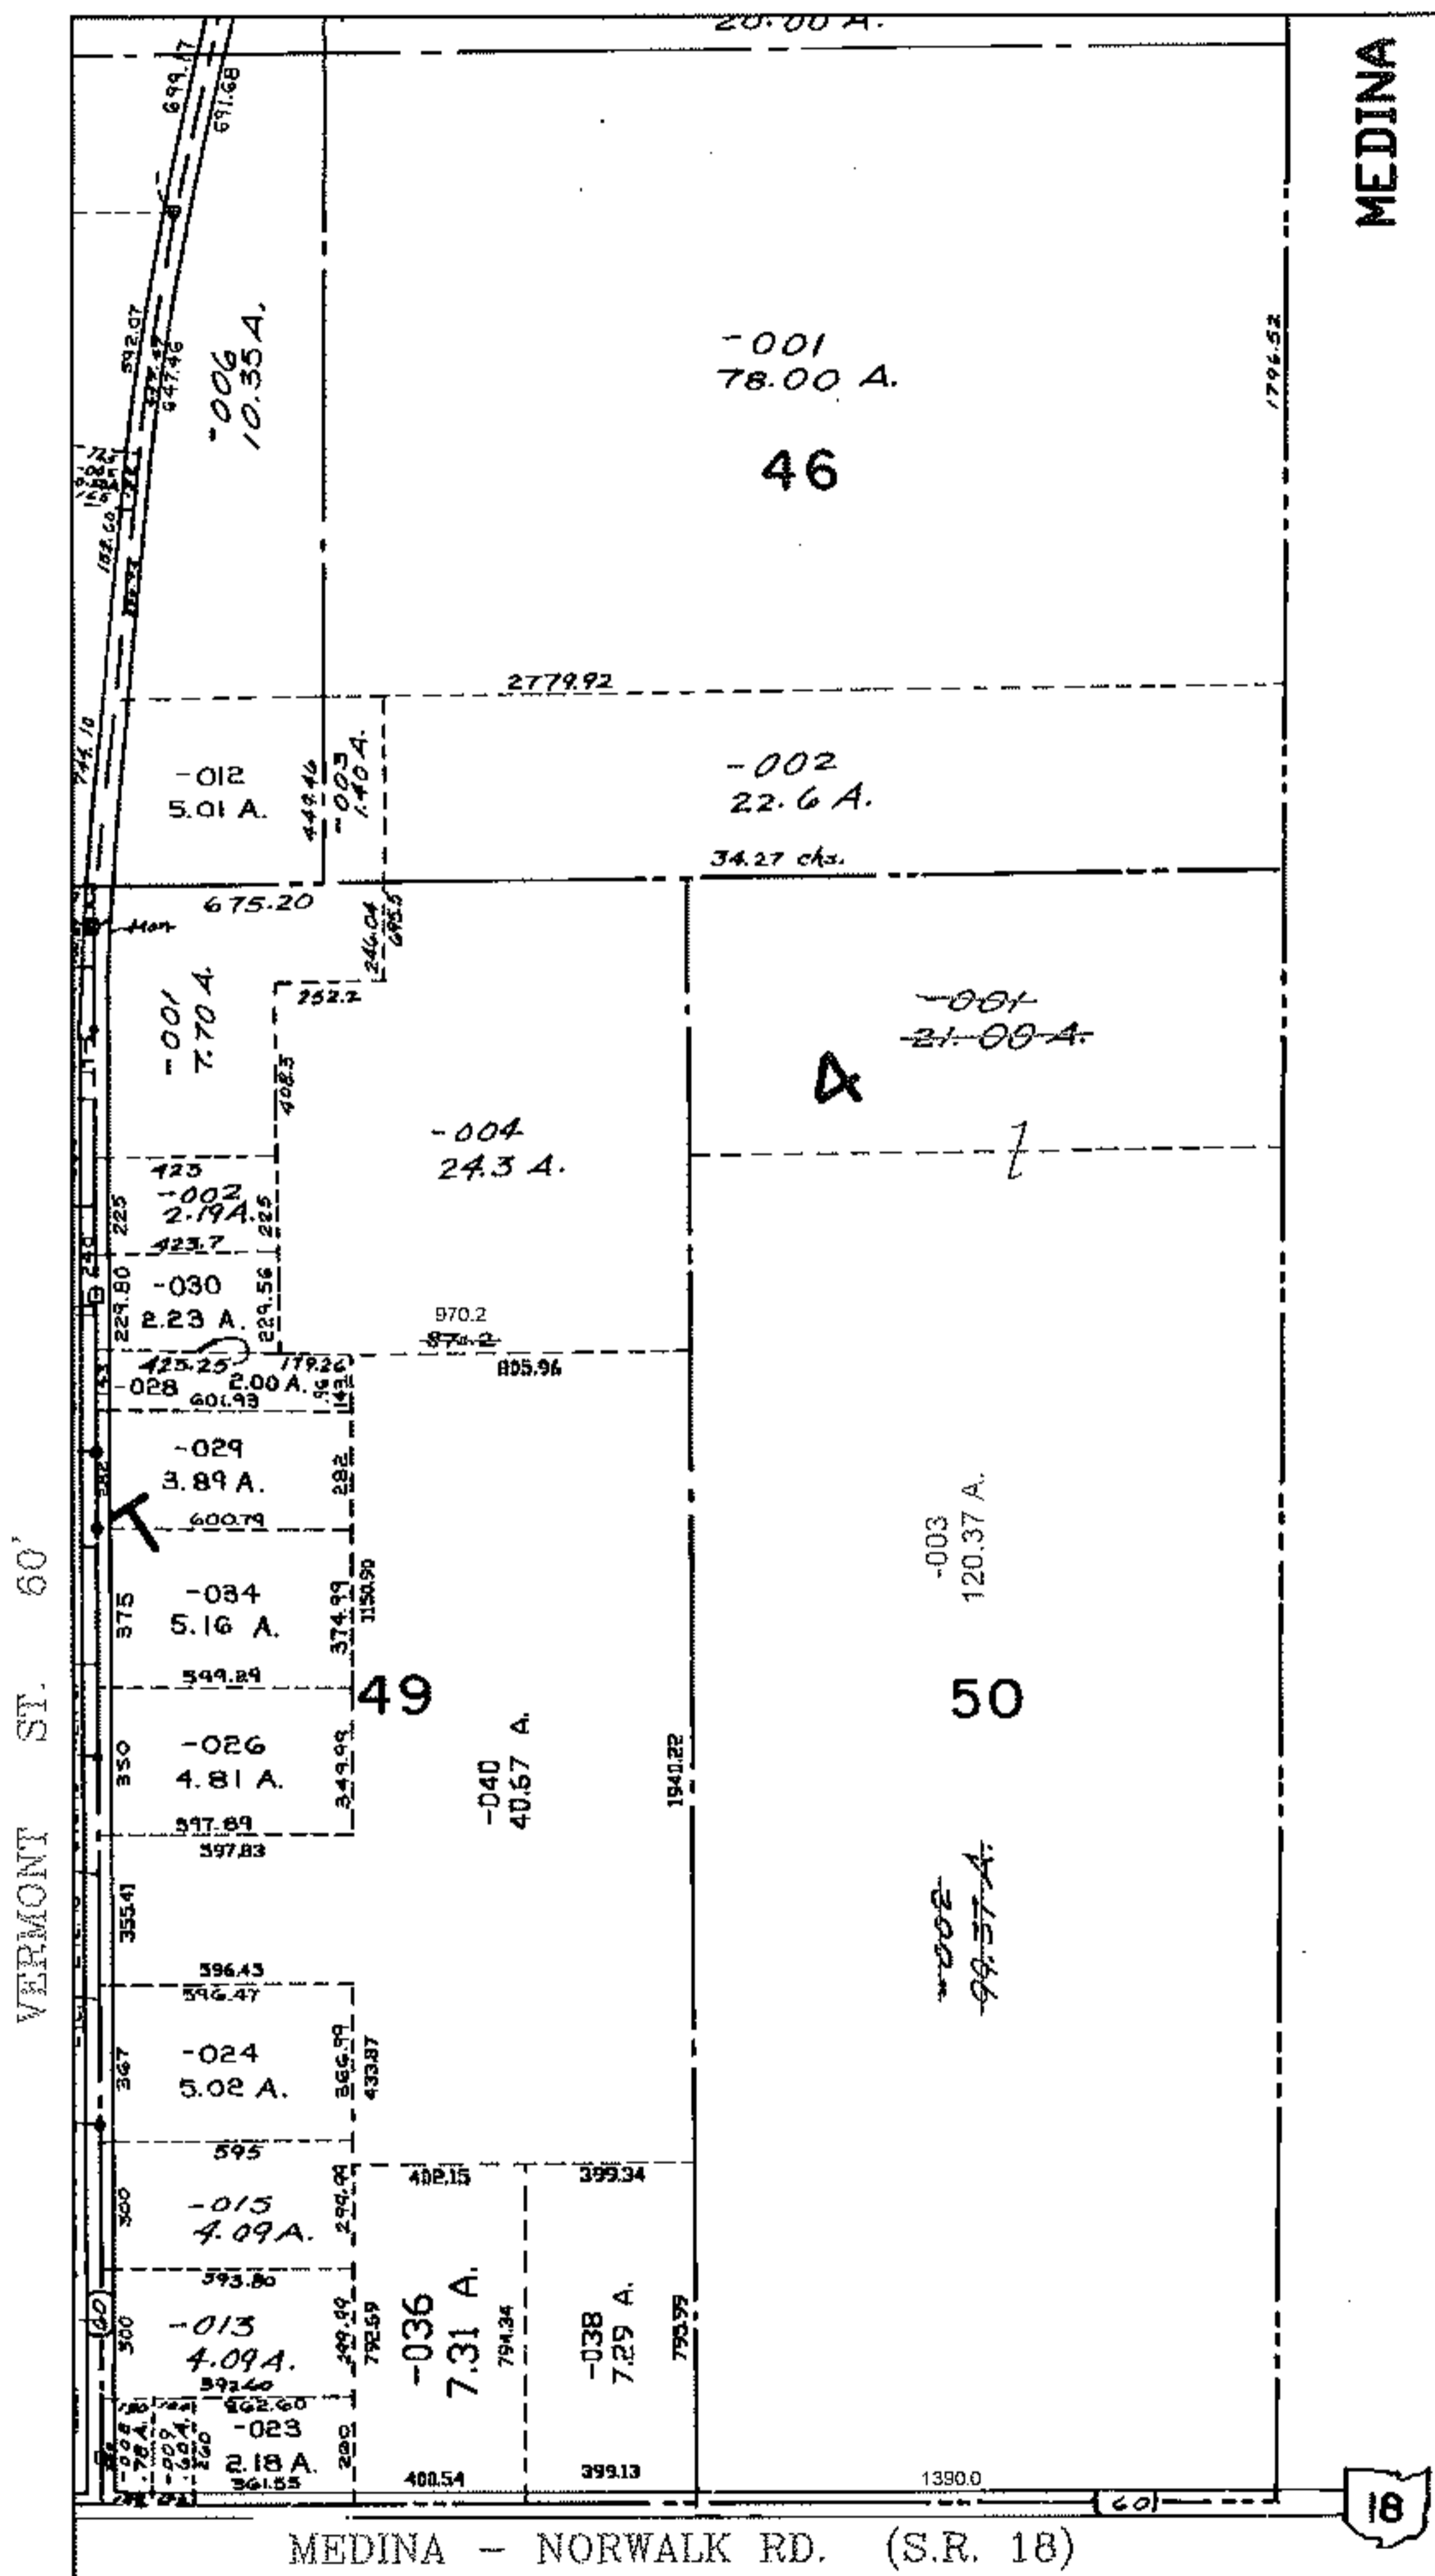

COMBINATION

~~19-04-050-000-001~~

~~21.00 A.~~

~~19-04-050-000-002~~

~~99.37 A.~~

19-04-050-000-003

120.37 A.

PER INST. #20100334433

SPLITS/DEEDS PROCESSED

LORAIN COUNTY TAX MAP DEPARTMENT
226 MIDDLE AVE. ELYRIA, OHIO

SURVEYED BY: NONE

CLOSURE: NONE

MAP PAGE(S): 19-D

APPROVED BY: TJS DATE: 9/13/12

SCALE: 1"= 800 PRIOR INST.: 20100334433