



RASTER

PARENT PARCEL: 05-00-051-000-016, -017

CHILD PARCEL: 05-00-051-000-019 THRU -025

STARTING POINT: CENTERLINE OF OBERLIN RD & O.L. 51

08-02576

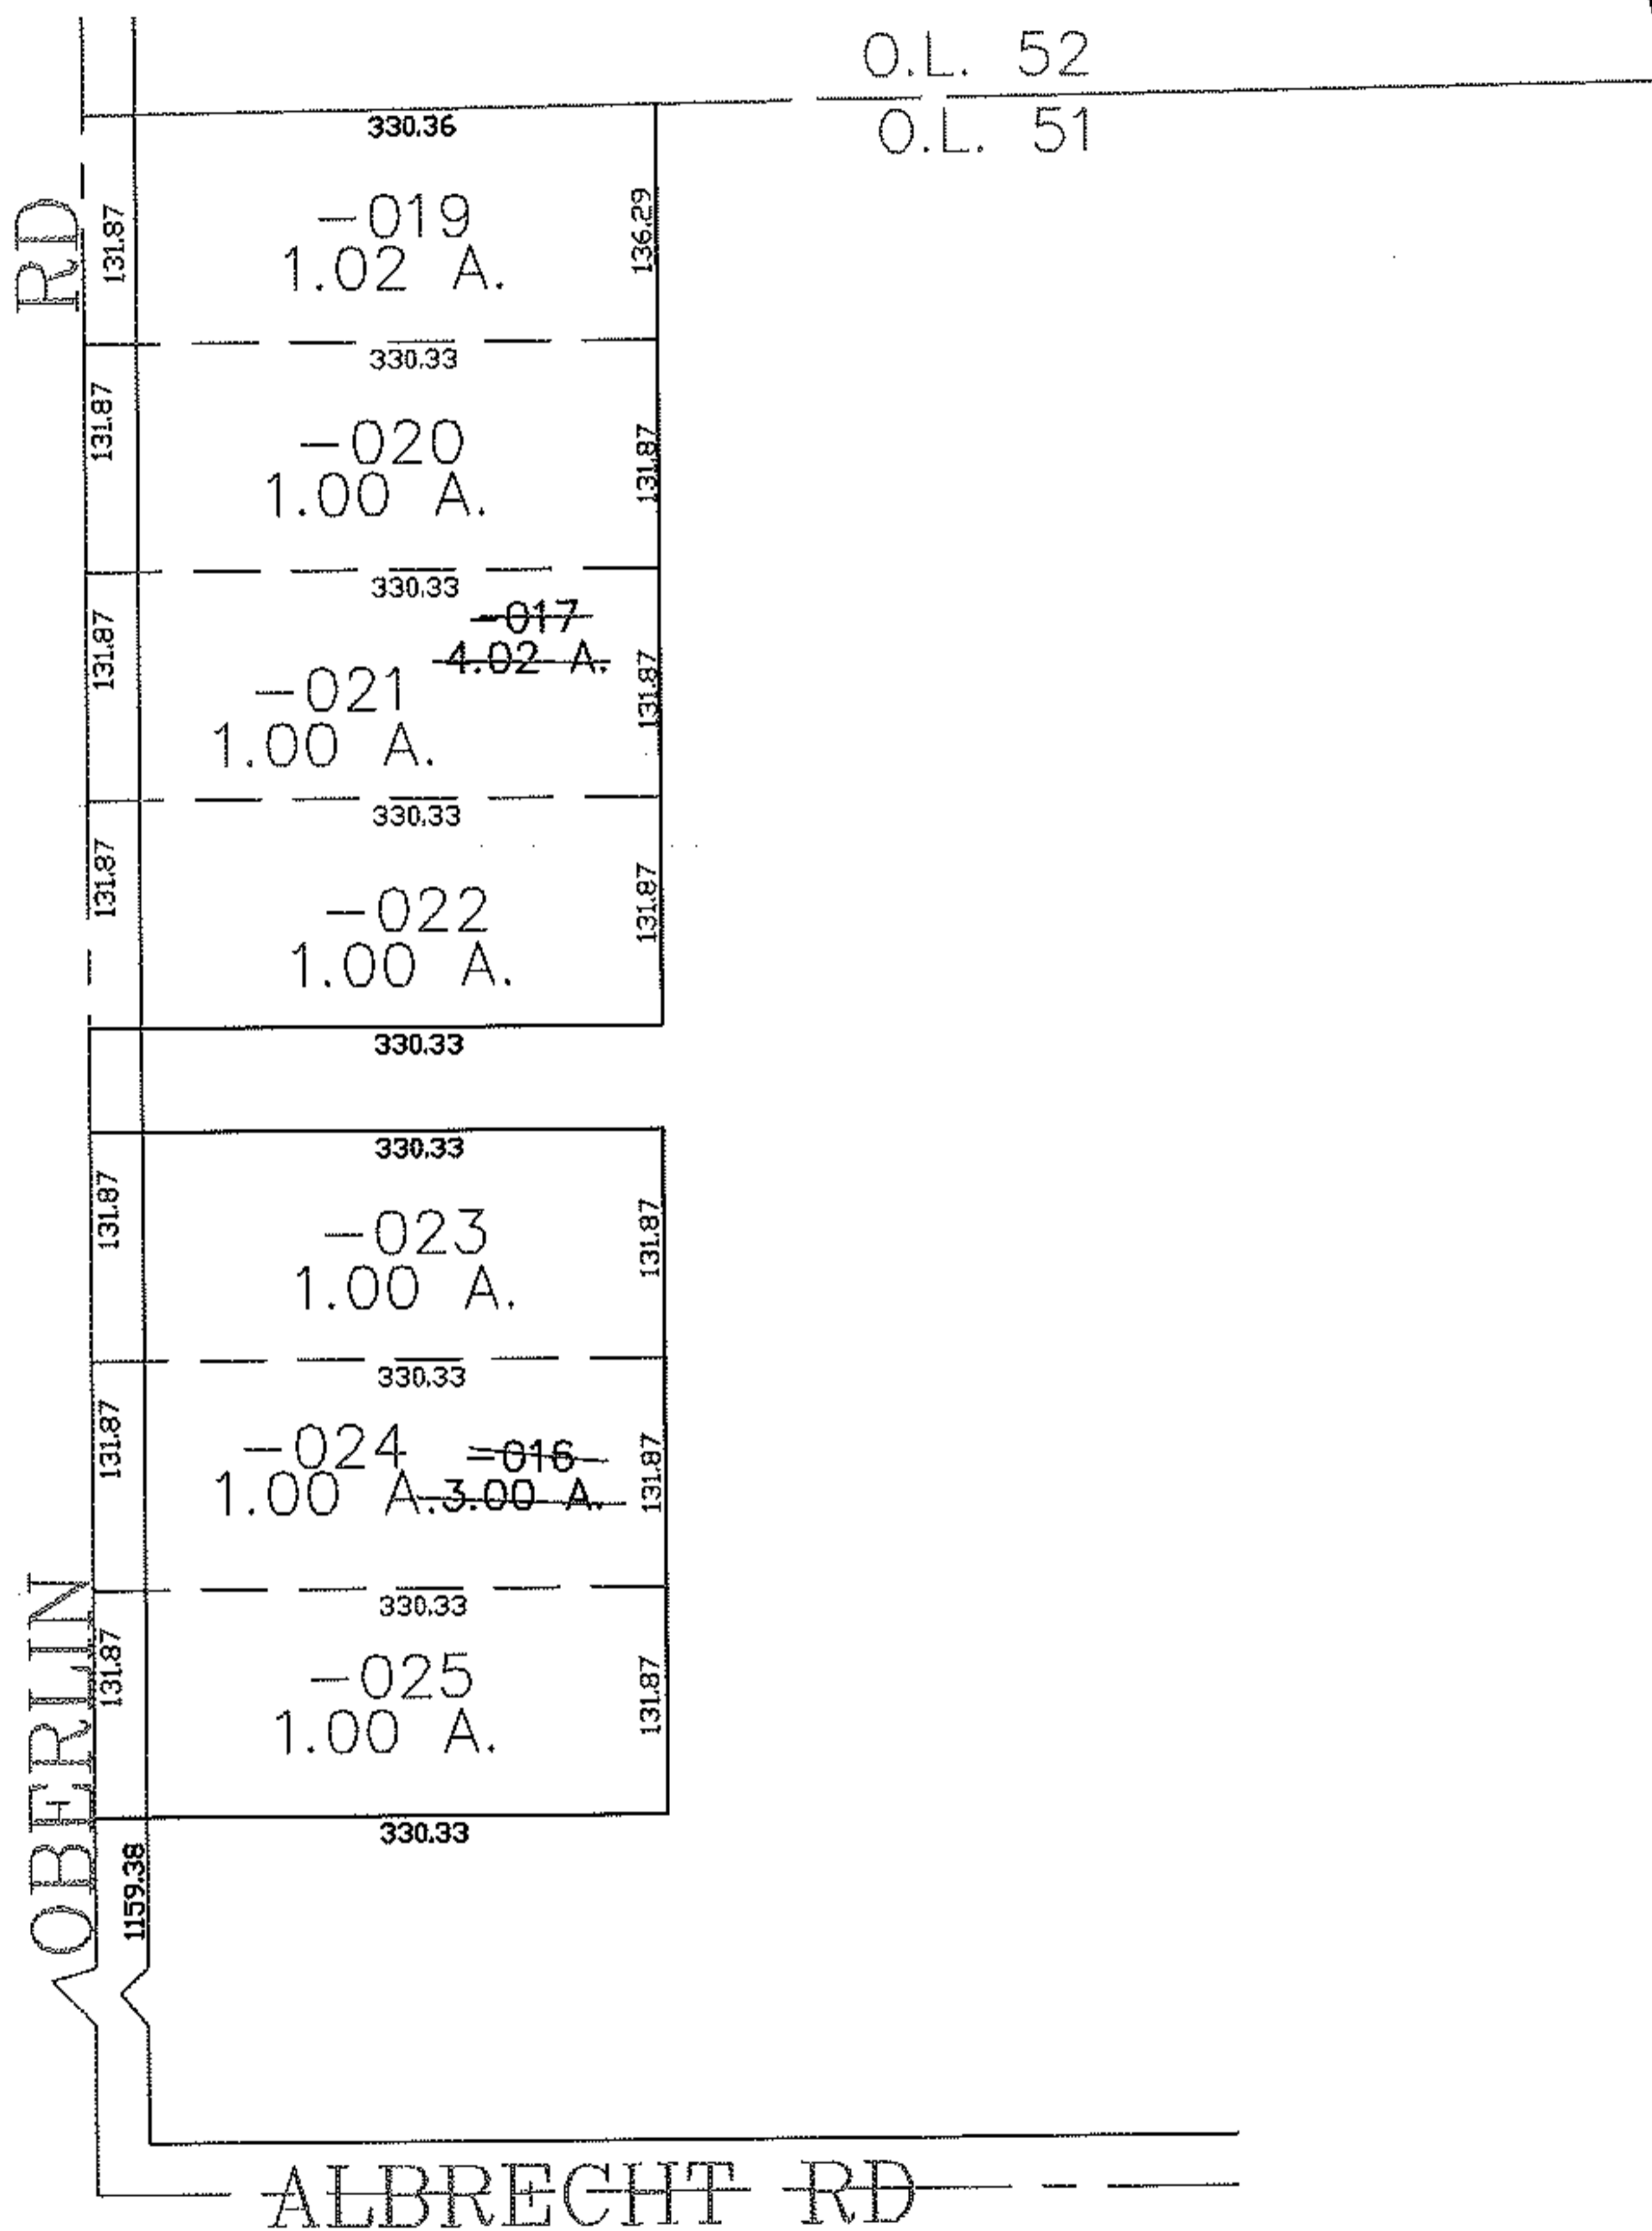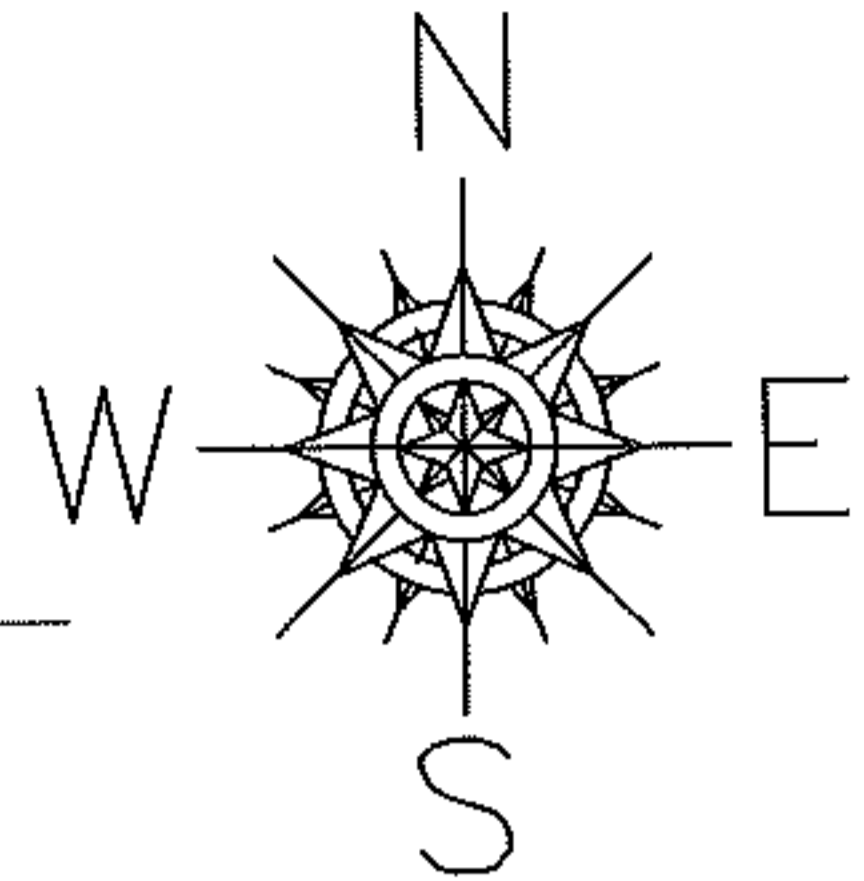

RD

OBERLIN

ALBRECHT RD

O.L. 52  
O.L. 51

**SPLITS/DEEDS PROCESSED**  
 LORAIN COUNTY TAX MAP DEPARTMENT  
 226 MIDDLE AVE. ELYRIA, OHIO

SURVEYED BY: THOMAS SIMON  
 CLOSURE: 0.00 : 10,000  
 MAP PAGE(S): 05-00-051-B  
 APPROVED BY: JAH DATE: 6-9-08  
 SCALE: 1" = 200 PRIOR INSTRUMENT: 20080254241