



RASTER

PARENT PARCEL: 07-00-004-108-098

CHILD PARCEL: 07-00-004-108-100 THRU -102

STARTING POINT: CENTERLINE OF LEAR NAGLE RD & CHESTNUT RIDGE RD

08-02578

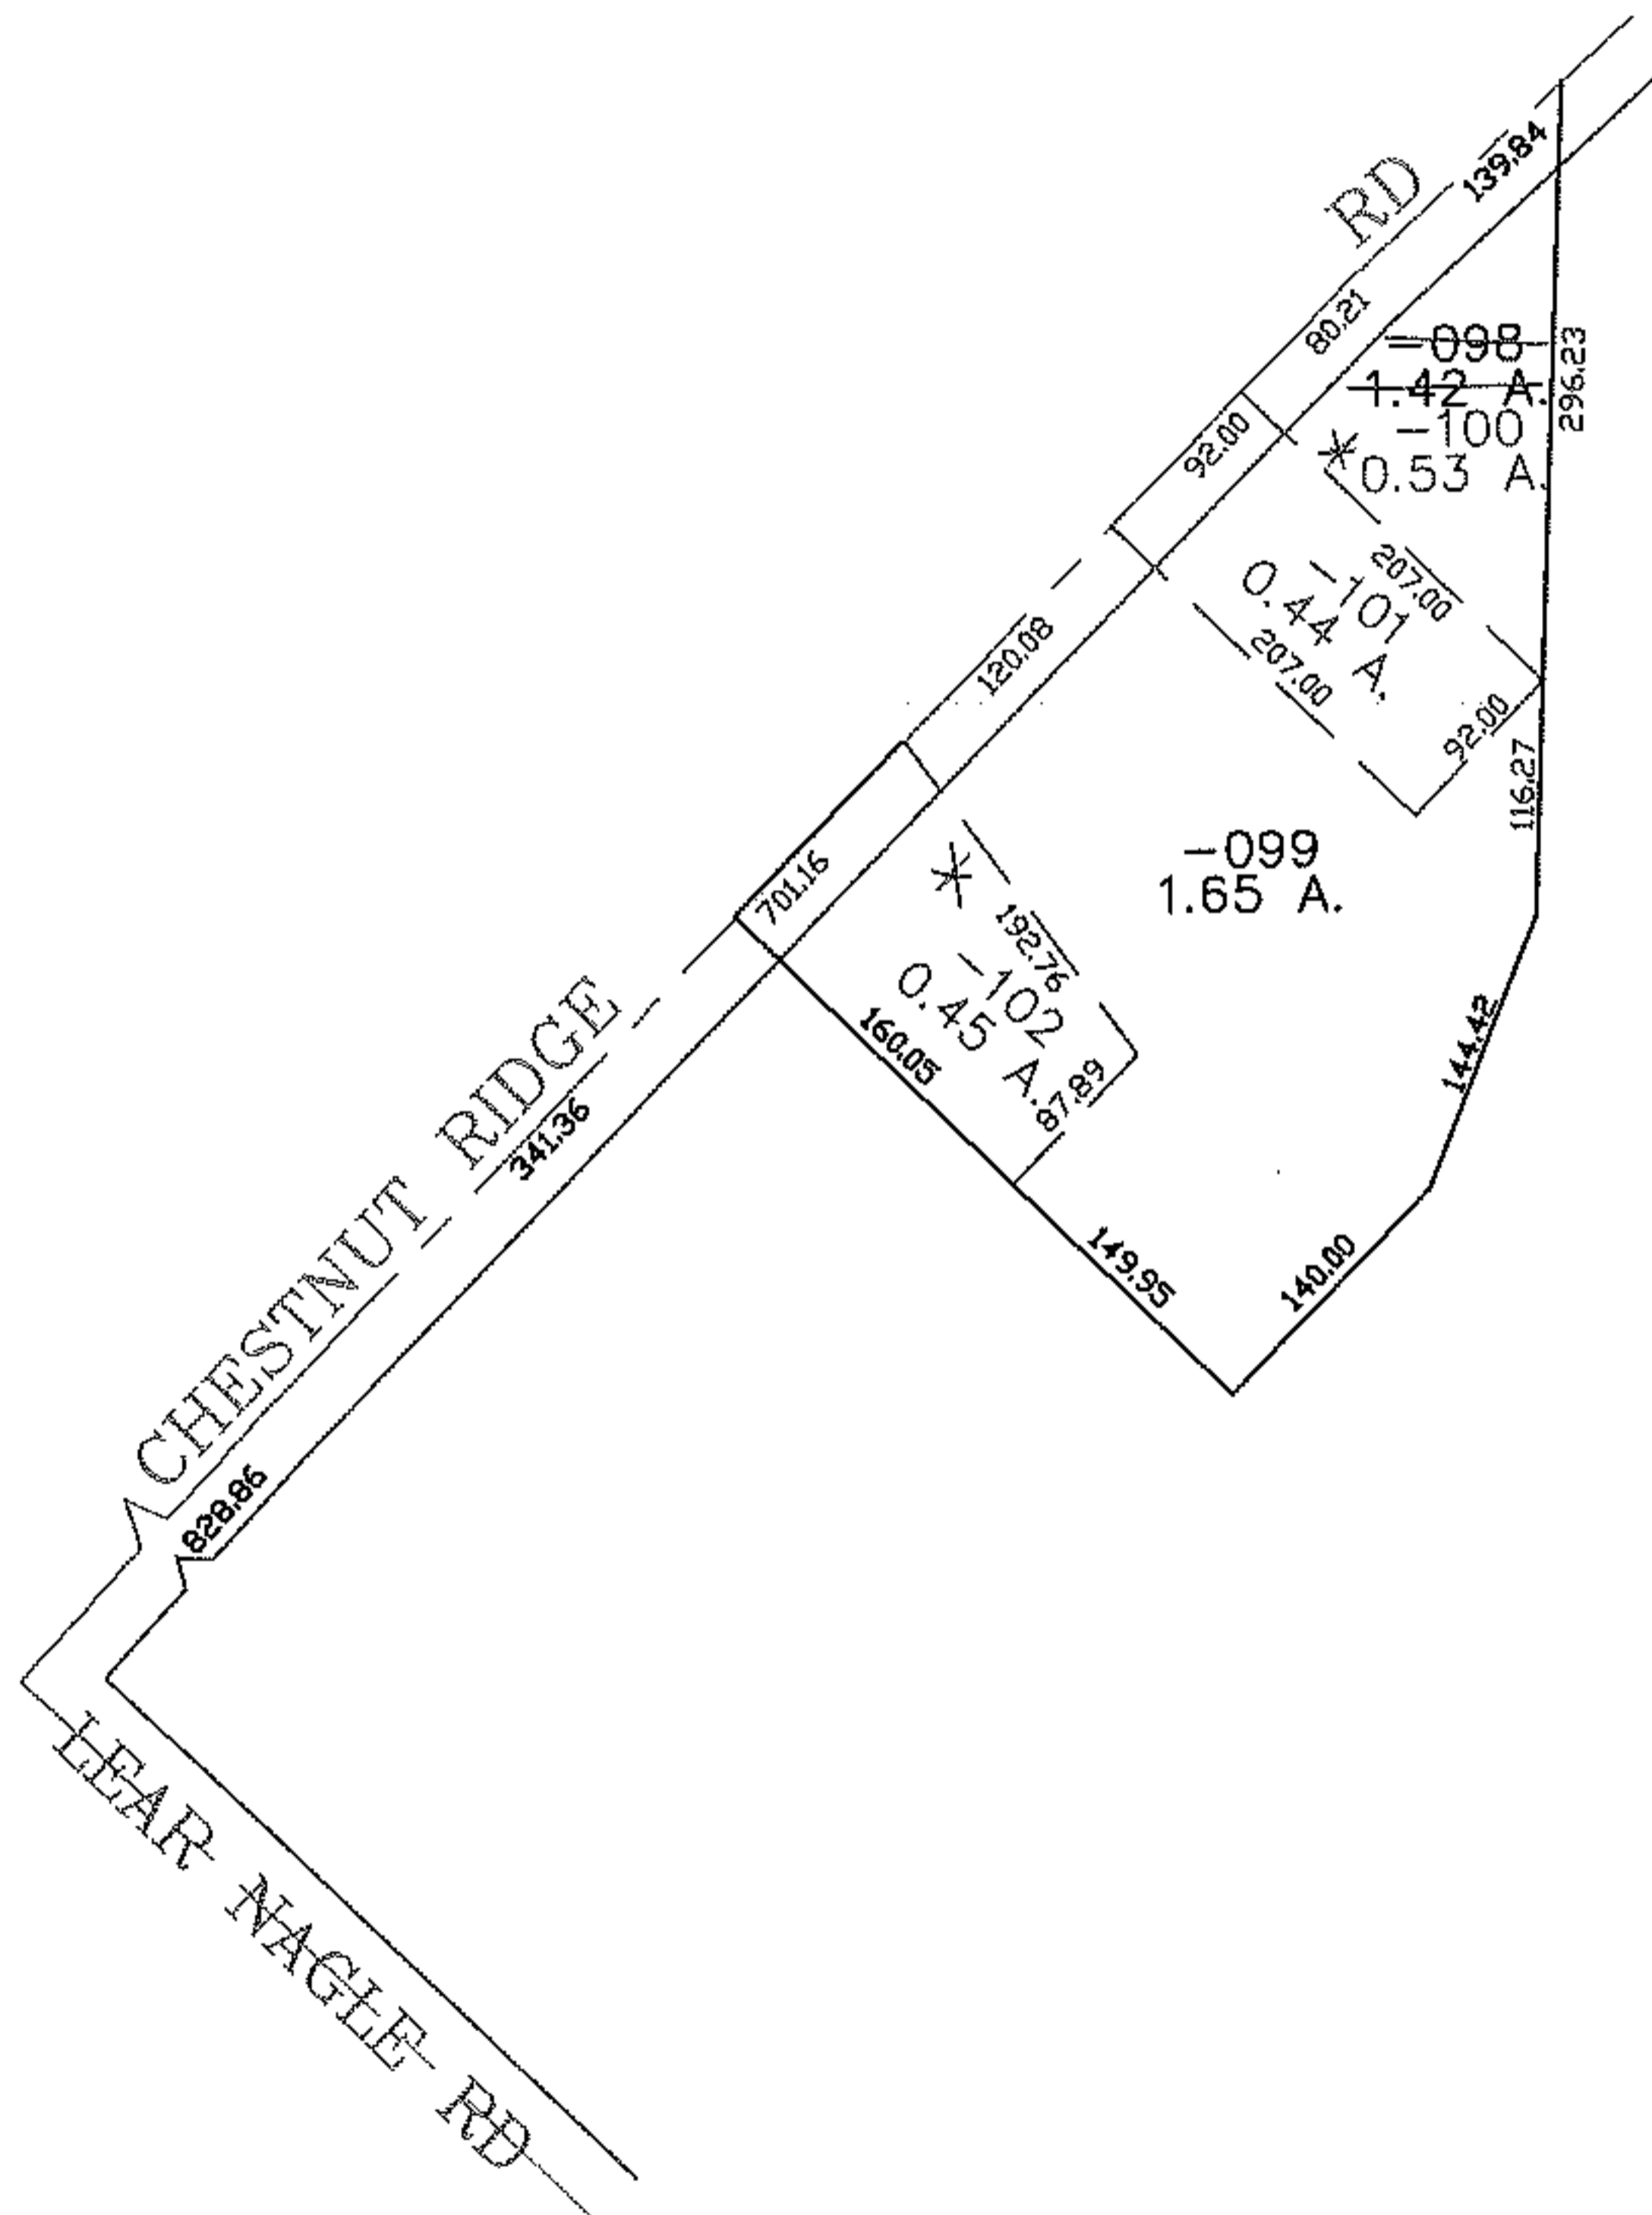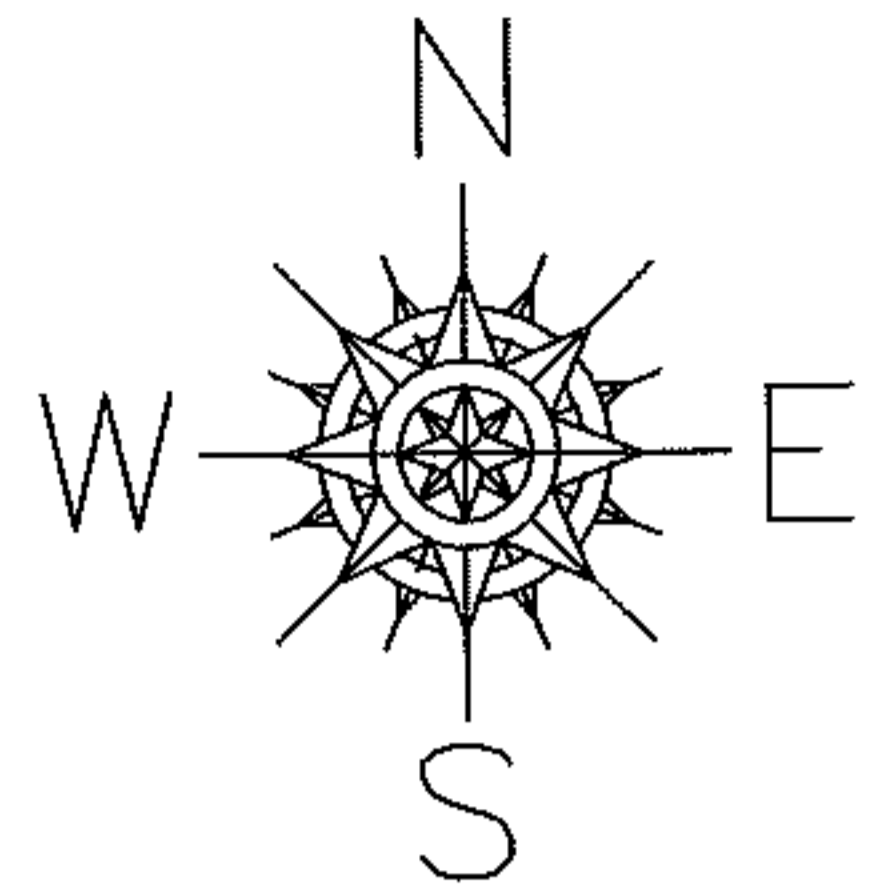

SPLITS/DEEDS PROCESSED

LORAIN COUNTY TAX MAP DEPARTMENT
226 MIDDLE AVE. ELYRIA, OHIO

SURVEYED BY: JAMES RESAR

CLOSURE: 0.00 : 10,000

MAP PAGE(S): 07-00-004-A

APPROVED BY: JAH DATE: 8-22-08

SCALE: 1" = 200 PRIOR INSTRUMENT: 20070232689