
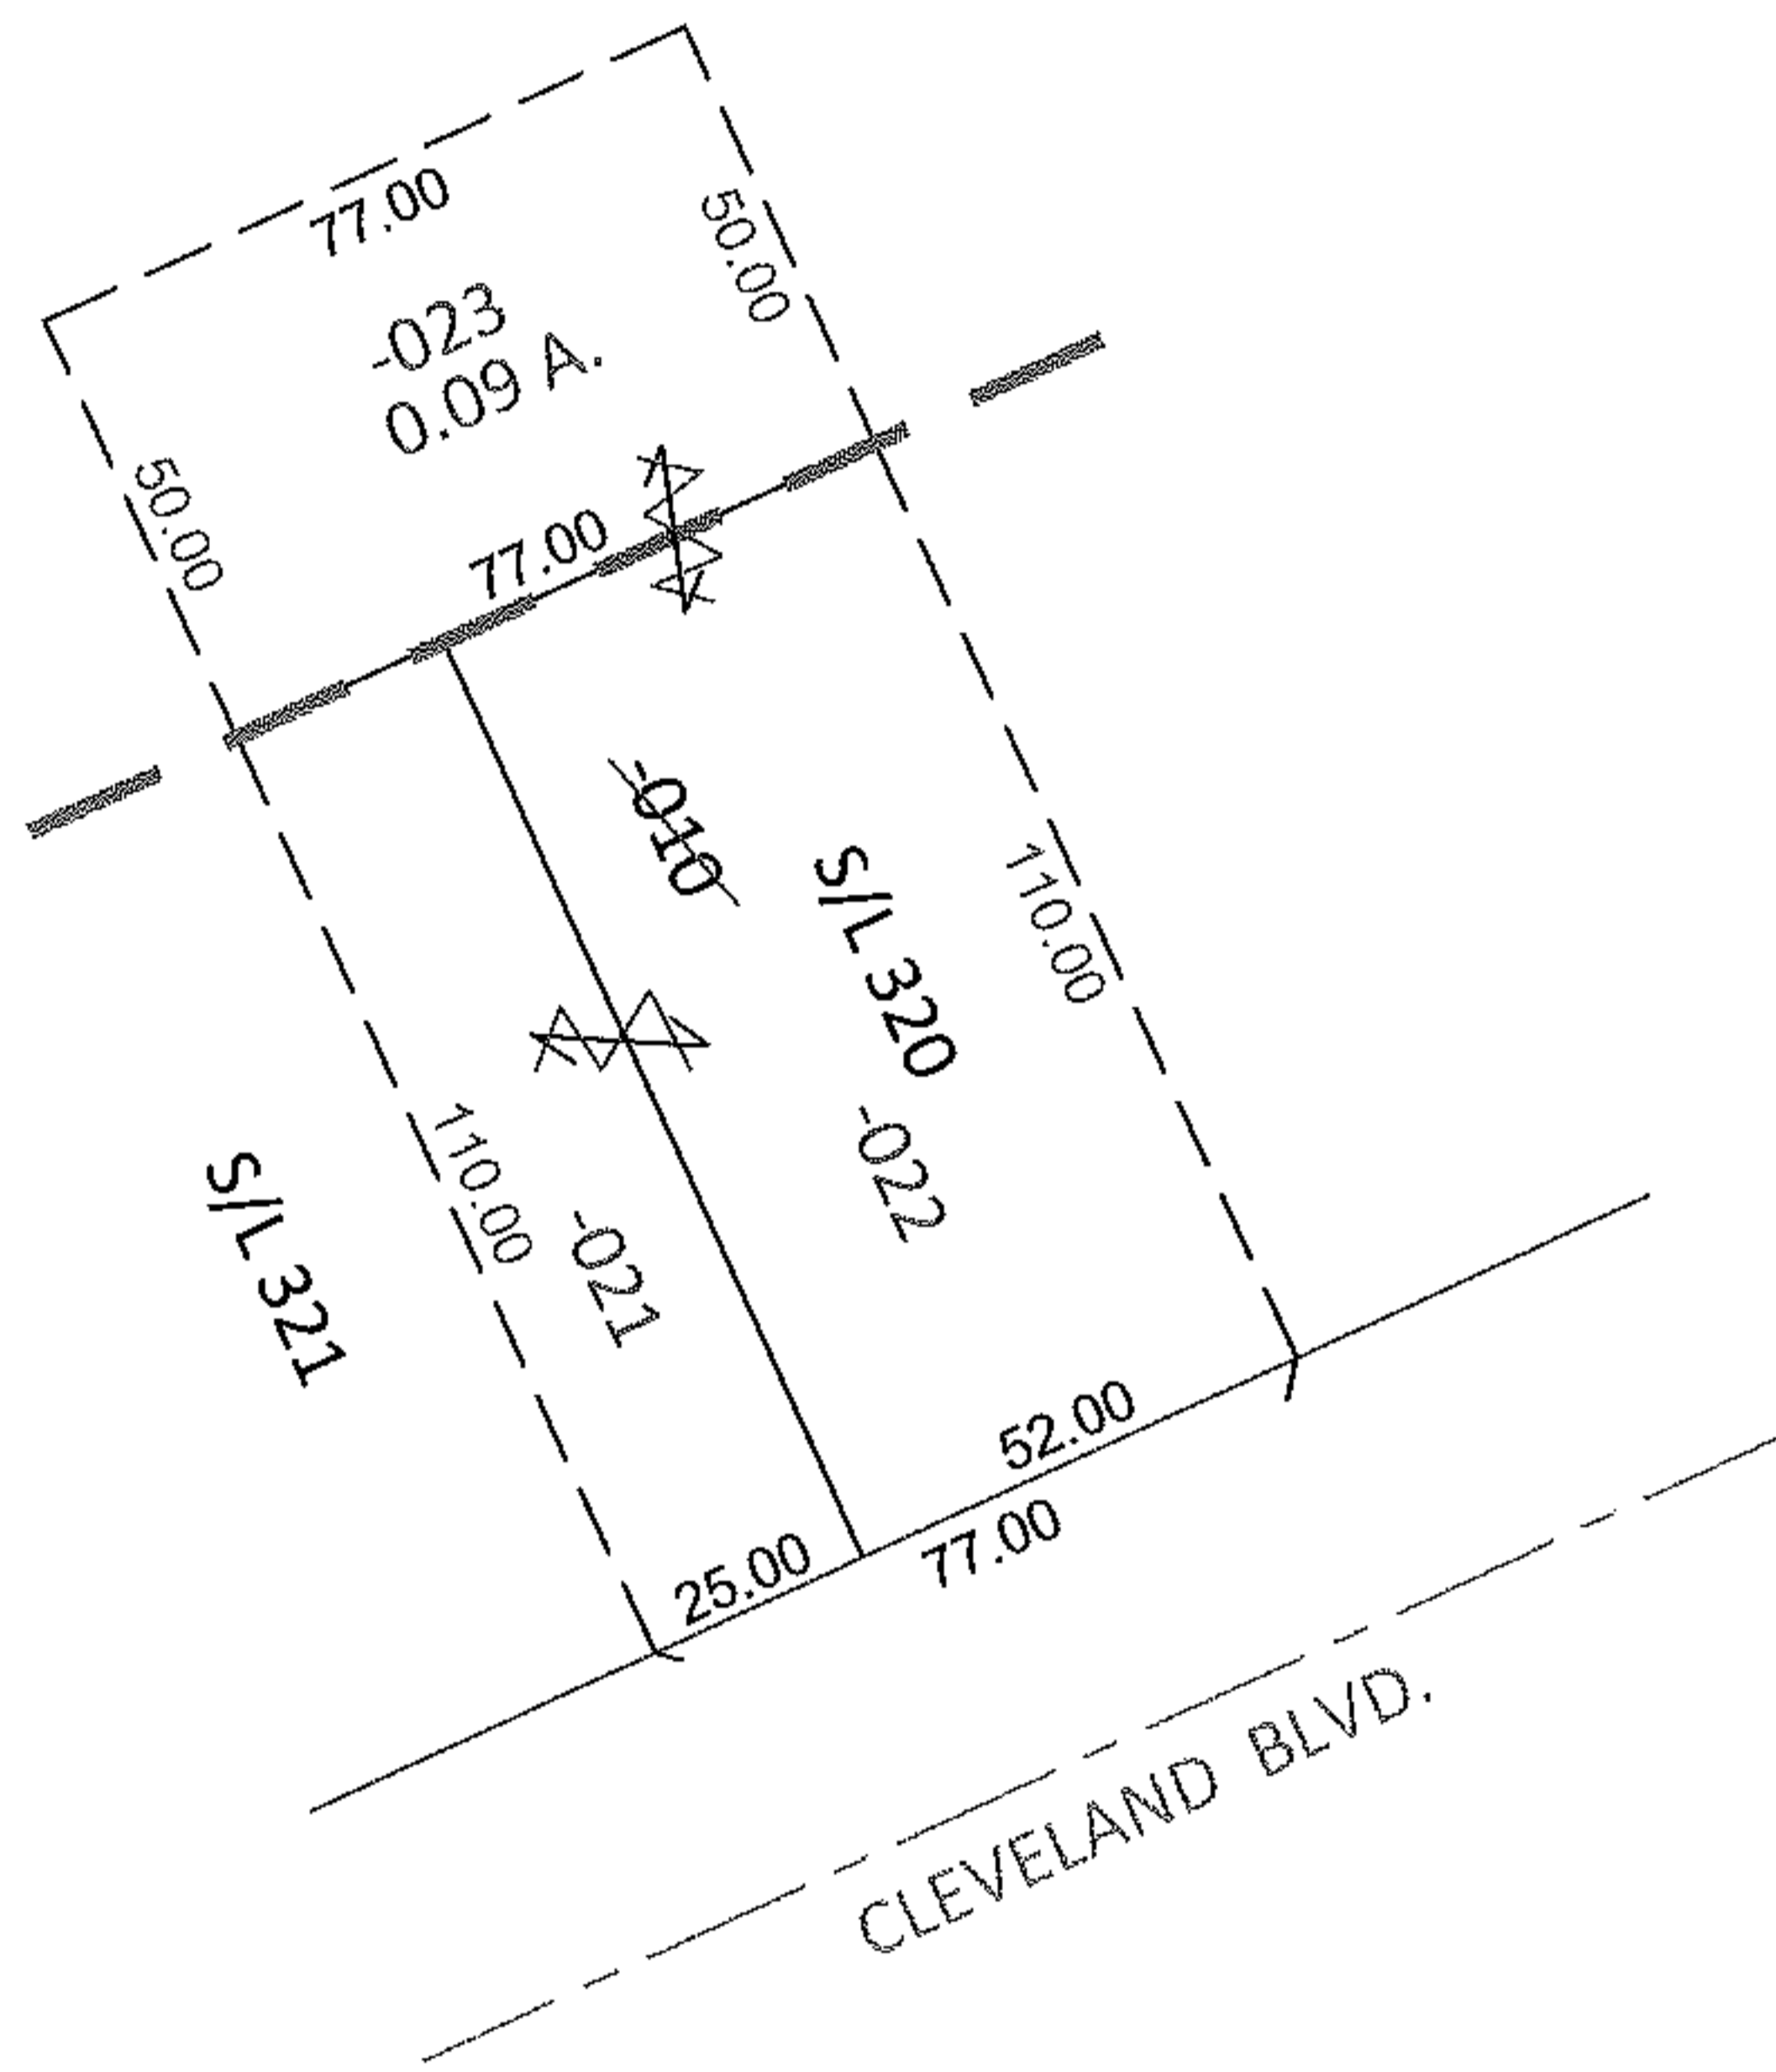


PARENT PARCEL: 03-00-049-102-010
 CHILD PARCEL: 03-00-049-102-021 THRU -023
 STARTING POINT: PART OF S/L 320 AND S/L 321 IN HOY-LO-MAE ALLOT. 3RD ADD. (VOL.15 PG.7)

12-02579-U

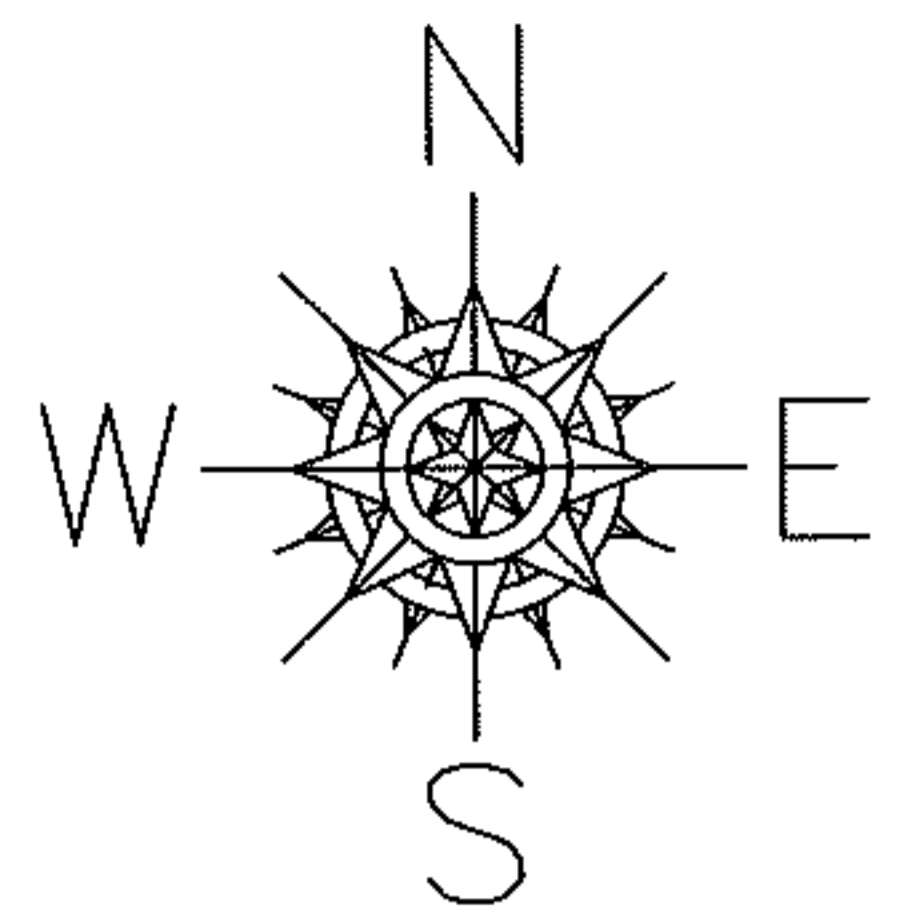


UNCOMBINATION

~~03-00-049-102-010~~
~~77 X 160~~

03-00-049-102-021 03-00-049-102-022 03-00-049-102-023
 25 X 110 52 X 110 0.09 A.

PER PRIOR DEEDS

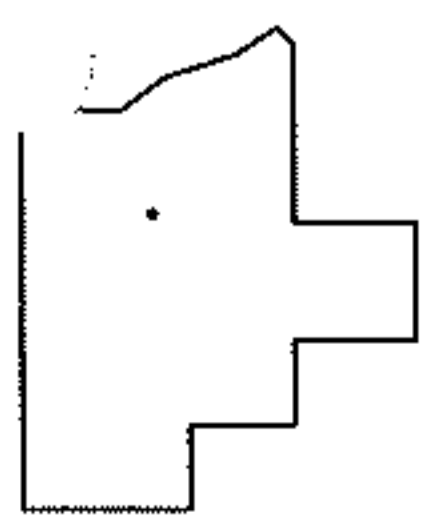

SPLITS/DEEDS PROCESSED

LORAIN COUNTY TAX MAP DEPARTMENT
 226 MIDDLE AVE. ELYRIA, OHIO

SURVEYED BY: N/A
 CLOSURE: N/A
 MAP PAGE(S): 3-00-049-A
 APPROVED BY: RRM DATE: 9-13-12
 SCALE: 1"= 50' PRIOR INST.: DV 1374/400