




RASTER

PARENT PARCEL: 04-00-025-000-469

CHILD PARCEL: 04-00-025-000-488 THRU -490

STARTING POINT: CENTERLINE OF NAGEL RD & AGUSTA WAY

08-02584

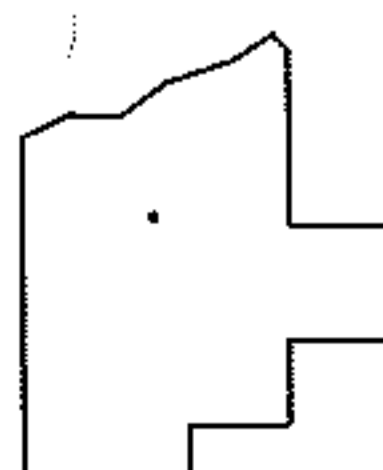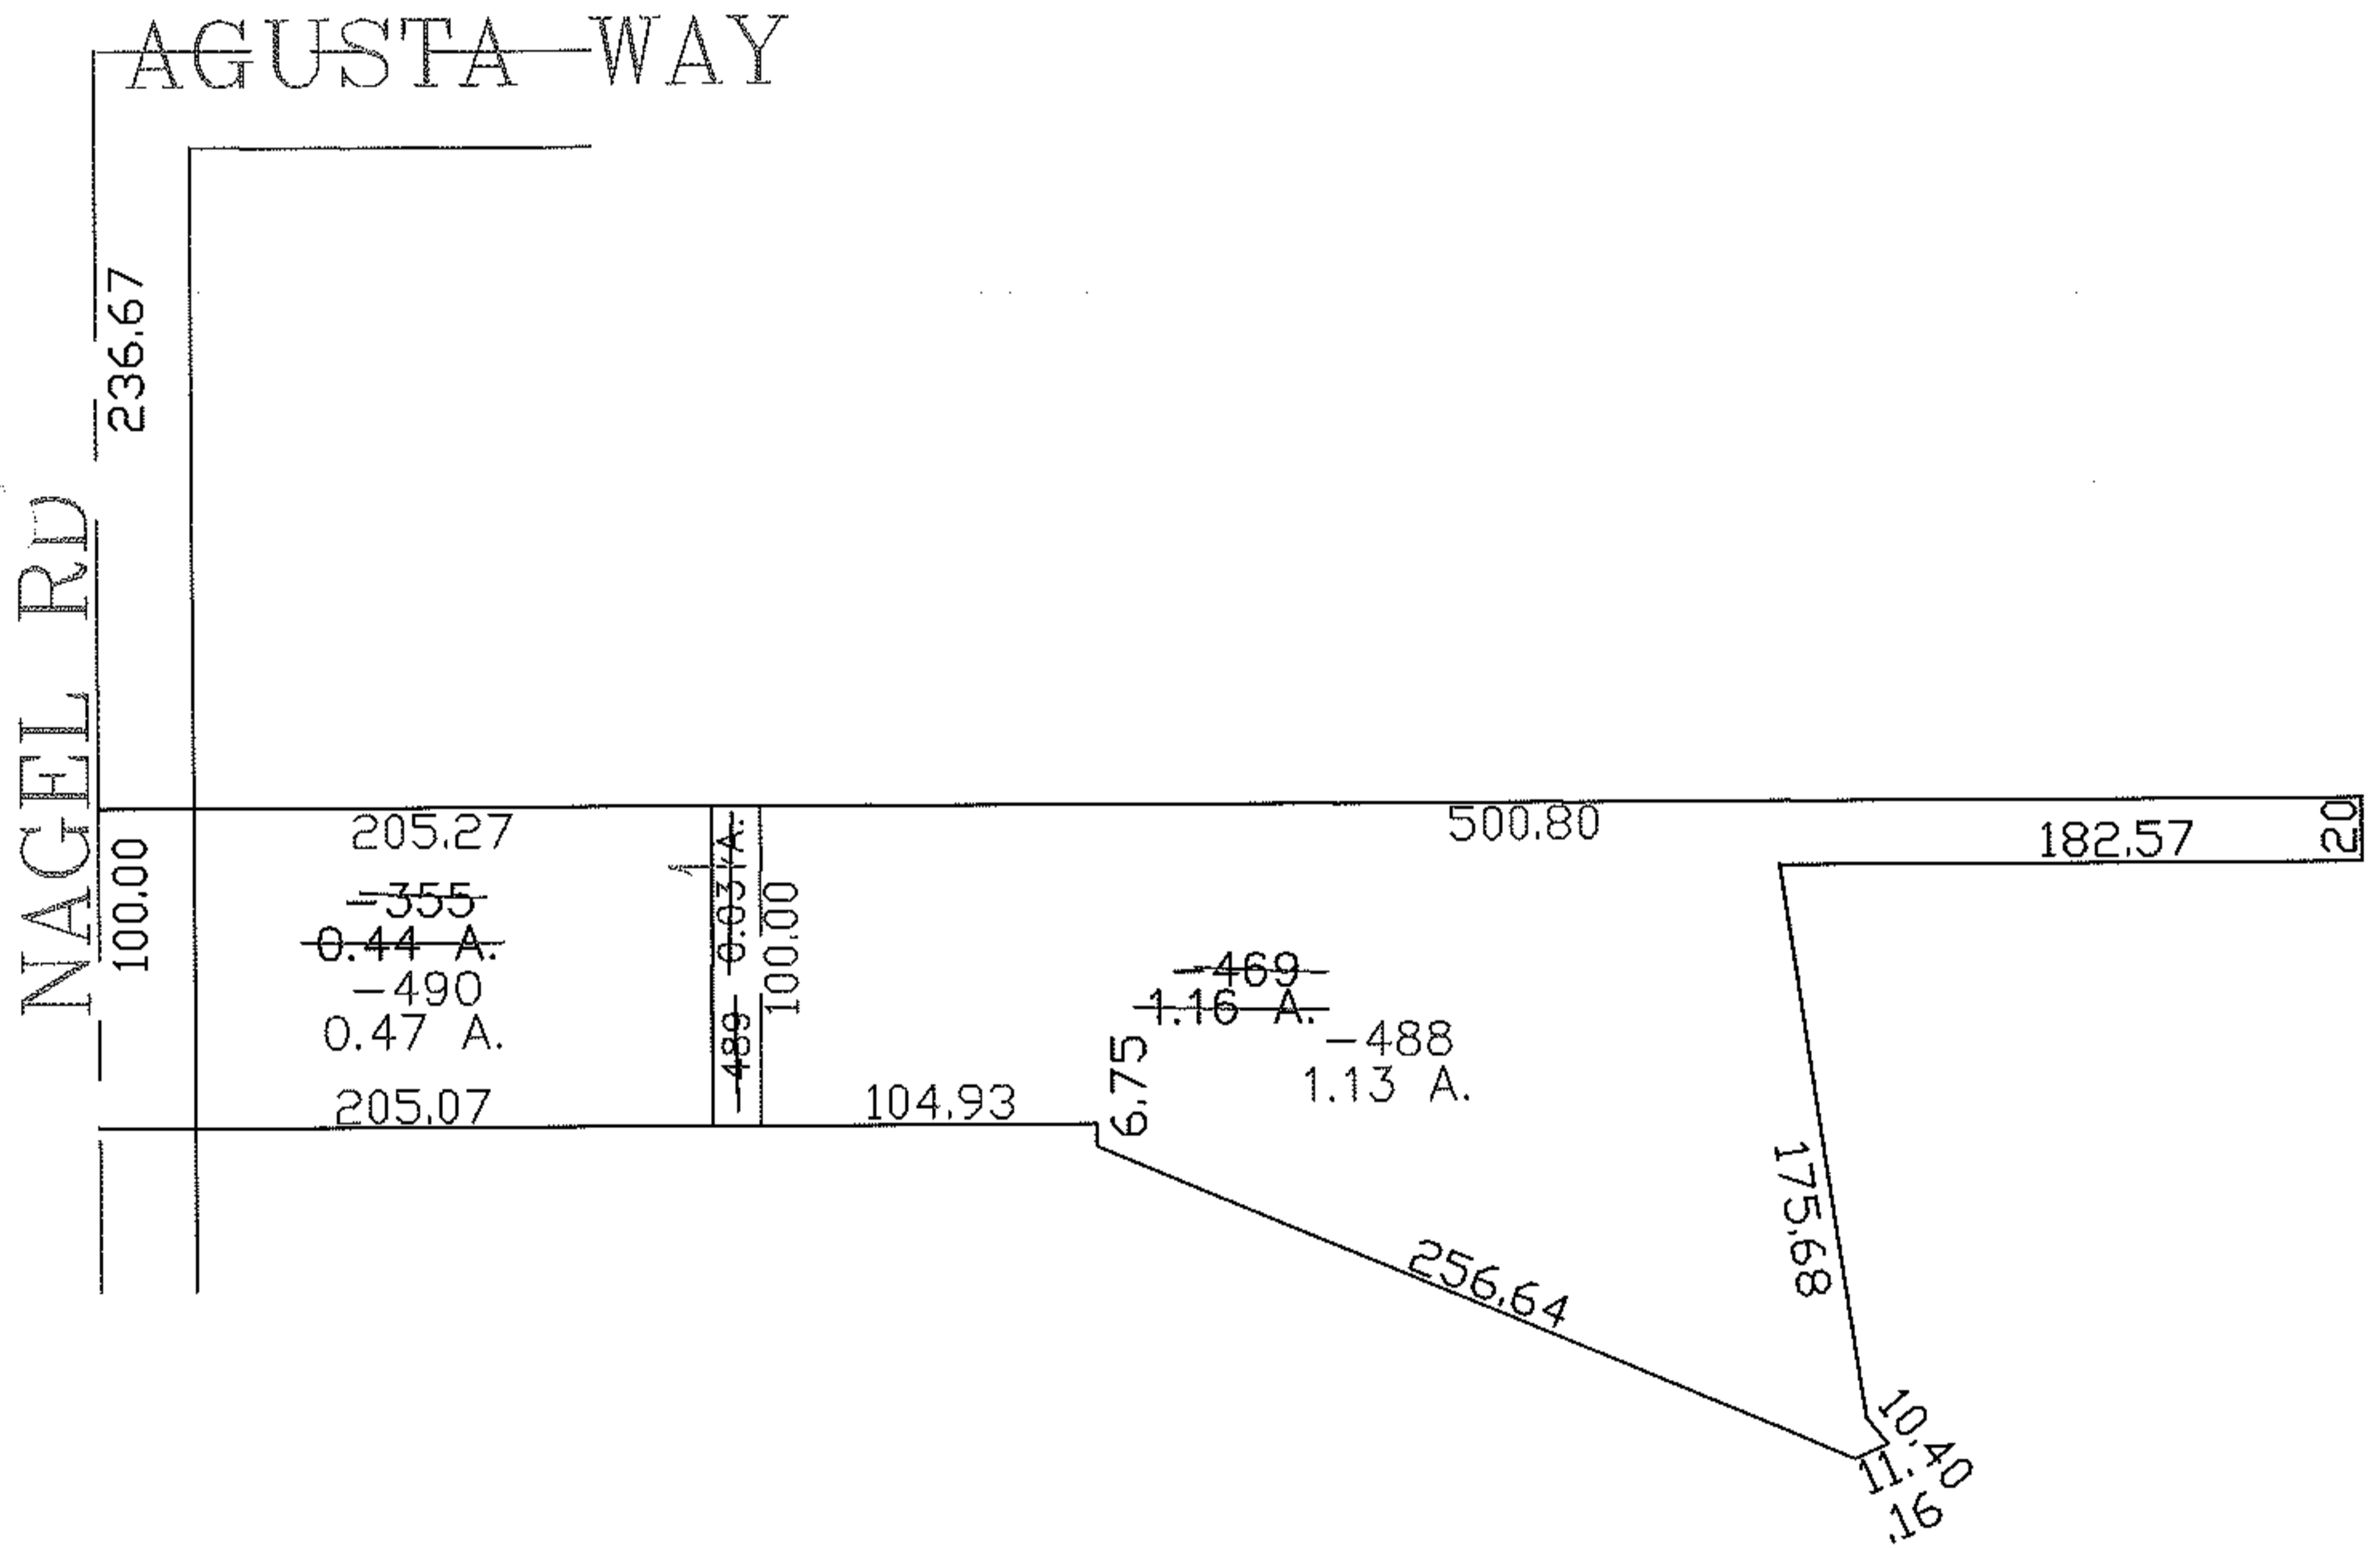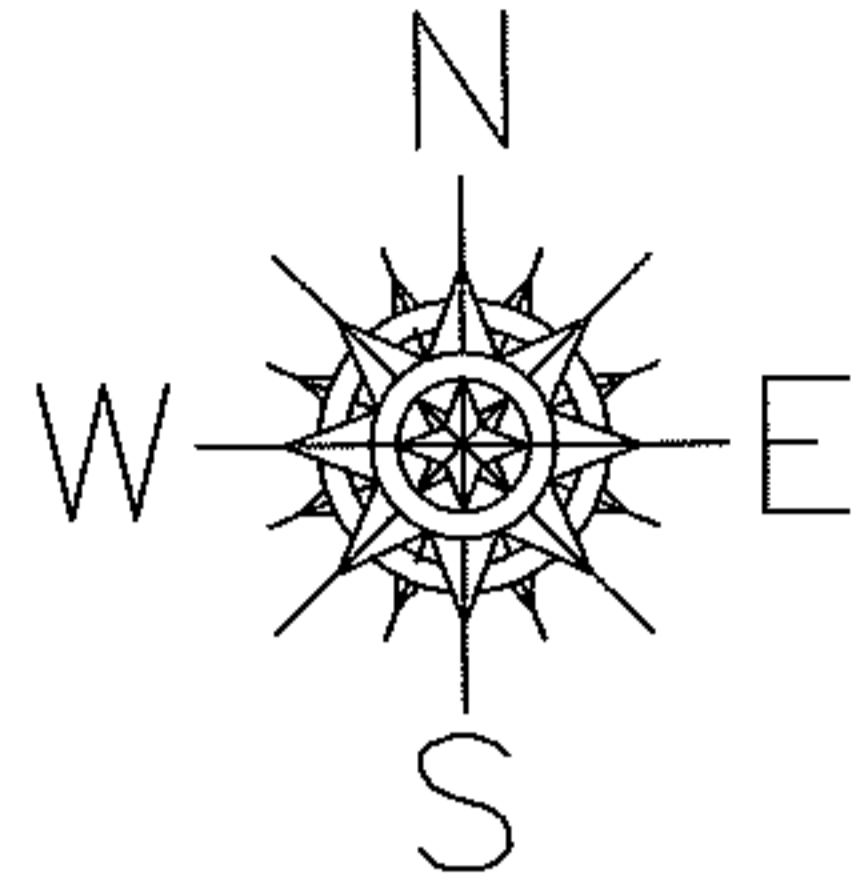

SPLITS/DEEDS PROCESSED

LORAIN COUNTY TAX MAP DEPARTMENT
226 MIDDLE AVE. ELYRIA, OHIO

SURVEYED BY: MICHAEL SPELLACY

CLOSURE: 0.00 : 10,000

MAP PAGE(S): 04-00-025-A

APPROVED BY: JAH DATE: 7-7-08

SCALE: 1" = 100 PRIOR INSTRUMENT: PL VL 56/27