
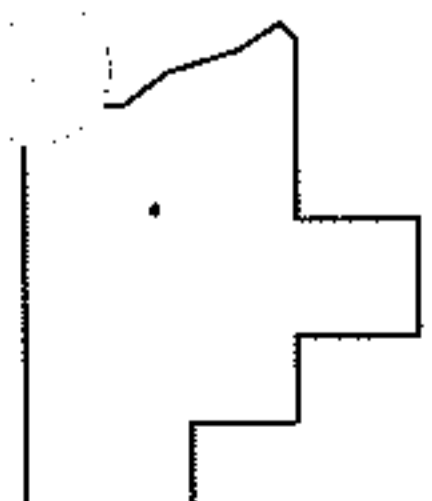
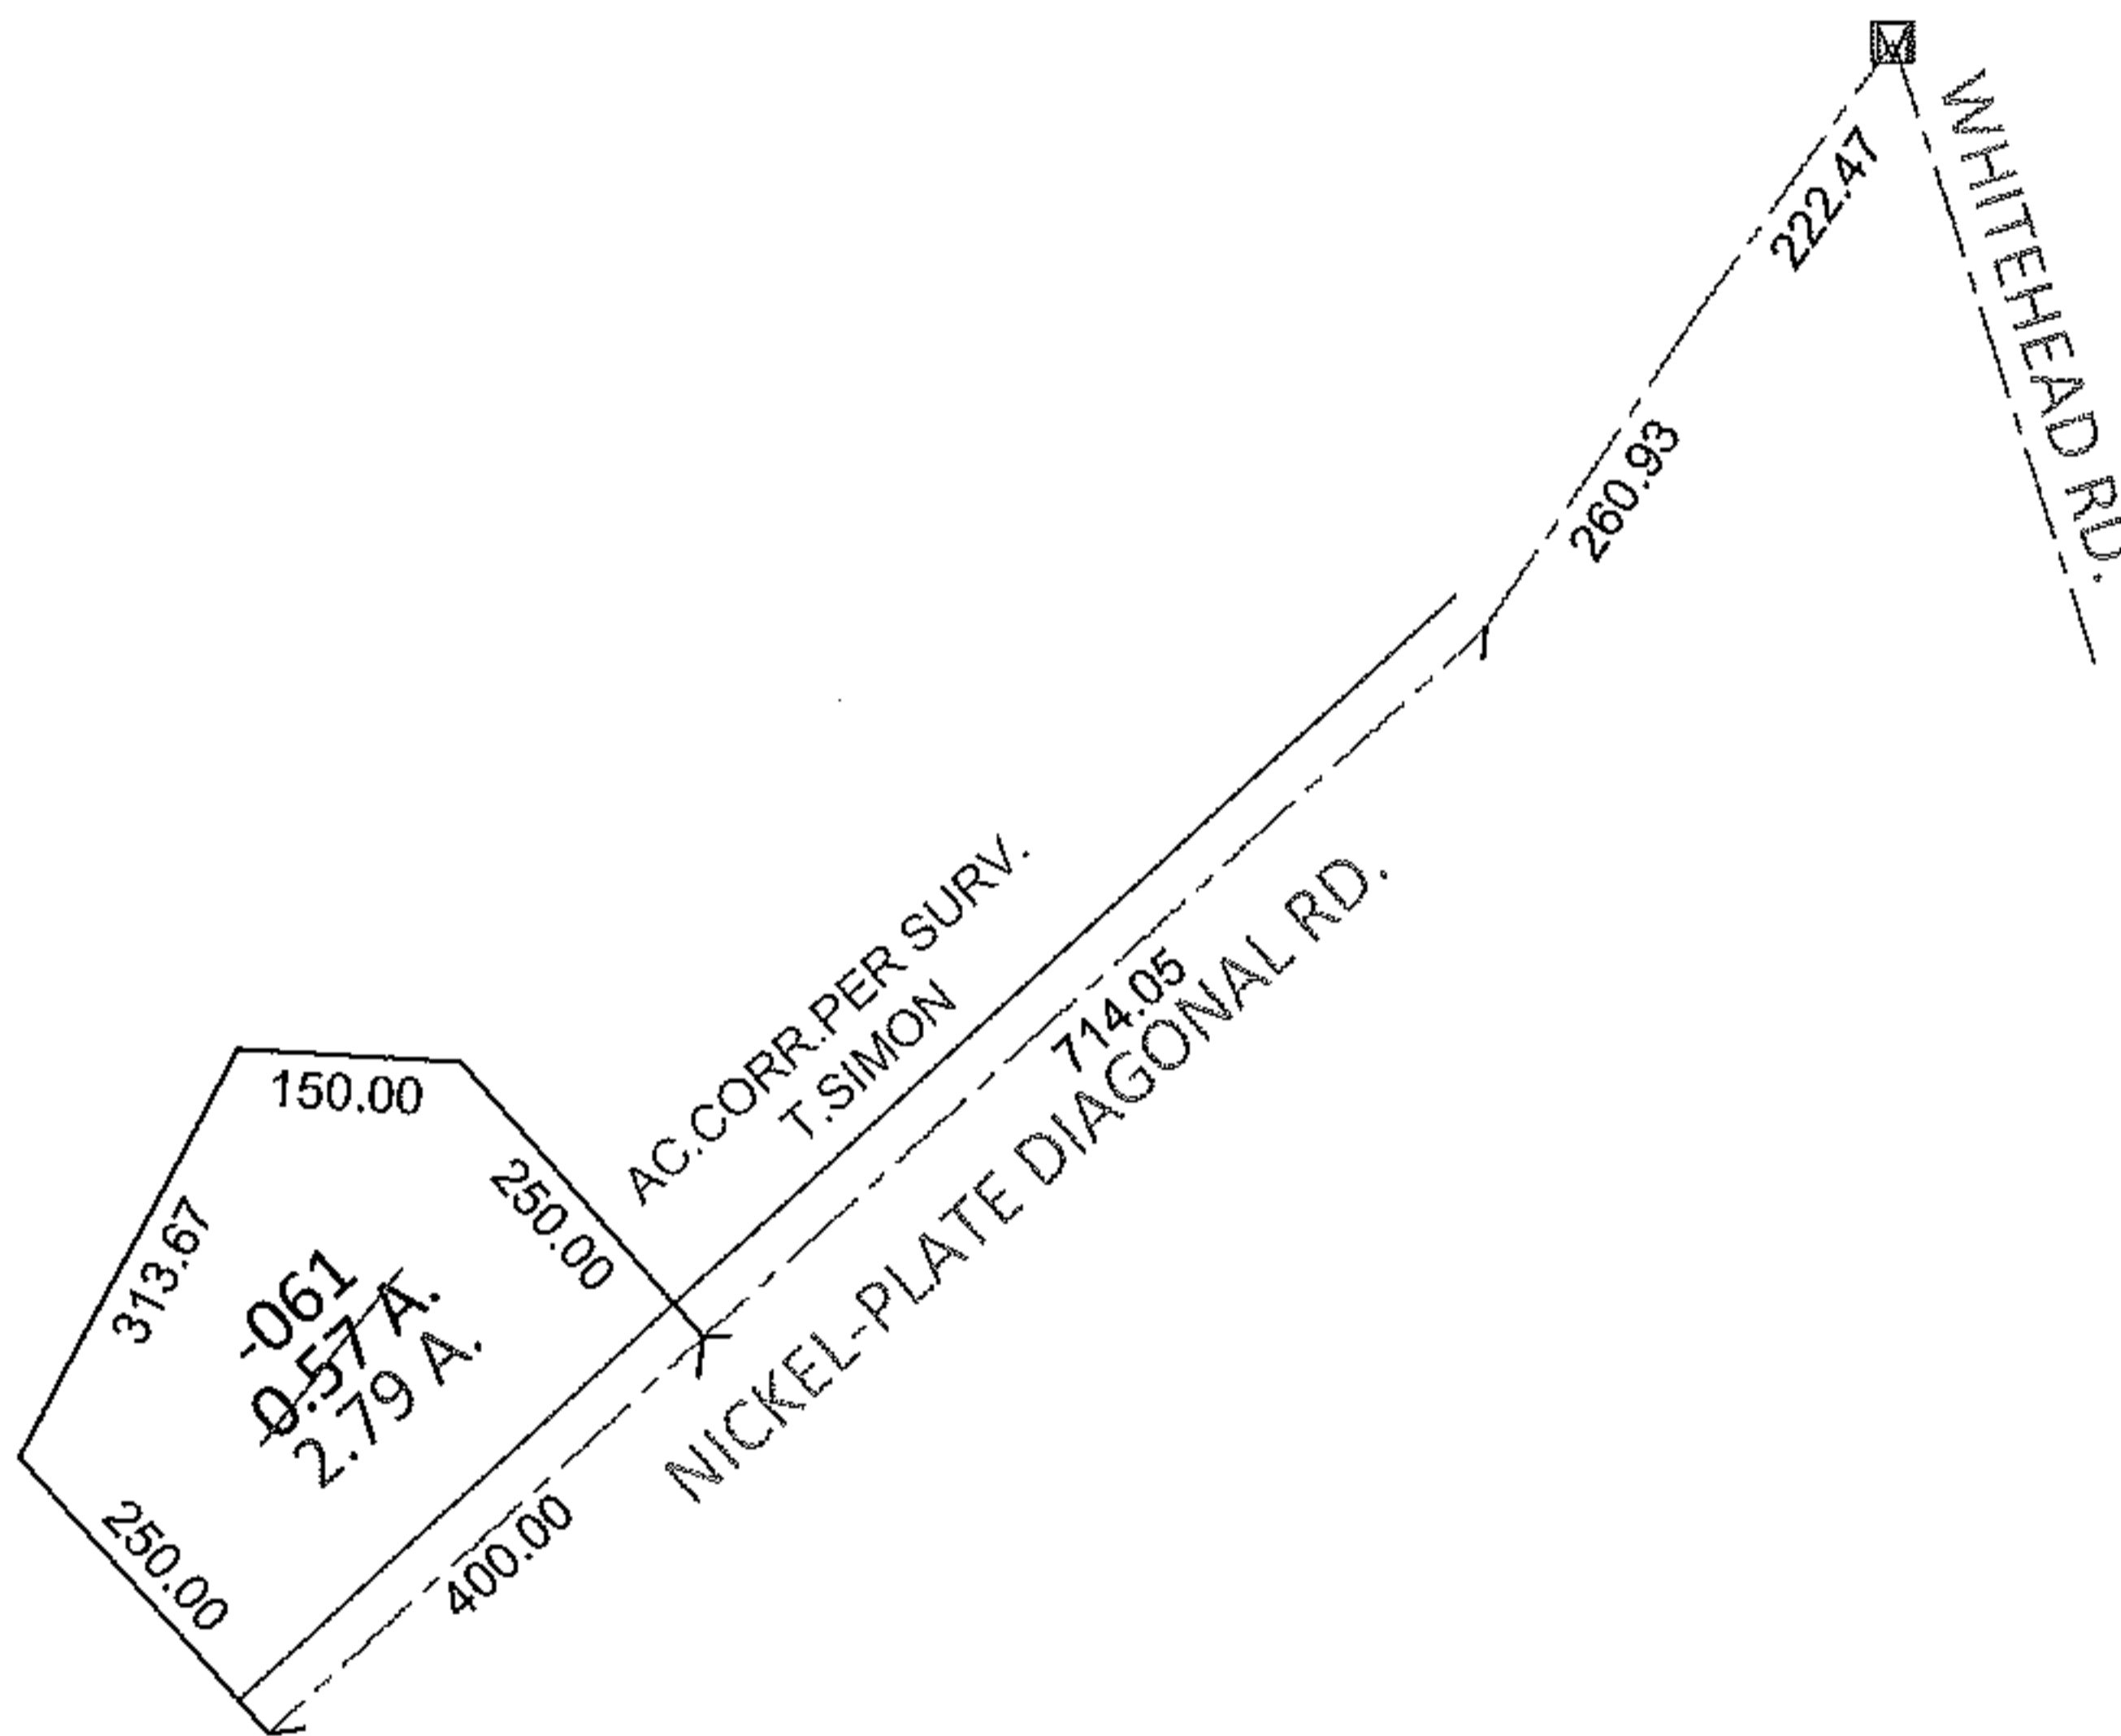


PARENT PARCEL: 10-00-019-000-061

12-02585-C

CHILD PARCEL: _____

STARTING POINT: AT A MON BOX AT THE INTERSECTION OF C/L OF NICKEL-PLATE DIAGONAL RD. AND C/L OF WHITEHEAD RD.

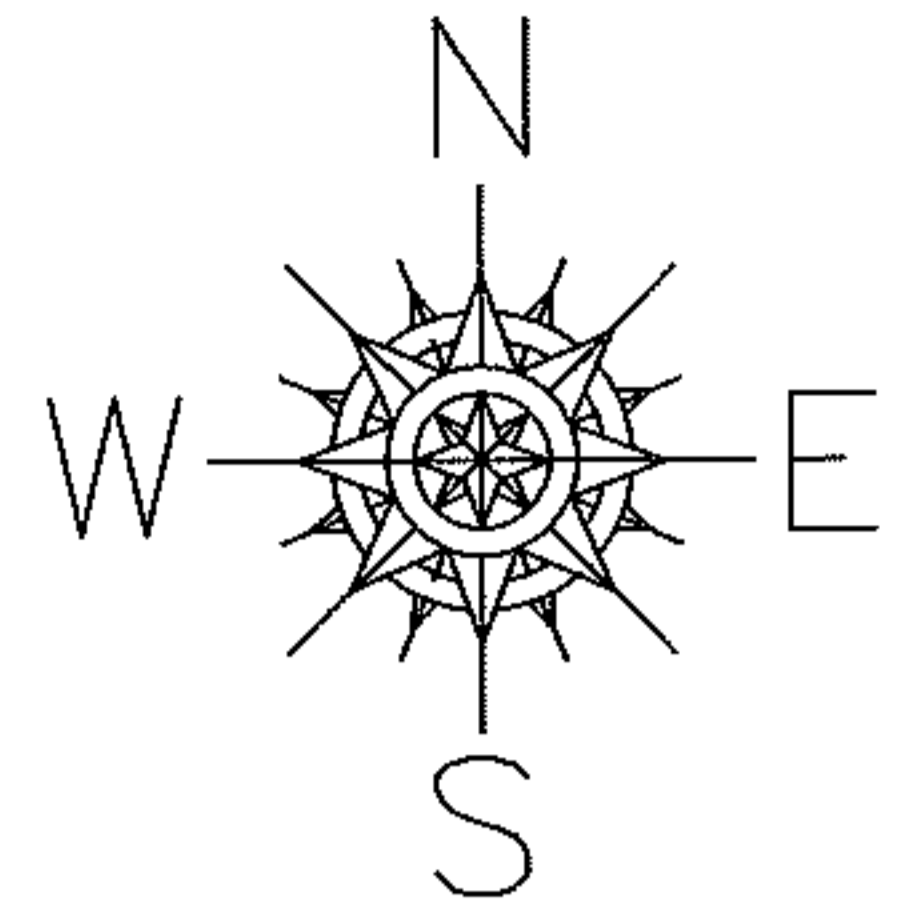

SPLITS/DEEDS PROCESSED

LORAIN COUNTY TAX MAP DEPARTMENT
226 MIDDLE AVE. ELYRIA, OHIO

SURVEYED BY: THOMAS A. SIMON

CLOSURE: .01:10,000

MAP PAGE(S): 10-F

APPROVED BY: RRM DATE: 9-18-12

SCALE: 1"= 300 PRIOR INST.: OR 318/799