
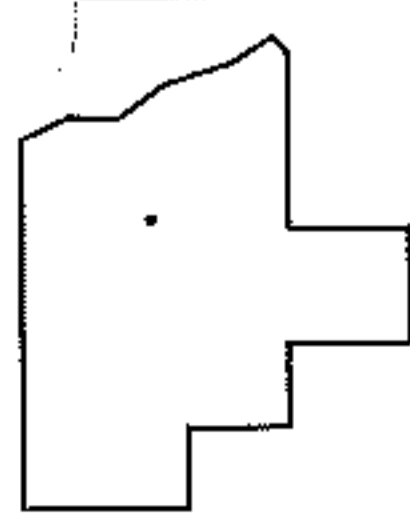
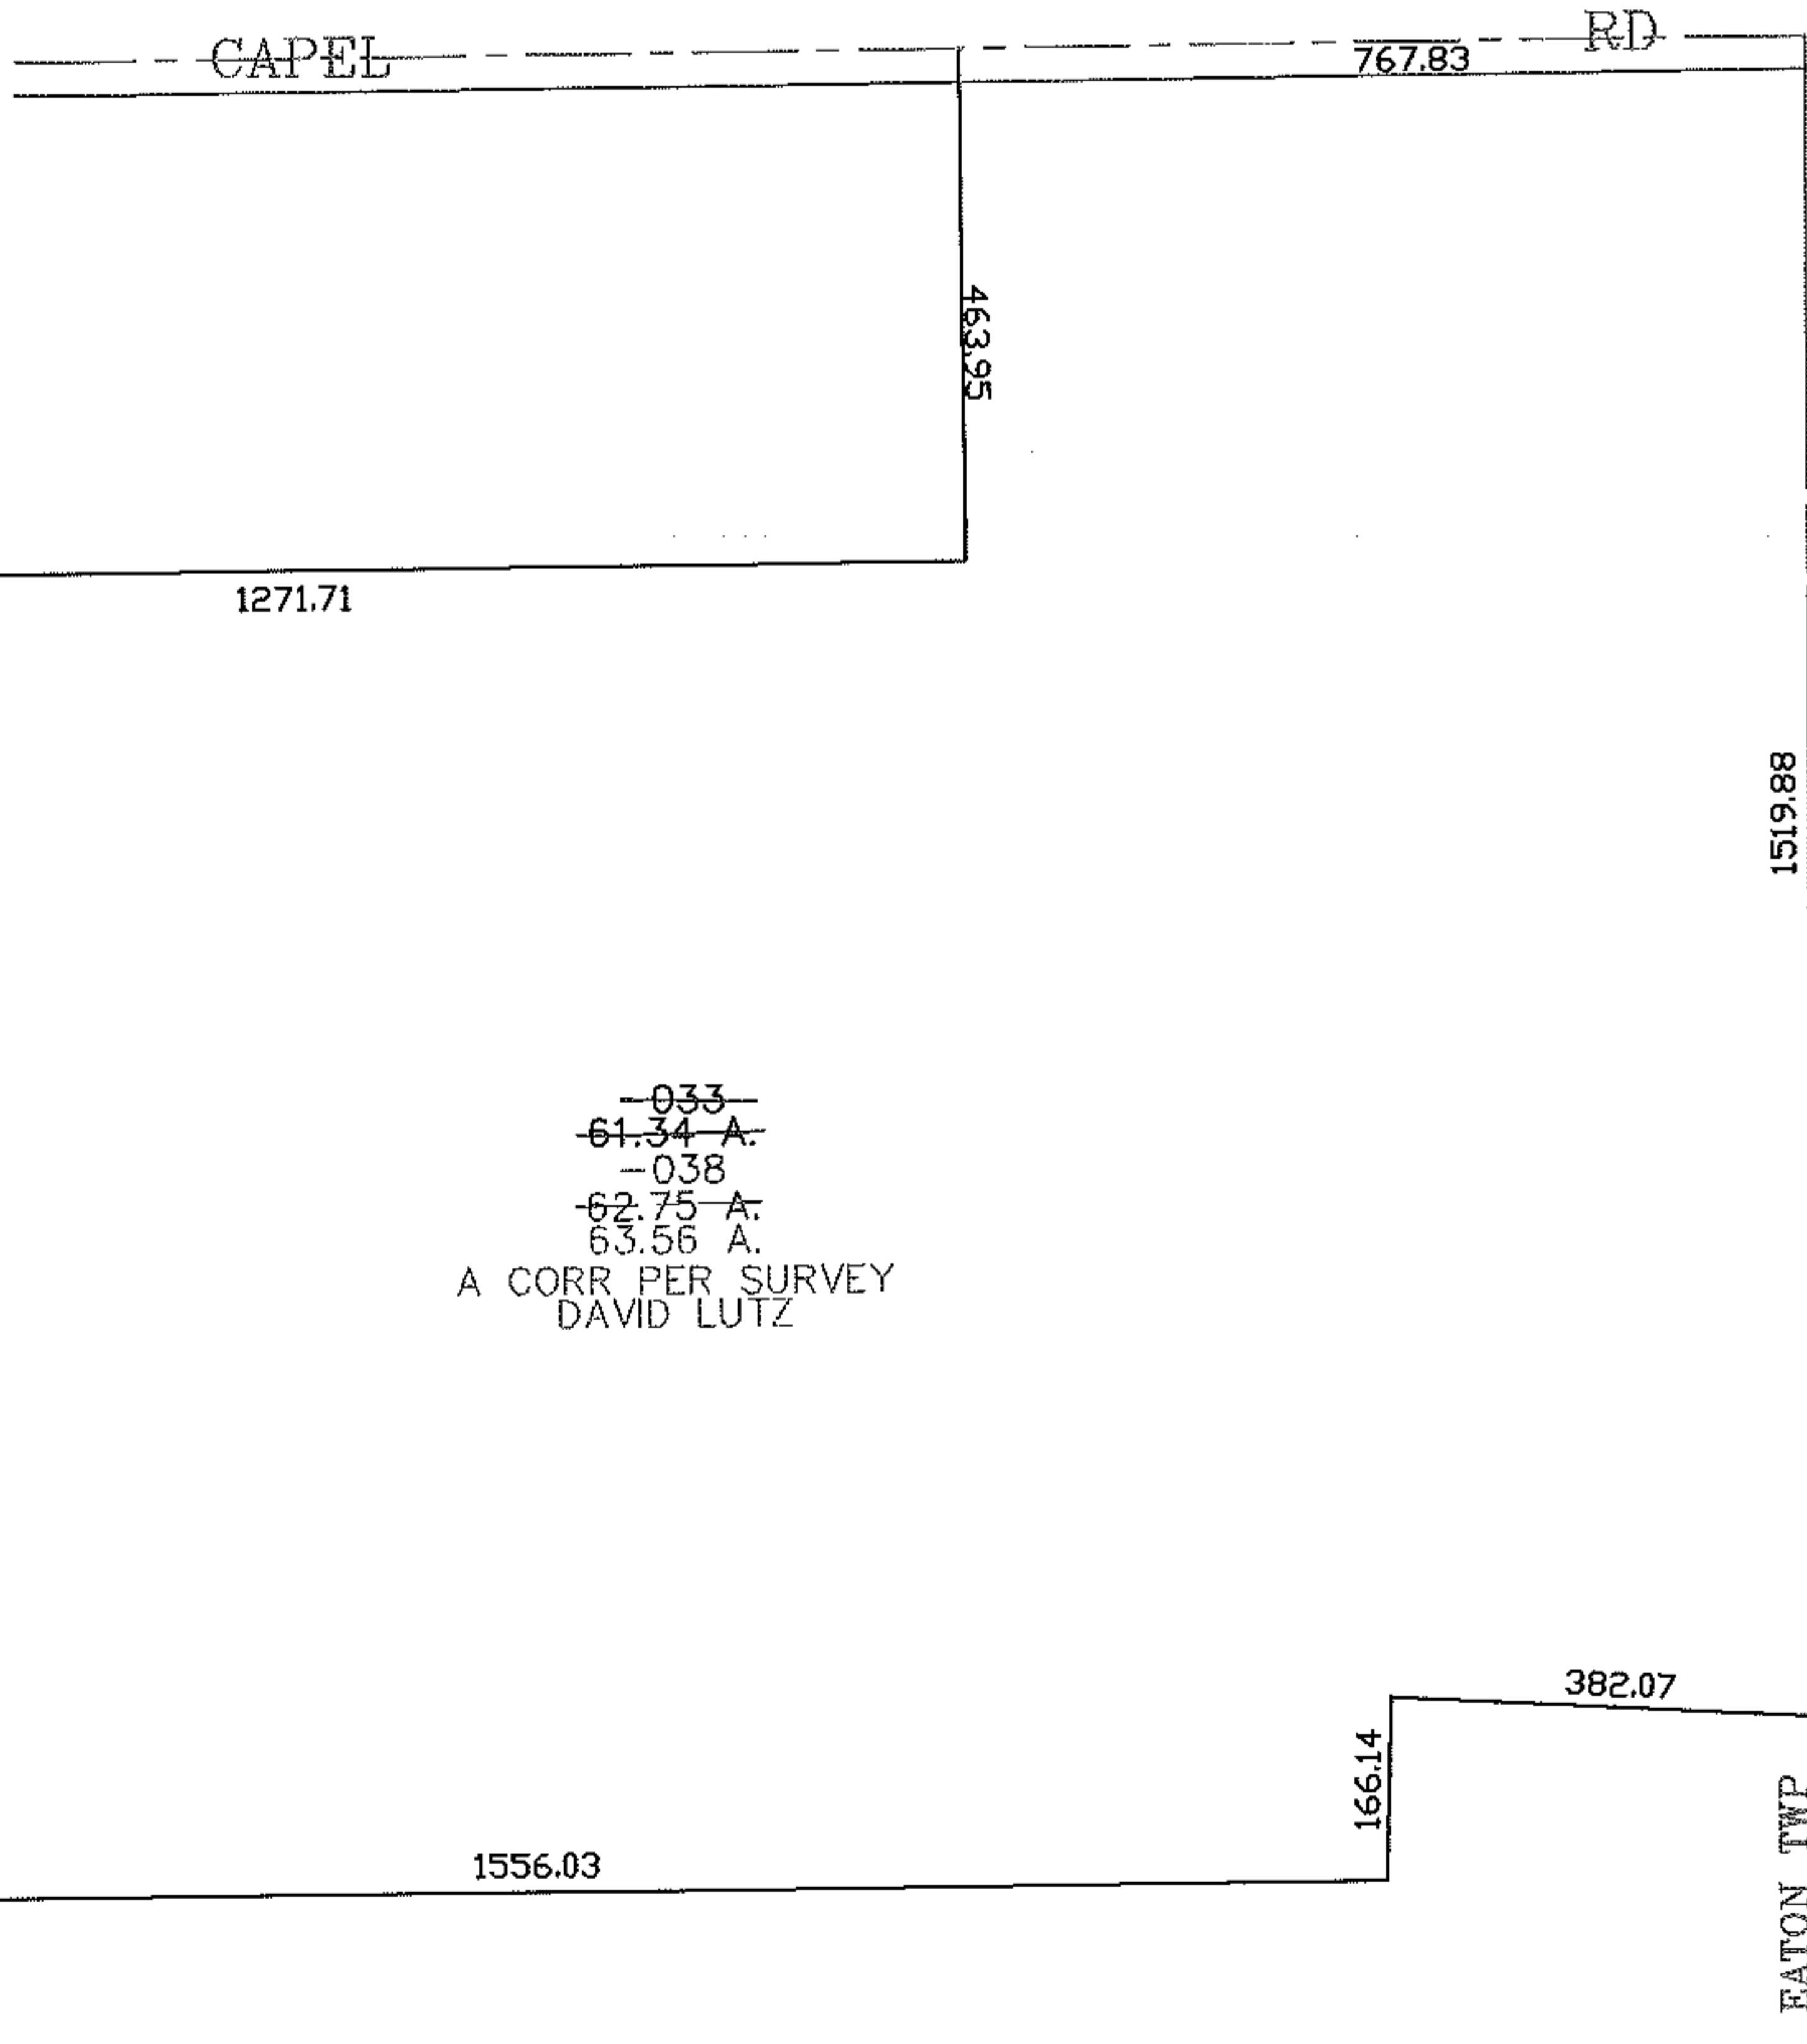


PARENT PARCEL: 11-00-003-000-036, -033
CHILD PARCEL: 11-00-003-000-038
STARTING POINT: CENTERLINE OF CAPEL RD & TWP LINE OF EATON TWP & COLUMBIA TWP

08-02585

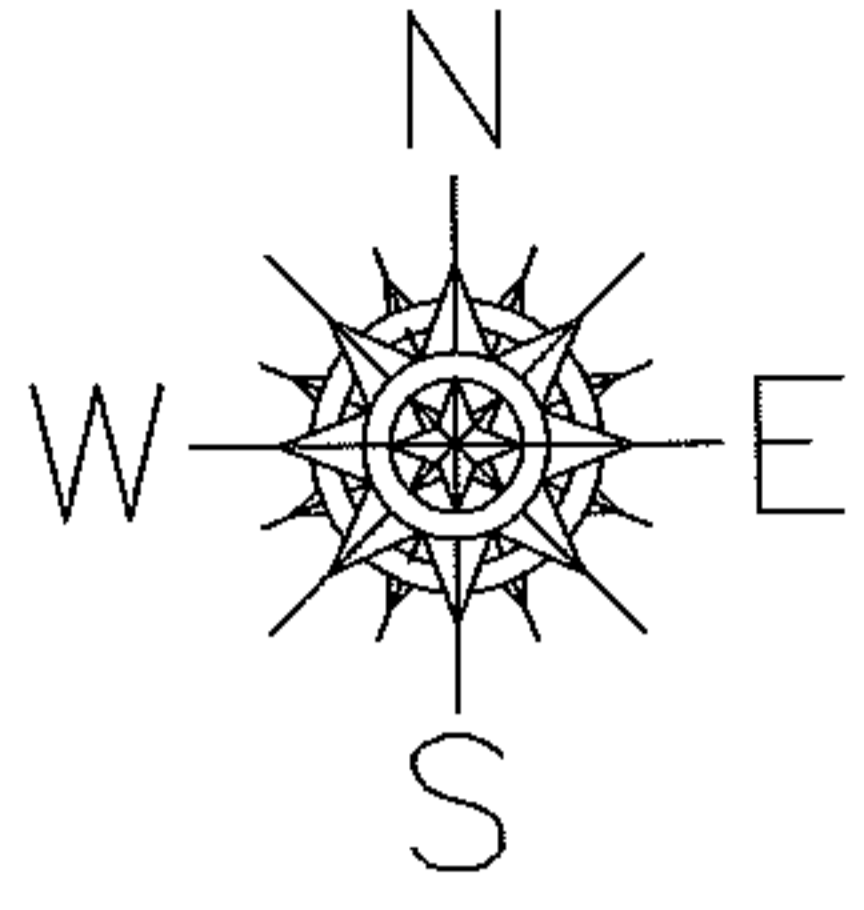

SPLITS/DEEDS PROCESSED
LORAIN COUNTY TAX MAP DEPARTMENT
226 MIDDLE AVE. ELYRIA, OHIO

SURVEYED BY: DAVID E LUTZ
CLOSURE: 0.00 : 10.000'
MAP PAGE(S): 11-00-003-B
APPROVED BY: JAH DATE: 7-8-08
SCALE: 1" = 300' PRIOR INSTRUMENT: 20080256871