


PARENT PARCEL: 10-00-013-000-019



CHILD PARCEL: _____

12-02586-D

STARTING POINT: INTERSECTION OF C/L OF NICKEL-PLATE DIAGONAL RD. AND C/L OF S.R.301

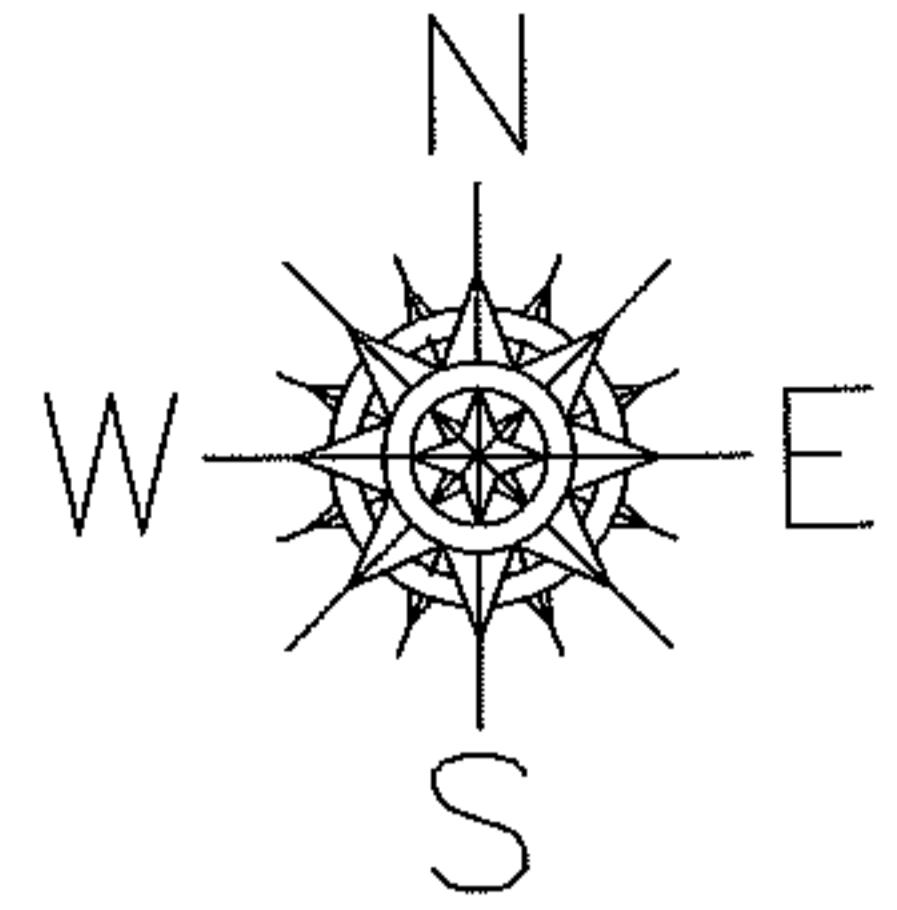

MAP CORRECTION ONLY
PER SURV. D.HAYWOOD

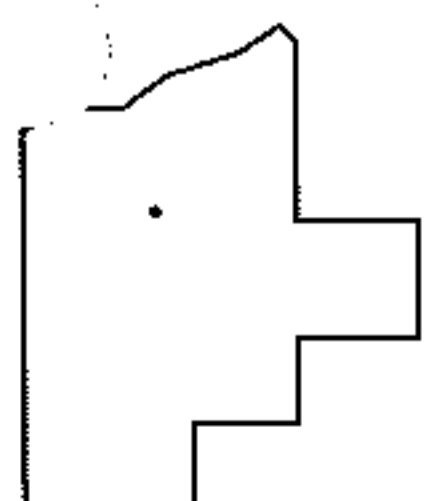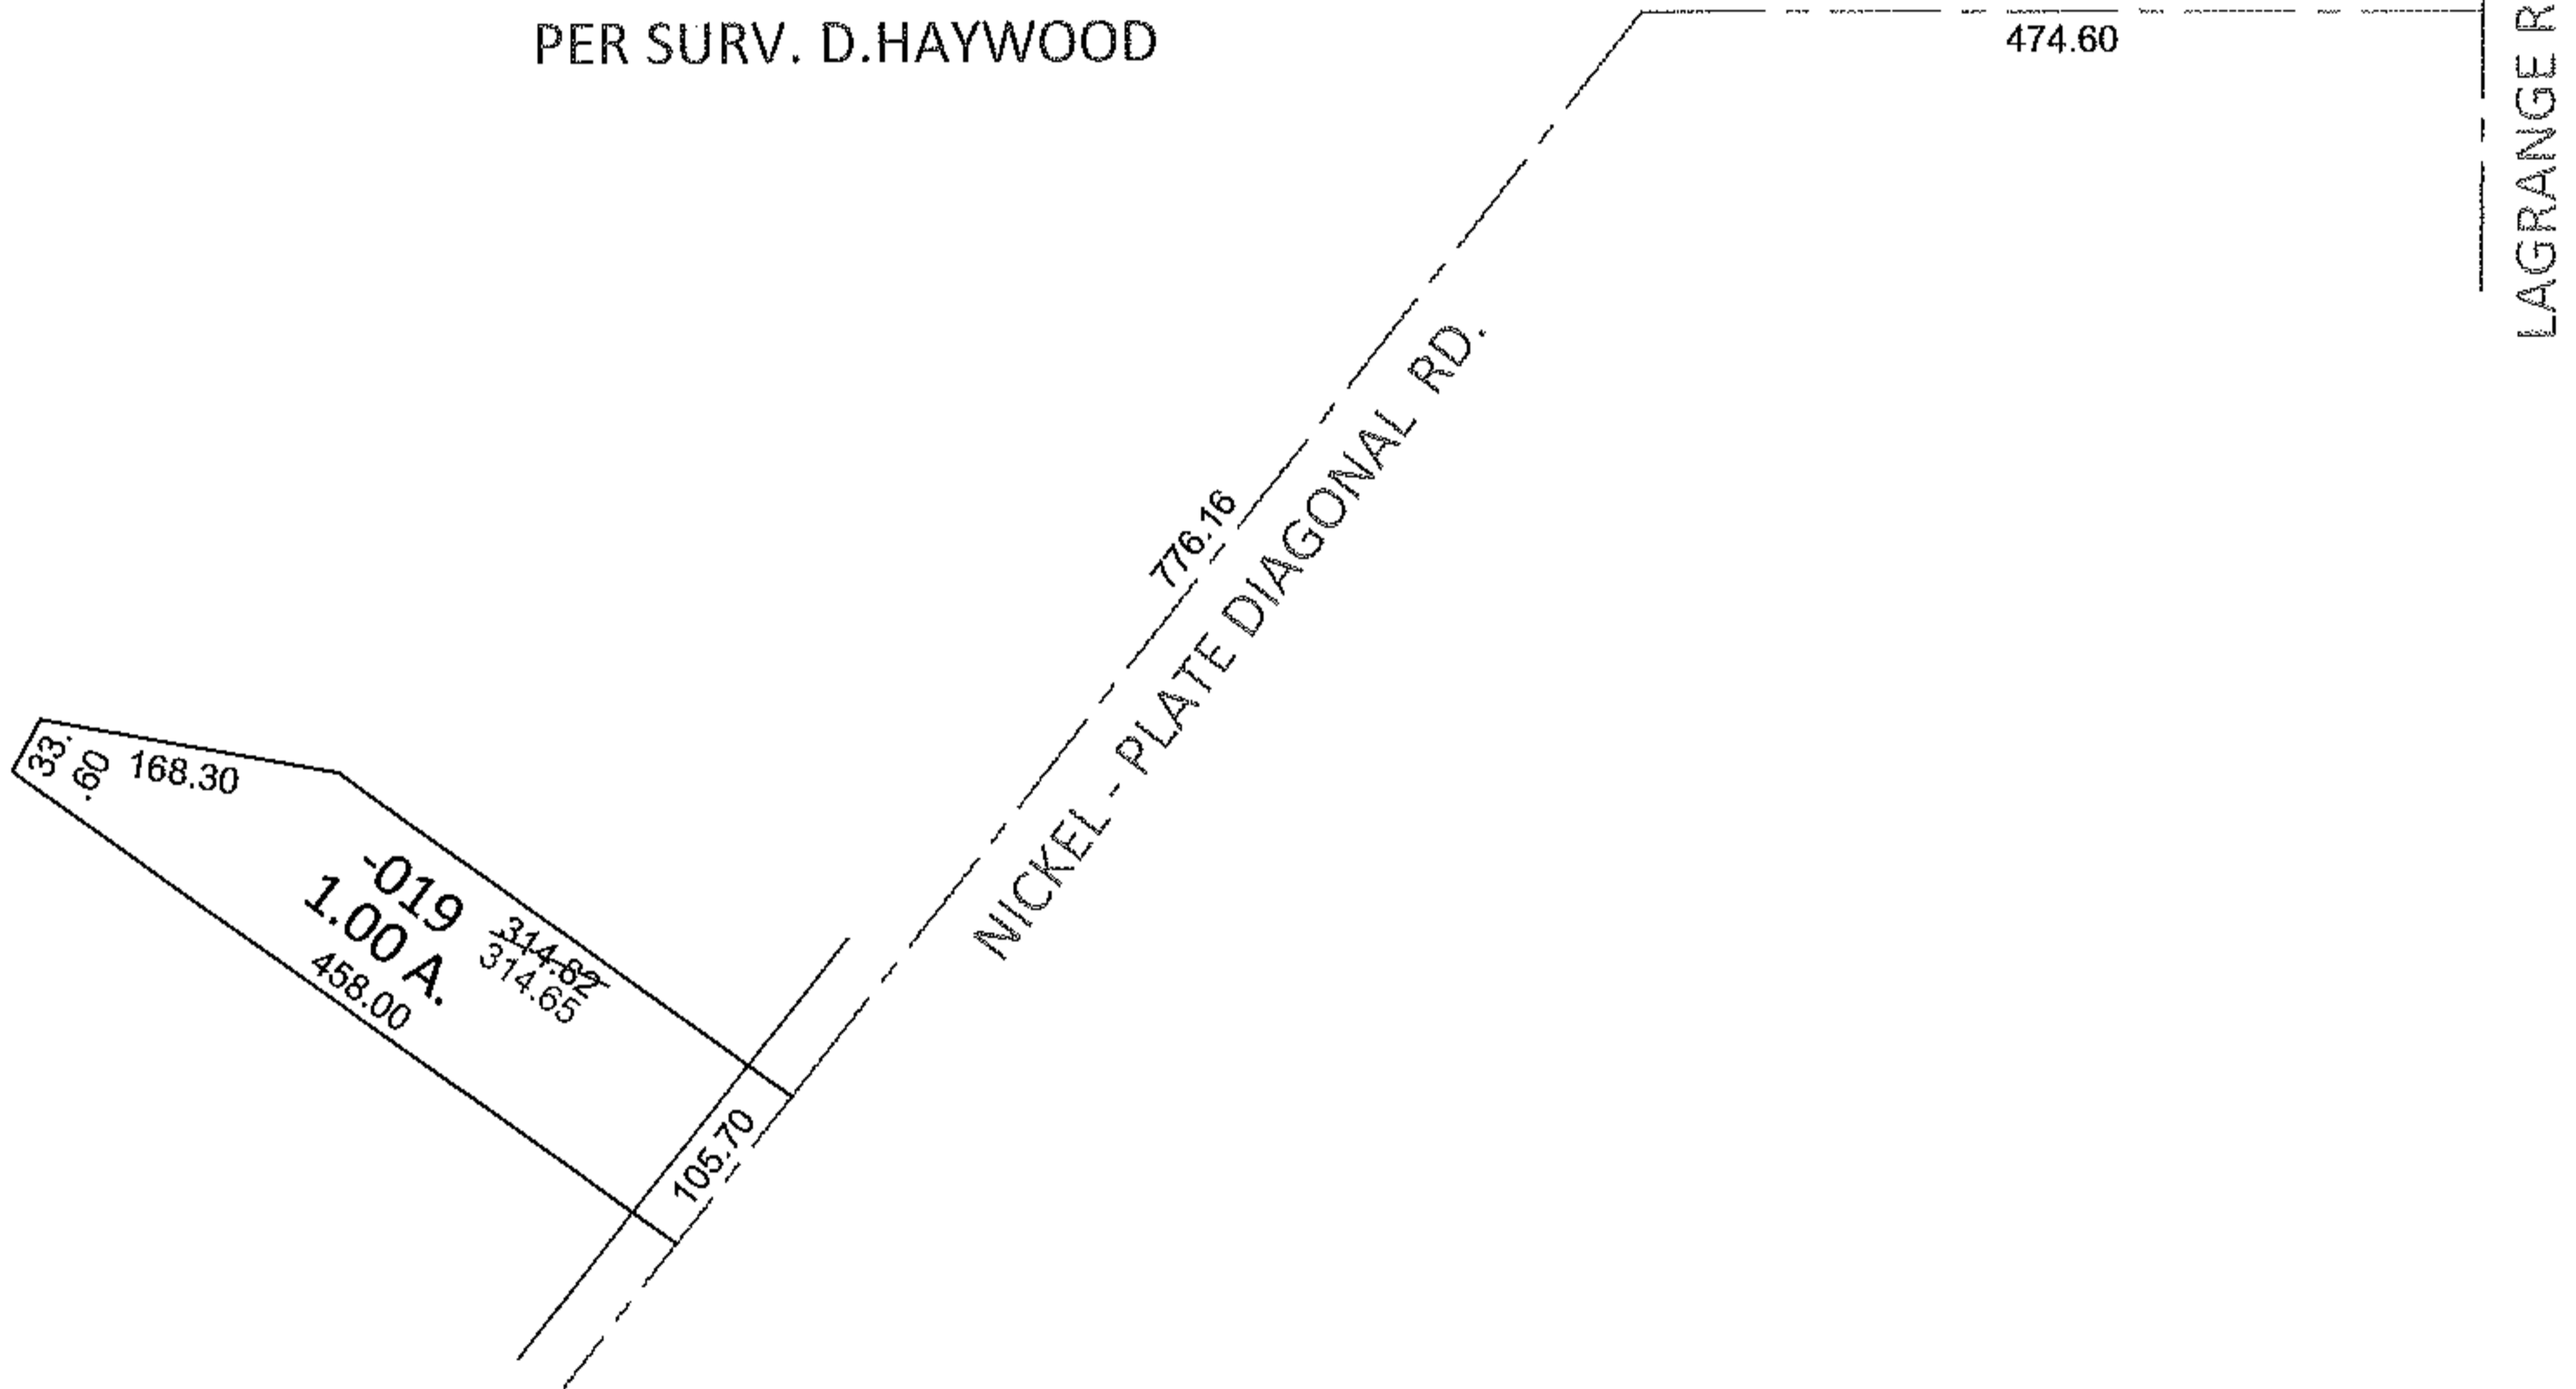

SPLITS/DEEDS PROCESSED

LORAIN COUNTY TAX MAP DEPARTMENT
226 MIDDLE AVE. ELYRIA, OHIO

SURVEYED BY: DALE R. HAYWOOD

CLOSURE: .01:10,000

MAP PAGE(S): 10-00-013-F

APPROVED BY: RRM DATE: 9-18-12

SCALE: 1"= 200 PRIOR INST.: 20110386308