



RASTER

PARENT PARCEL: 01-00-056-000-085

CHILD PARCEL: 01-00-056-000-086, -087


STARTING POINT: CENTERLINE OF RICE RD & O.L. 56

08-02589

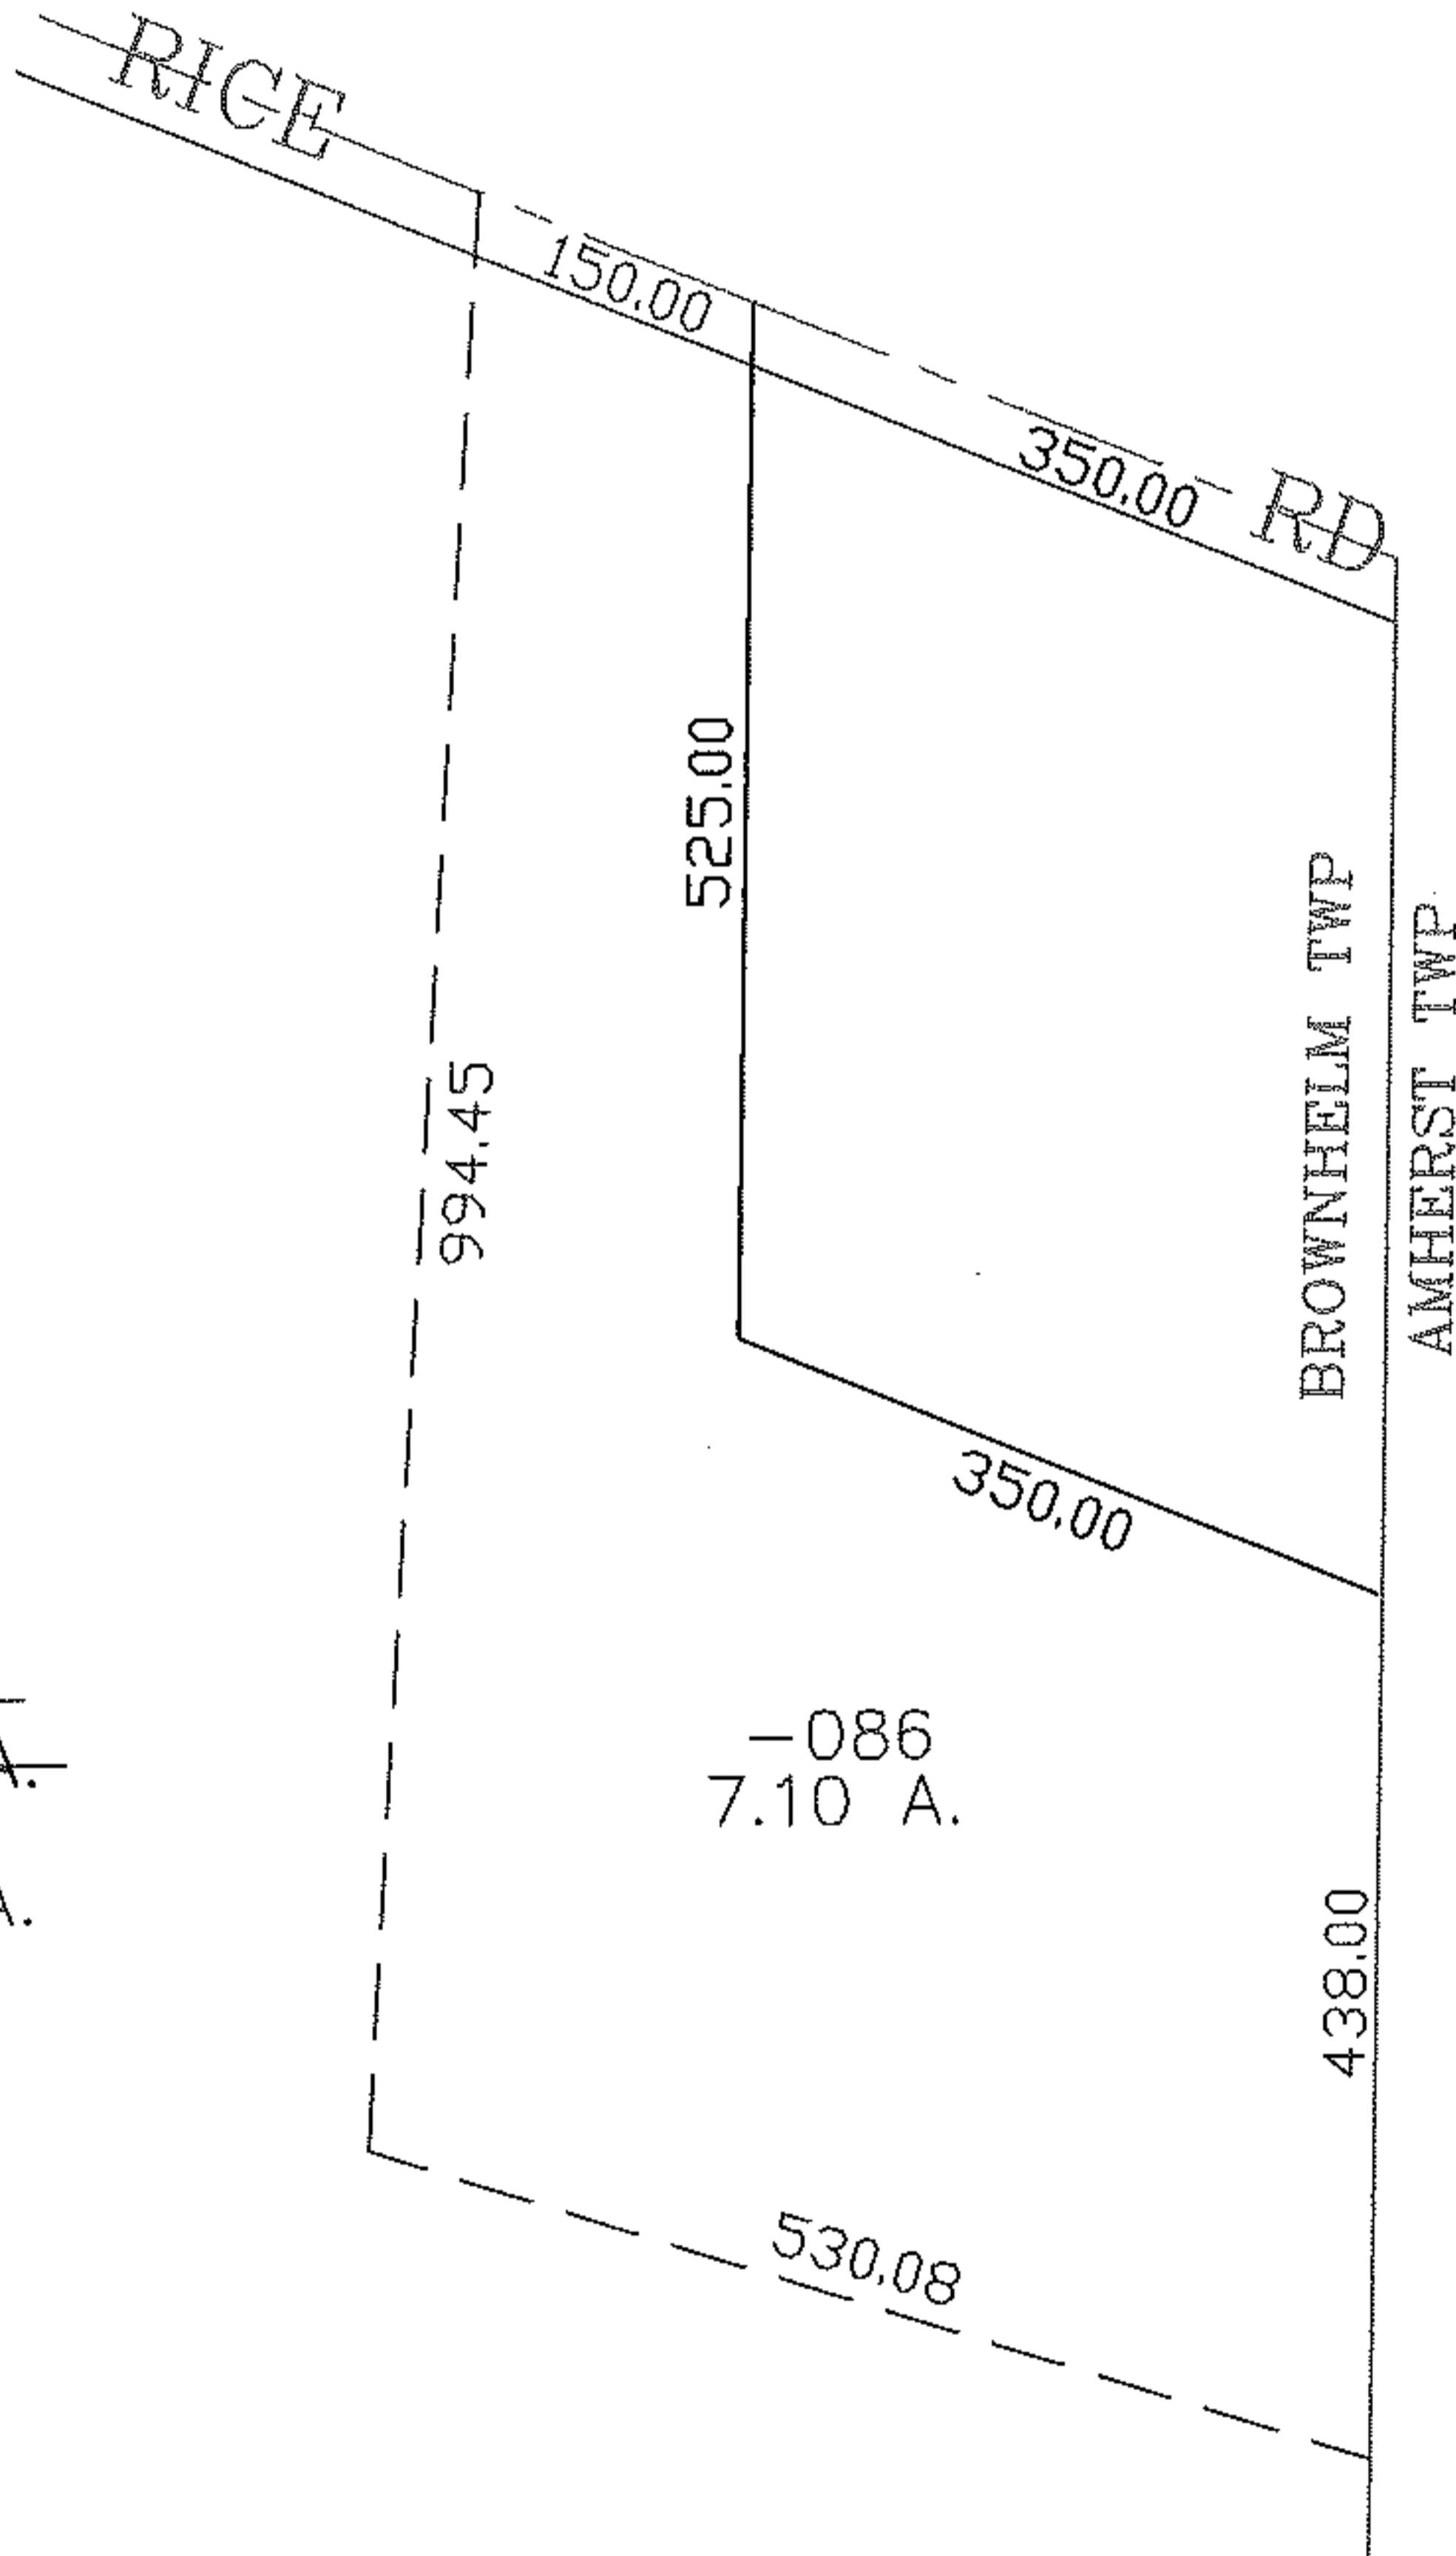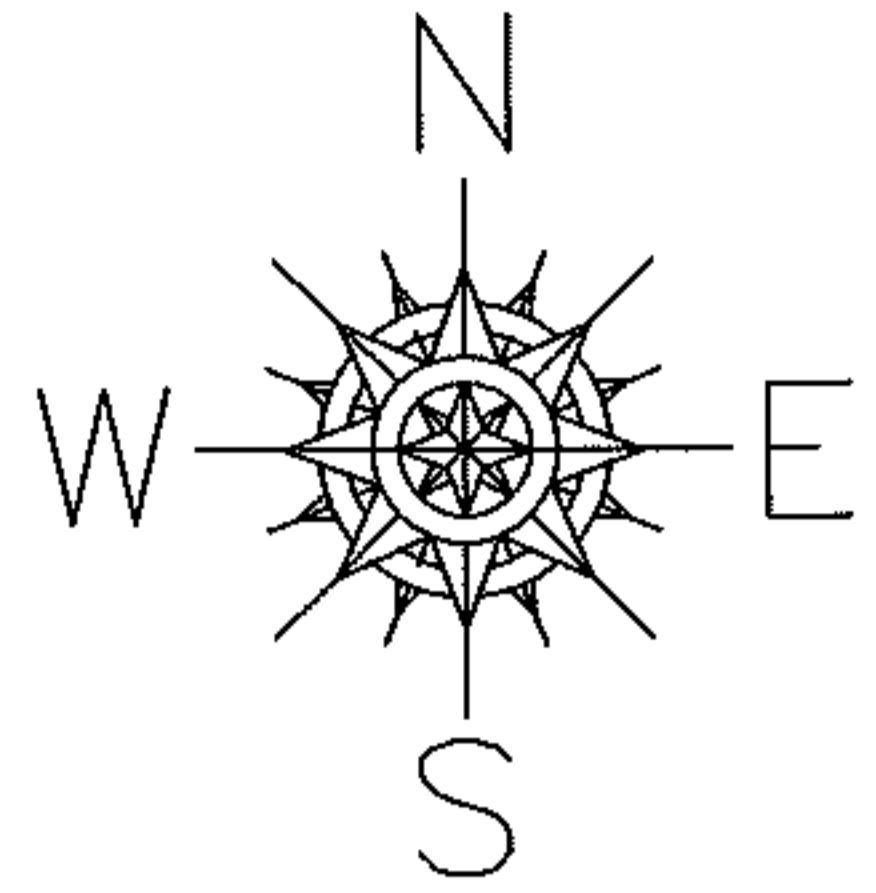

~~085~~  
49.79 A.  
~~087~~  
42.69 A.

-086  
7.10 A.

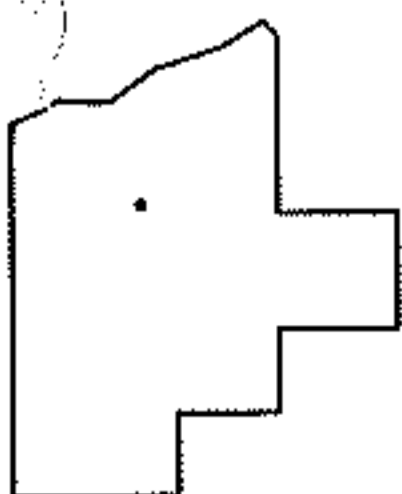

**SPLITS/DEEDS PROCESSED**  
LORAIN COUNTY TAX MAP DEPARTMENT  
226 MIDDLE AVE. ELYRIA, OHIO

SURVEYED BY: THOMAS SIMON  
CLOSURE: 0.00 : 10.000  
MAP PAGE(S): 1-L  
APPROVED BY: JAH DATE: 7-22-08  
SCALE: 1" = 200 PRIOR INSTRUMENT: 19990627543