
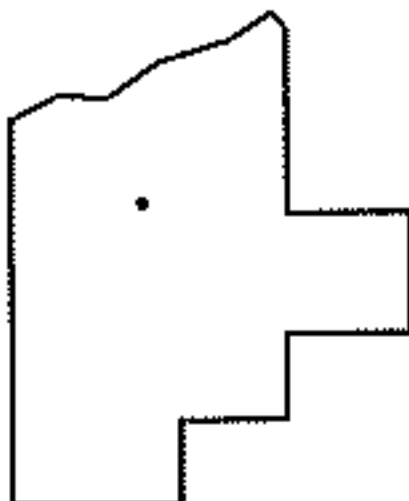
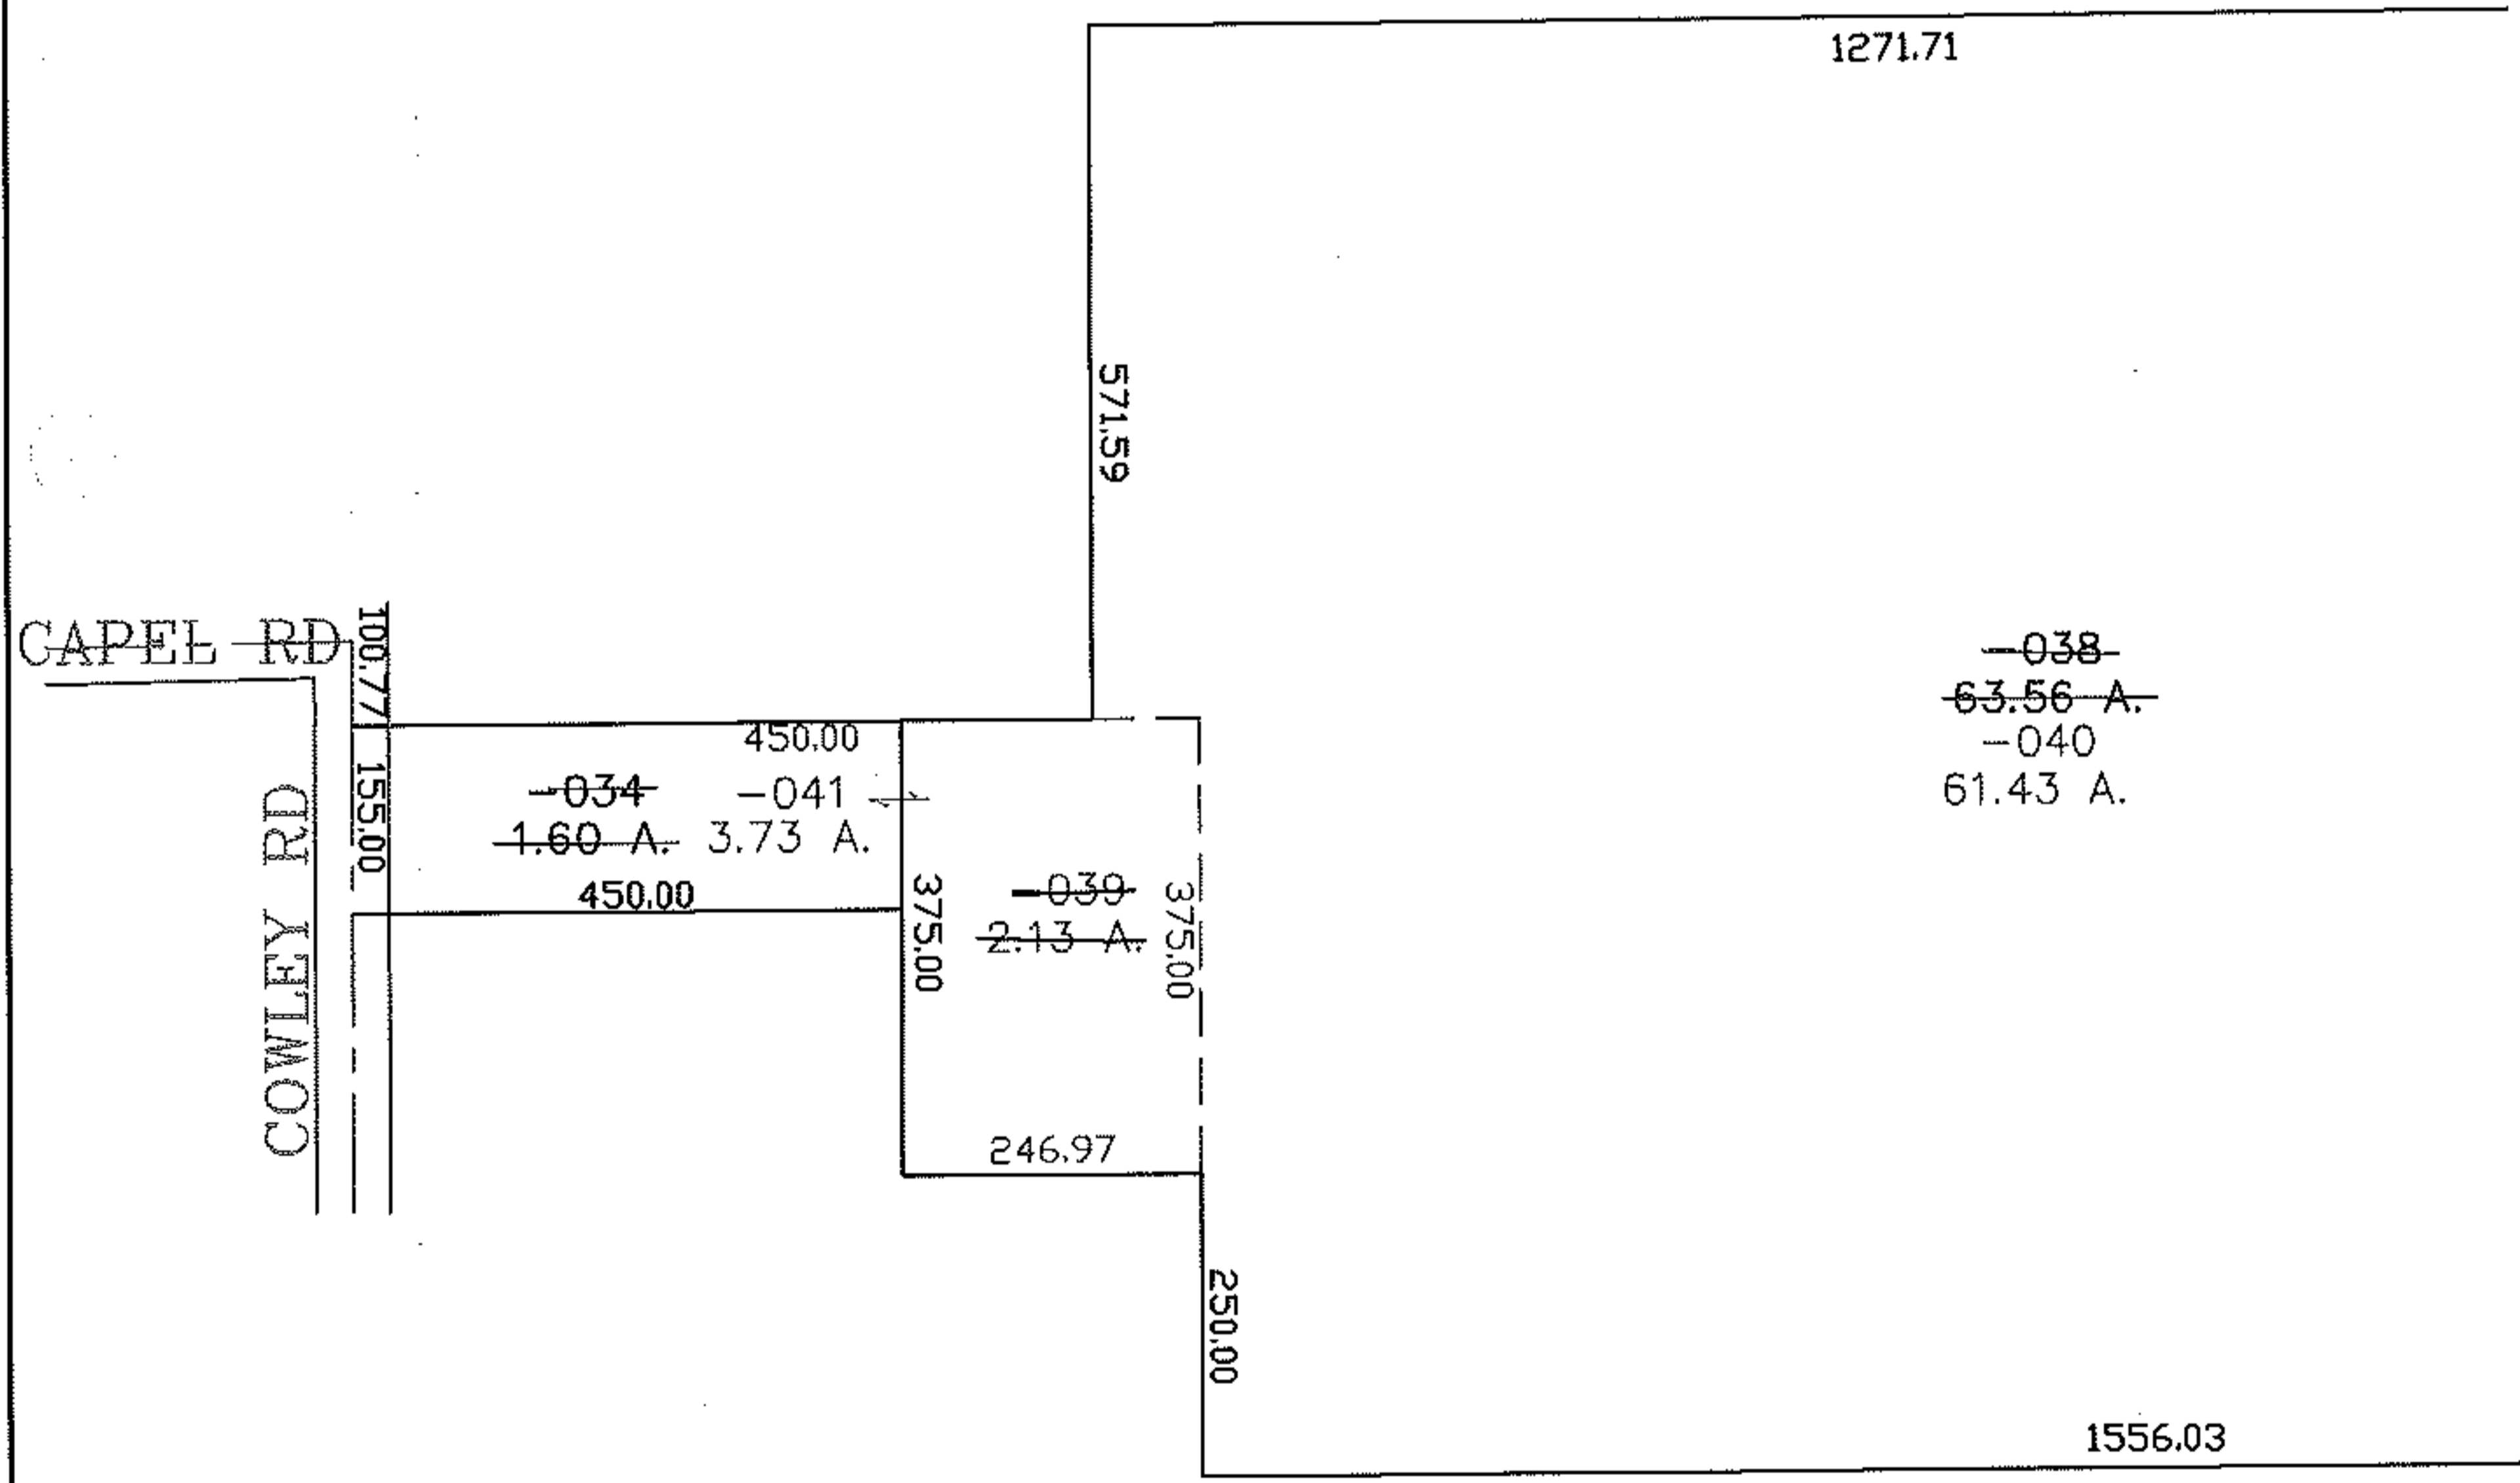


PARENT PARCEL: 11-00-003-000-034, -038

CHILD PARCEL: 11-00-003-000-039 THRU -041

STARTING POINT: CENTERLINE OF CAPEL RD & TWP LINE OF EATON TWP & COLUMBIA TWP

08-02590

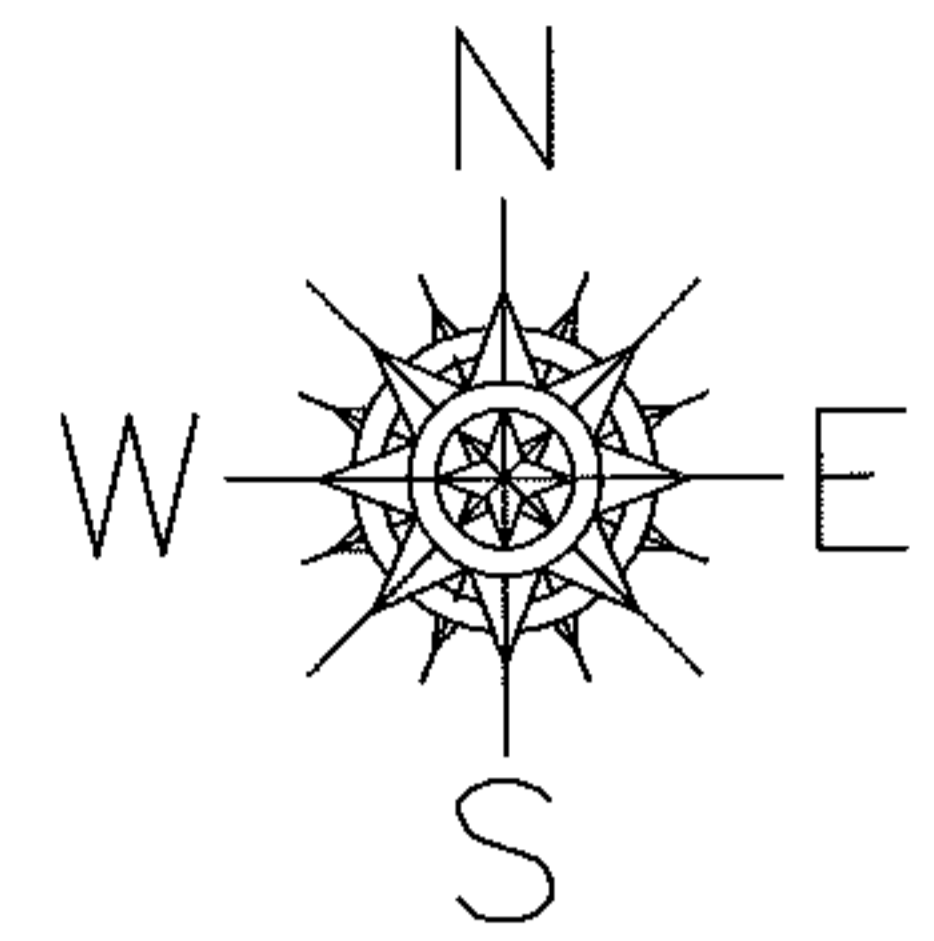

### SPLITS/DEEDS PROCESSED

LORAIN COUNTY TAX MAP DEPARTMENT  
226 MIDDLE AVE. ELYRIA, OHIO

SURVEYED BY: DAVID E LUTZ  
 CLOSURE: 0.00 : 10,000  
 MAP PAGE(S): 11-00-003-B  
 APPROVED BY: JAH DATE: 7-23-08  
 SCALE: 1" = 300 PRIOR INSTRUMENT: 20080256871