


Rozell

PARENT PARCEL: 06-24-065-103 AREA
CHILD PARCEL:
STARTING POINT:



12-02592-C

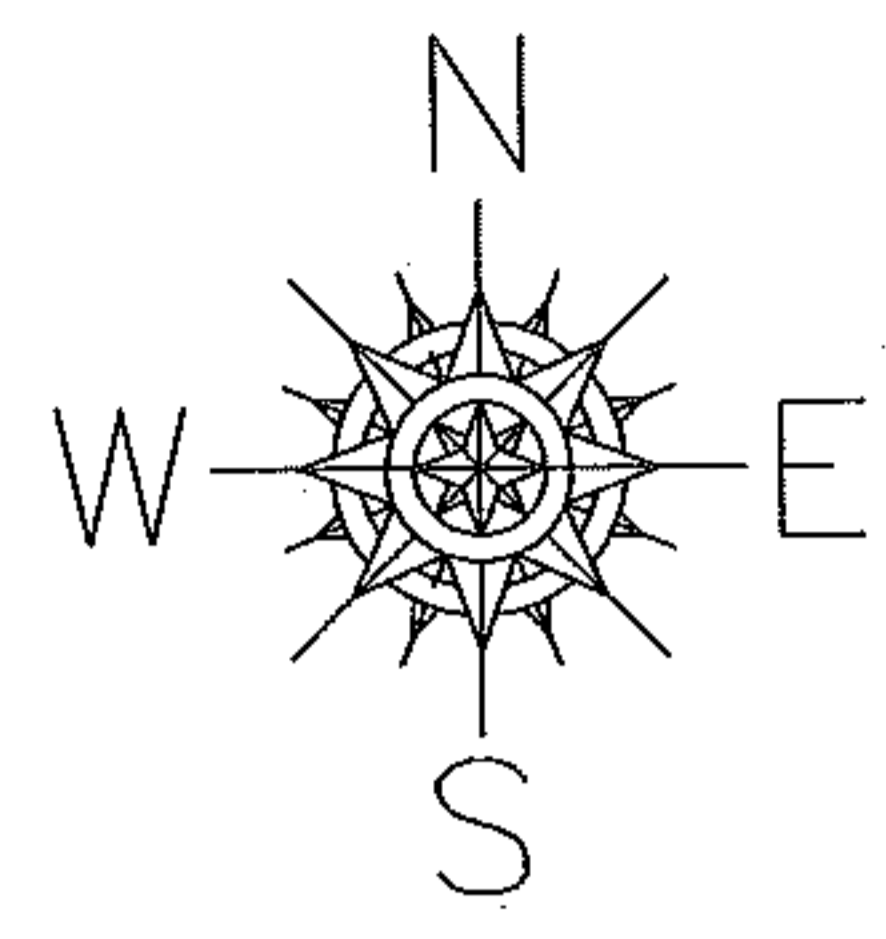

MAP CORRECTION ONLY

OLD MAP

NEW CORRECT MAP

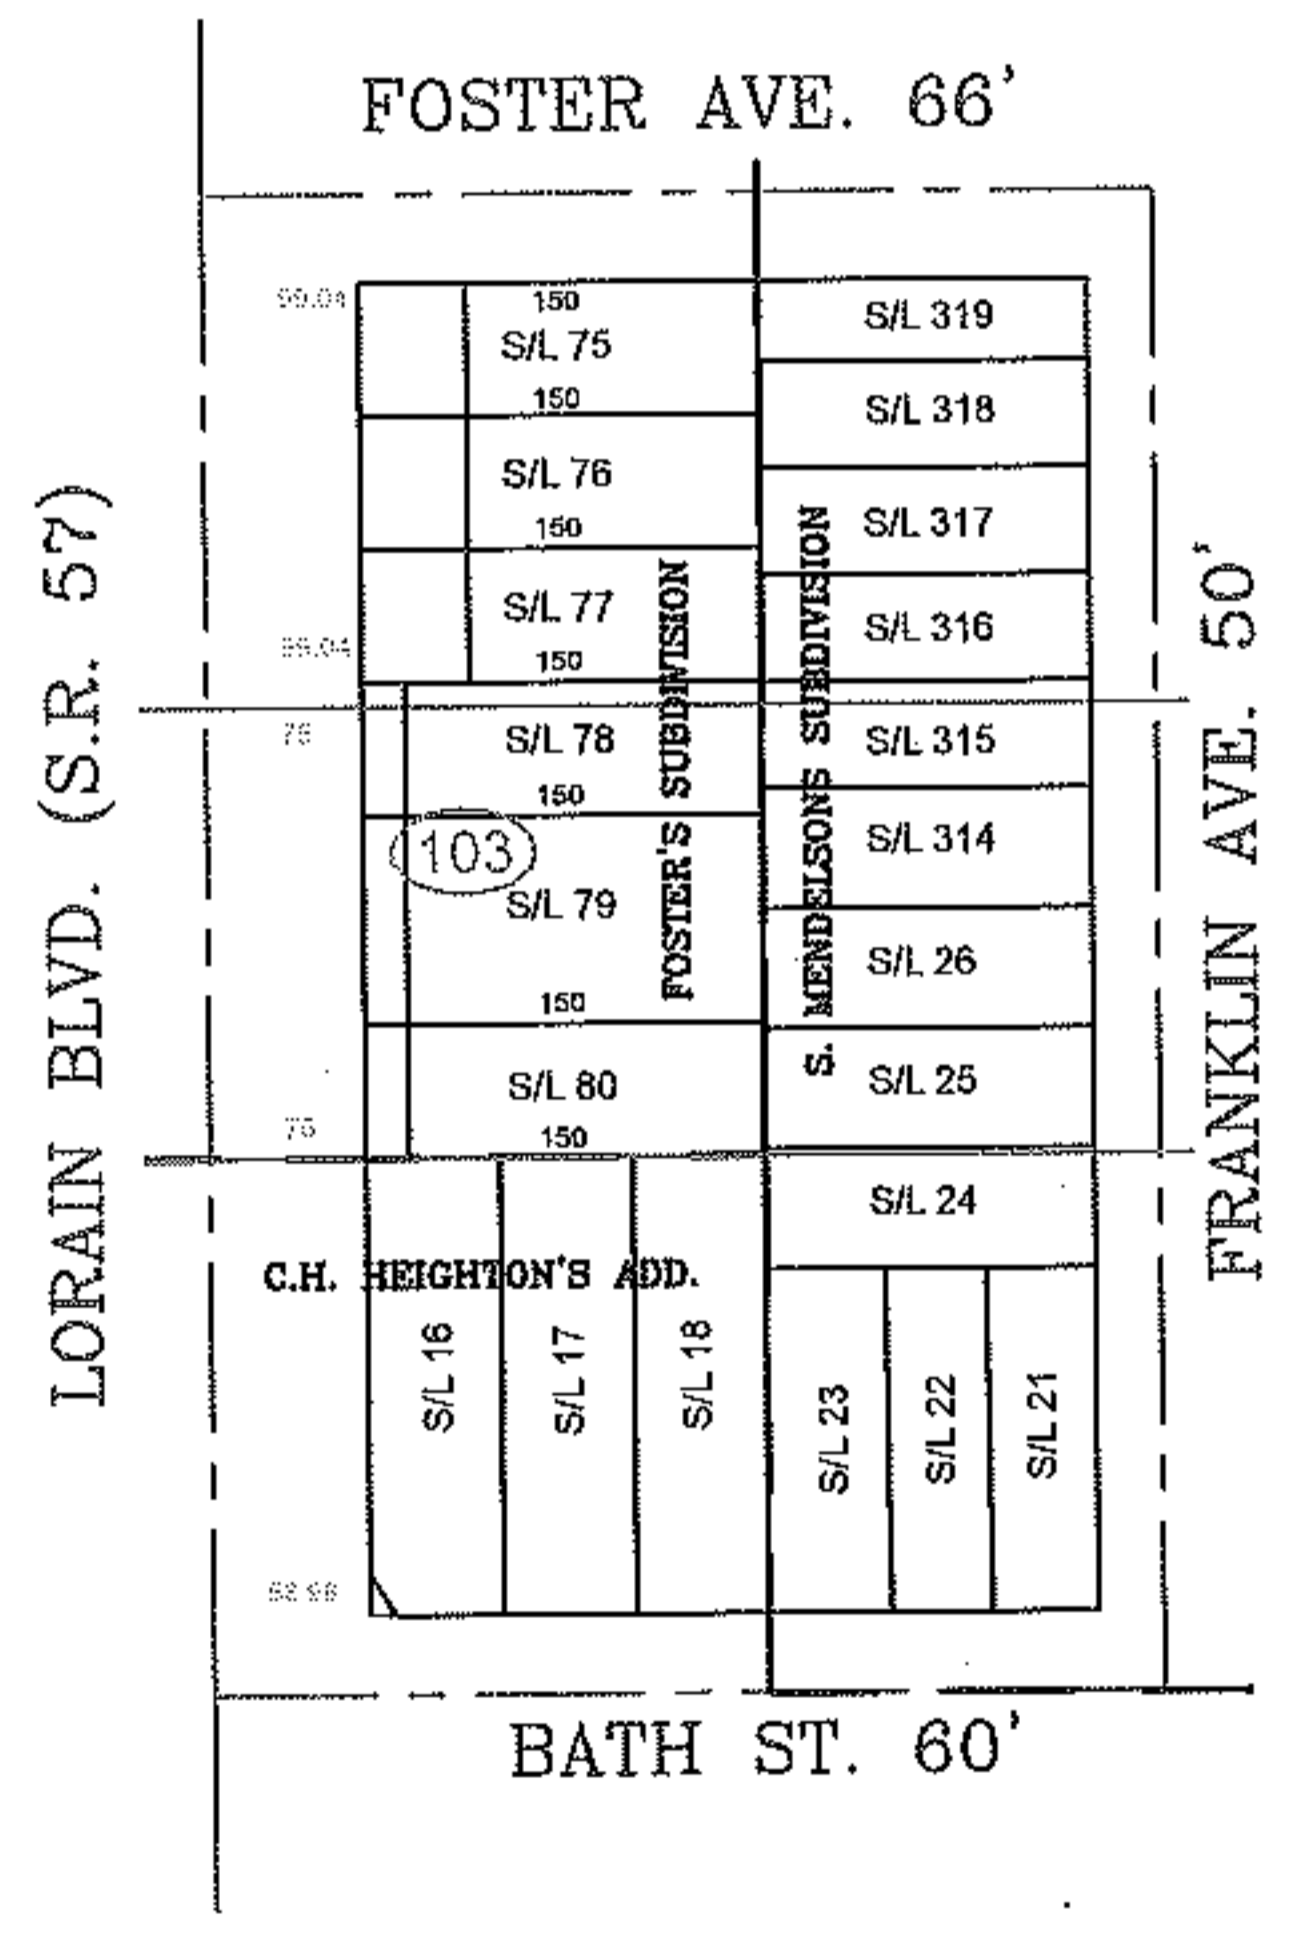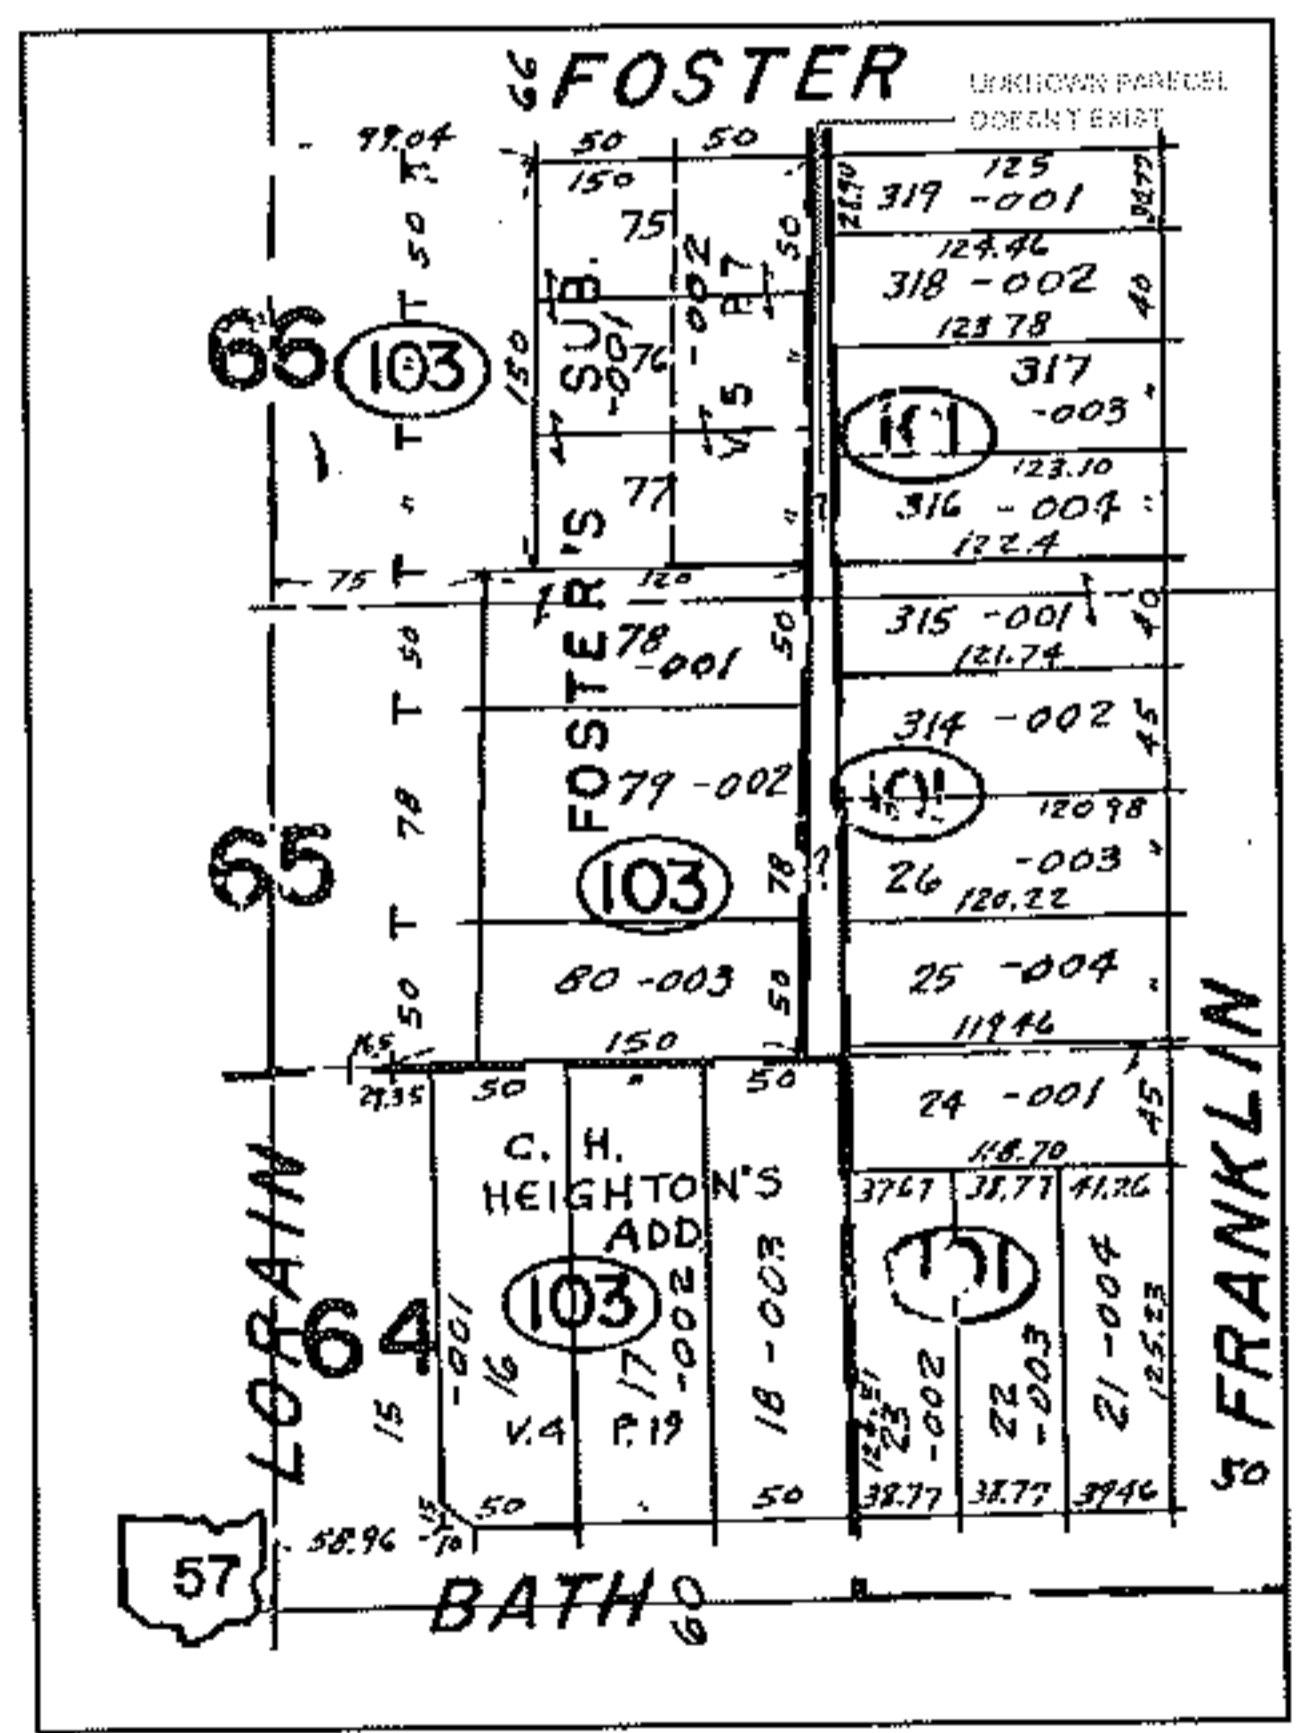

SPLITS/DEEDS PROCESSED

LORAIN COUNTY TAX MAP DEPARTMENT
226 MIDDLE AVE. ELYRIA, OHIO

SURVEYED BY: NONE
CLOSURE: NONE
MAP PAGE(S): 6/82
APPROVED BY: TJS DATE: 10/2/12
SCALE: 1"= 200 PRIOR INSTRUMENT: NONE