
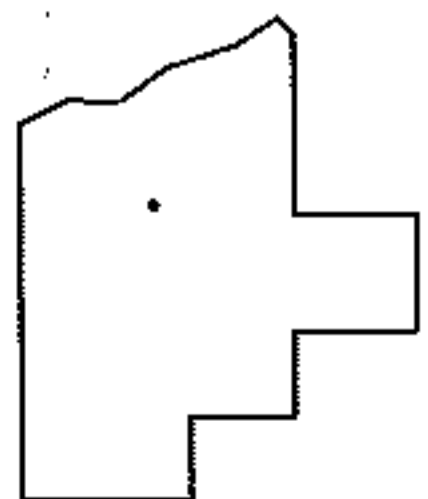
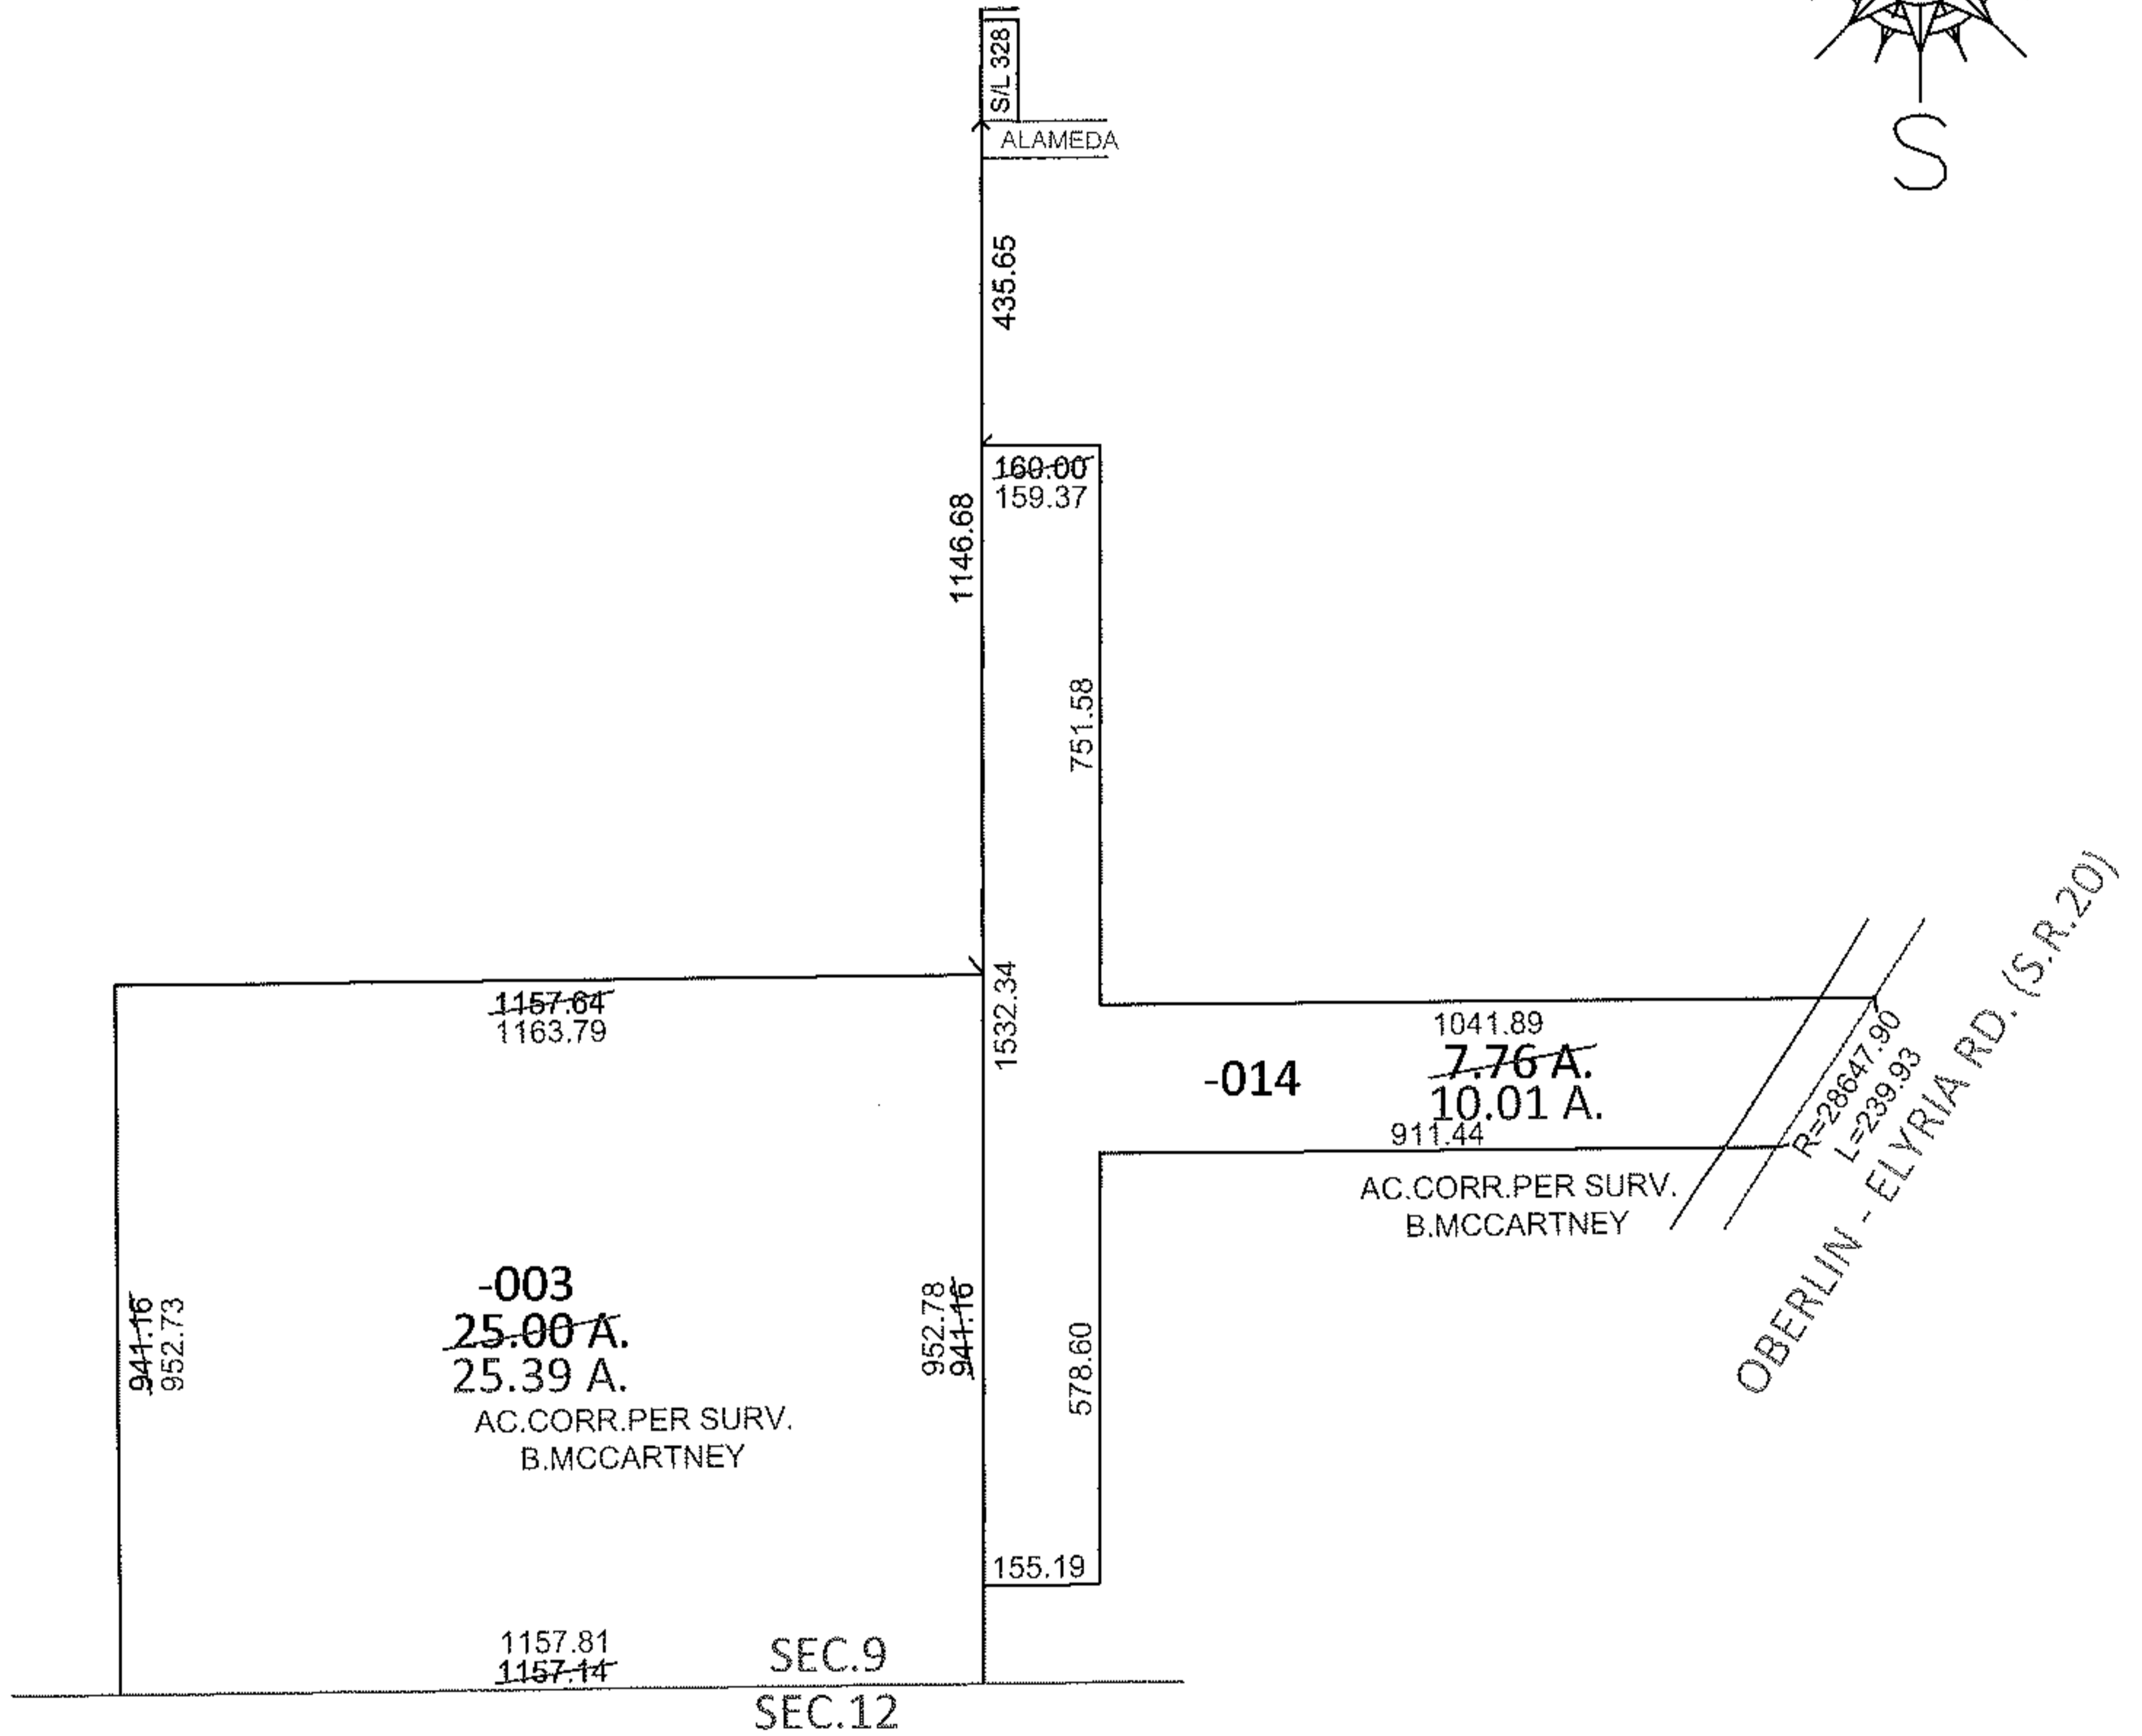


PARENT PARCEL: 10-00-009-118-003, 10-00-009-121-014

12-02593-D

CHILD PARCEL: _____

STARTING POINT: SOUTHWEST CORNER OF S/L 328 IN CARLISLE ESTATES NO.1 (VOL.12 PG.34)

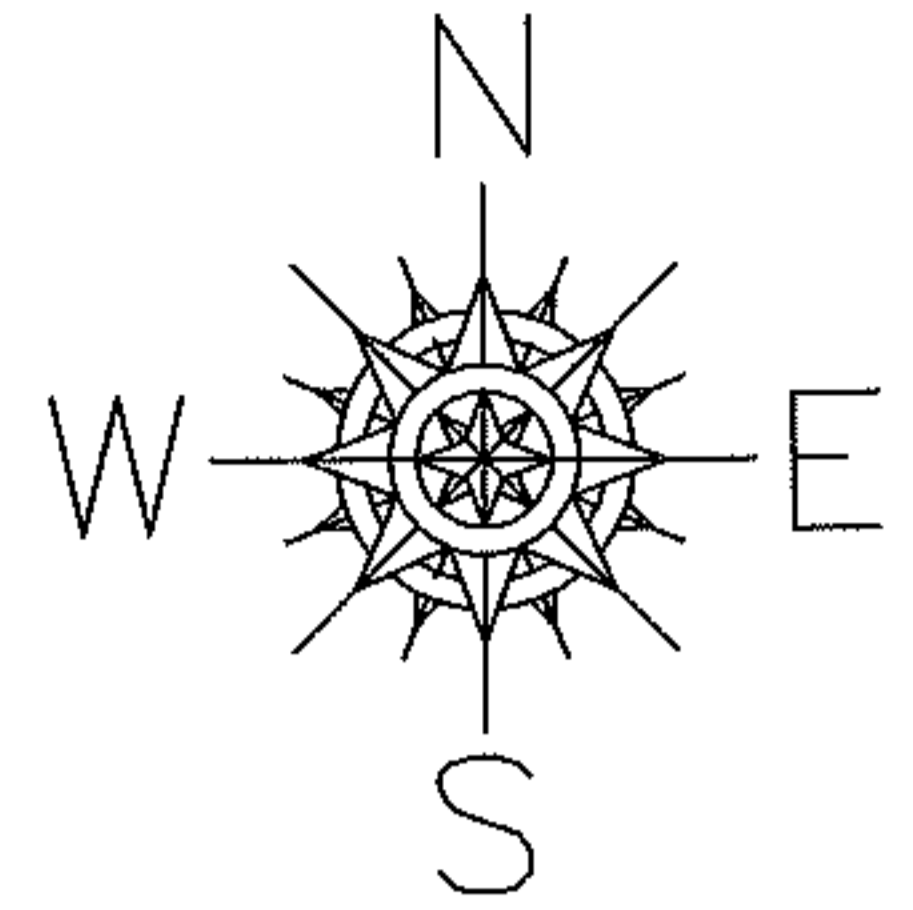

SPLITS/DEEDS PROCESSED

LORAIN COUNTY TAX MAP DEPARTMENT
226 MIDDLE AVE. ELYRIA, OHIO

SURVEYED BY: BRIAN P. MCCARTNEY

CLOSURE: .01:10,000

MAP PAGE(S): 10-00-009-E & F

APPROVED BY: RRM DATE: 10-4-12

SCALE: 1"= 400 PRIOR INST.: 20110394165