
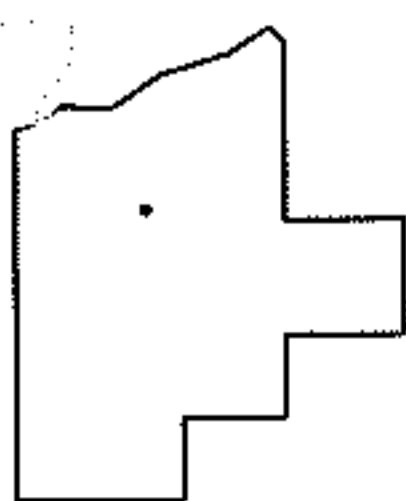
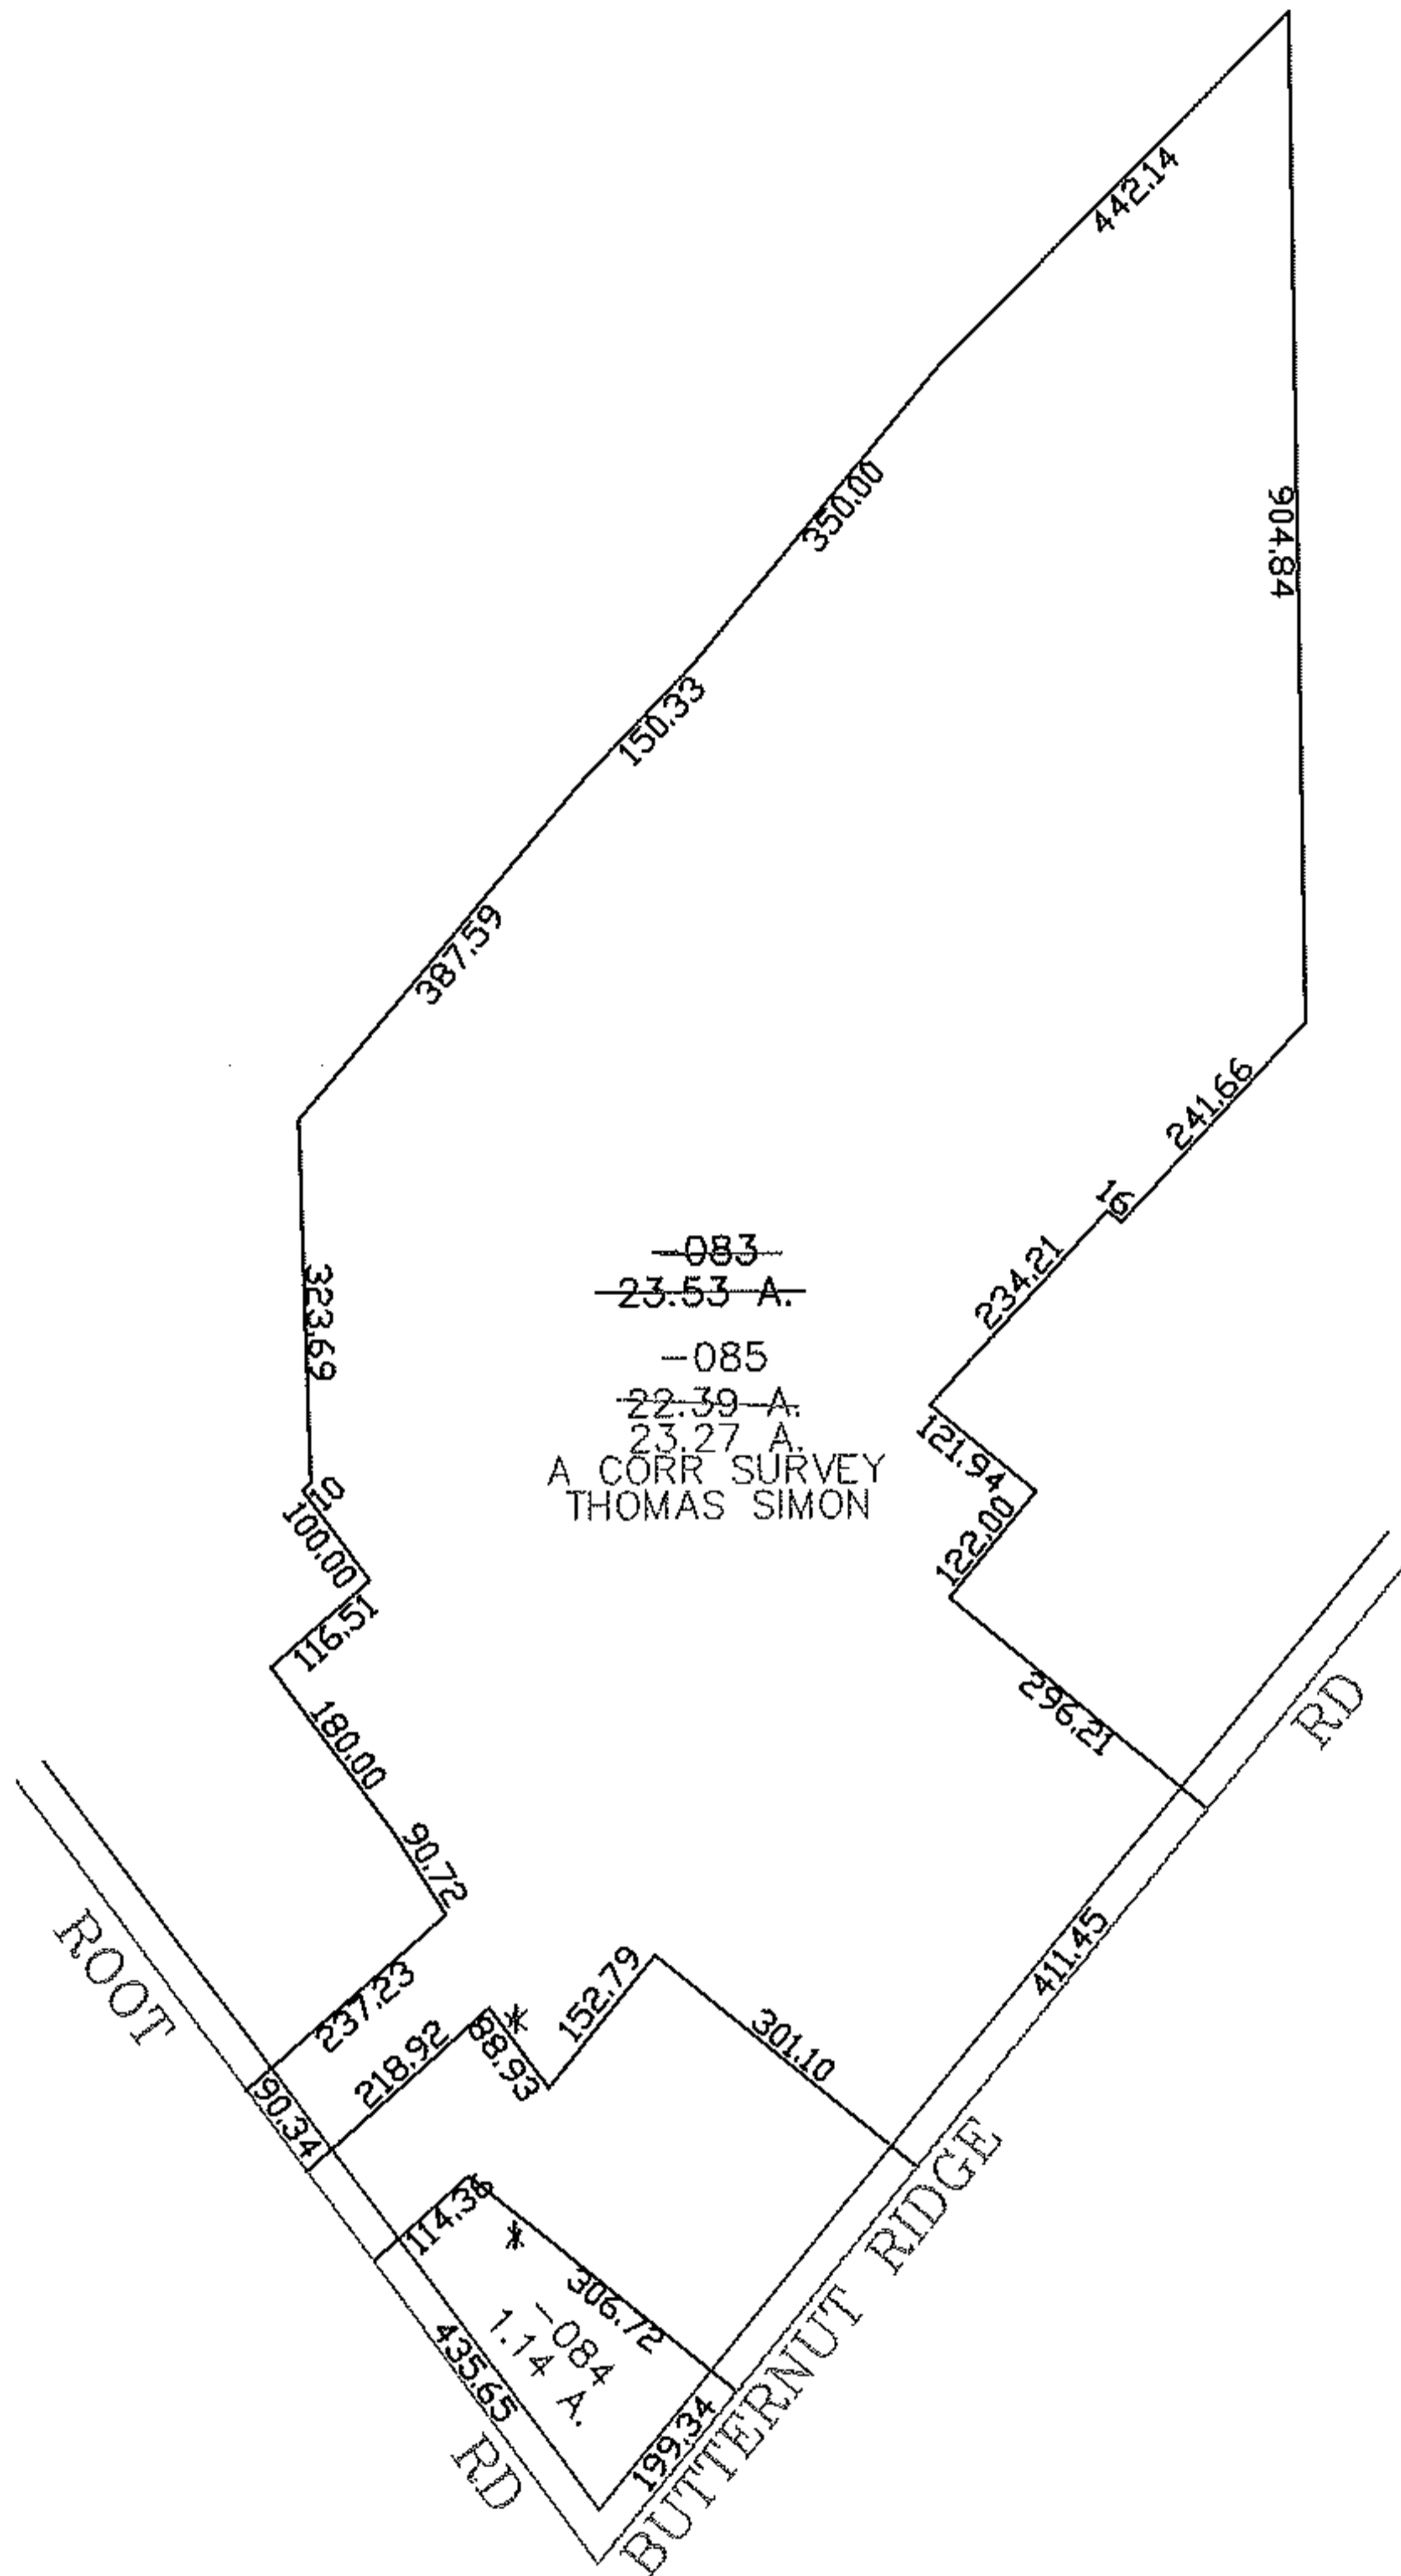


PARENT PARCEL: 07-00-014-104-083

CHILD PARCEL: 07-00-014-104-084, -085

STARTING POINT: CENTERLINE OF ROOT RD & BUTTERNUT RIDGE RD

08-02593

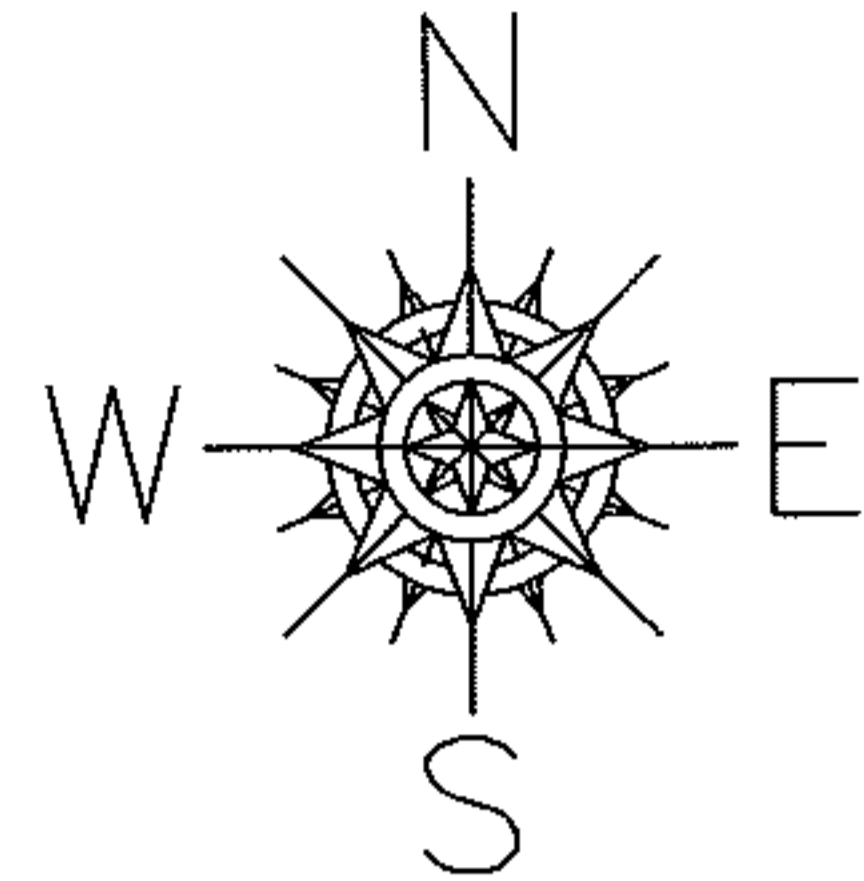

SPLITS/DEEDS PROCESSED
 LORAIN COUNTY TAX MAP DEPARTMENT
 226 MIDDLE AVE. ELYRIA, OHIO

SURVEYED BY: THOMAS SIMON
 CLOSURE: 0.00 : 10.000
 MAP PAGE(S): 07-00-014-B
 APPROVED BY: JAH DATE: 8-1-08
 SCALE: 1" = 300 PRIOR INSTRUMENT: DV 734/407