




RASTER

PARENT PARCEL: 04-00-021-000-239

CHILD PARCEL: 04-00-021-000-249, -250

STARTING POINT: CENTERLINE OF JAYCOX RD & AVON COMMERCE PKWY

08-02595

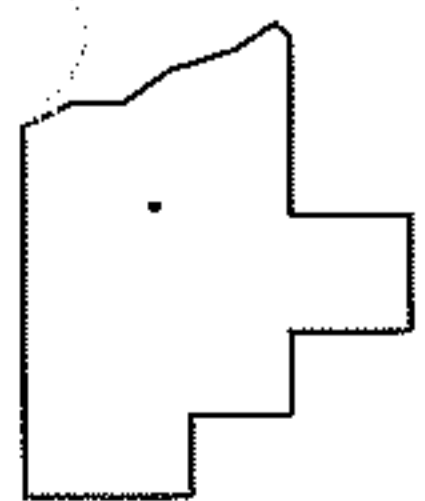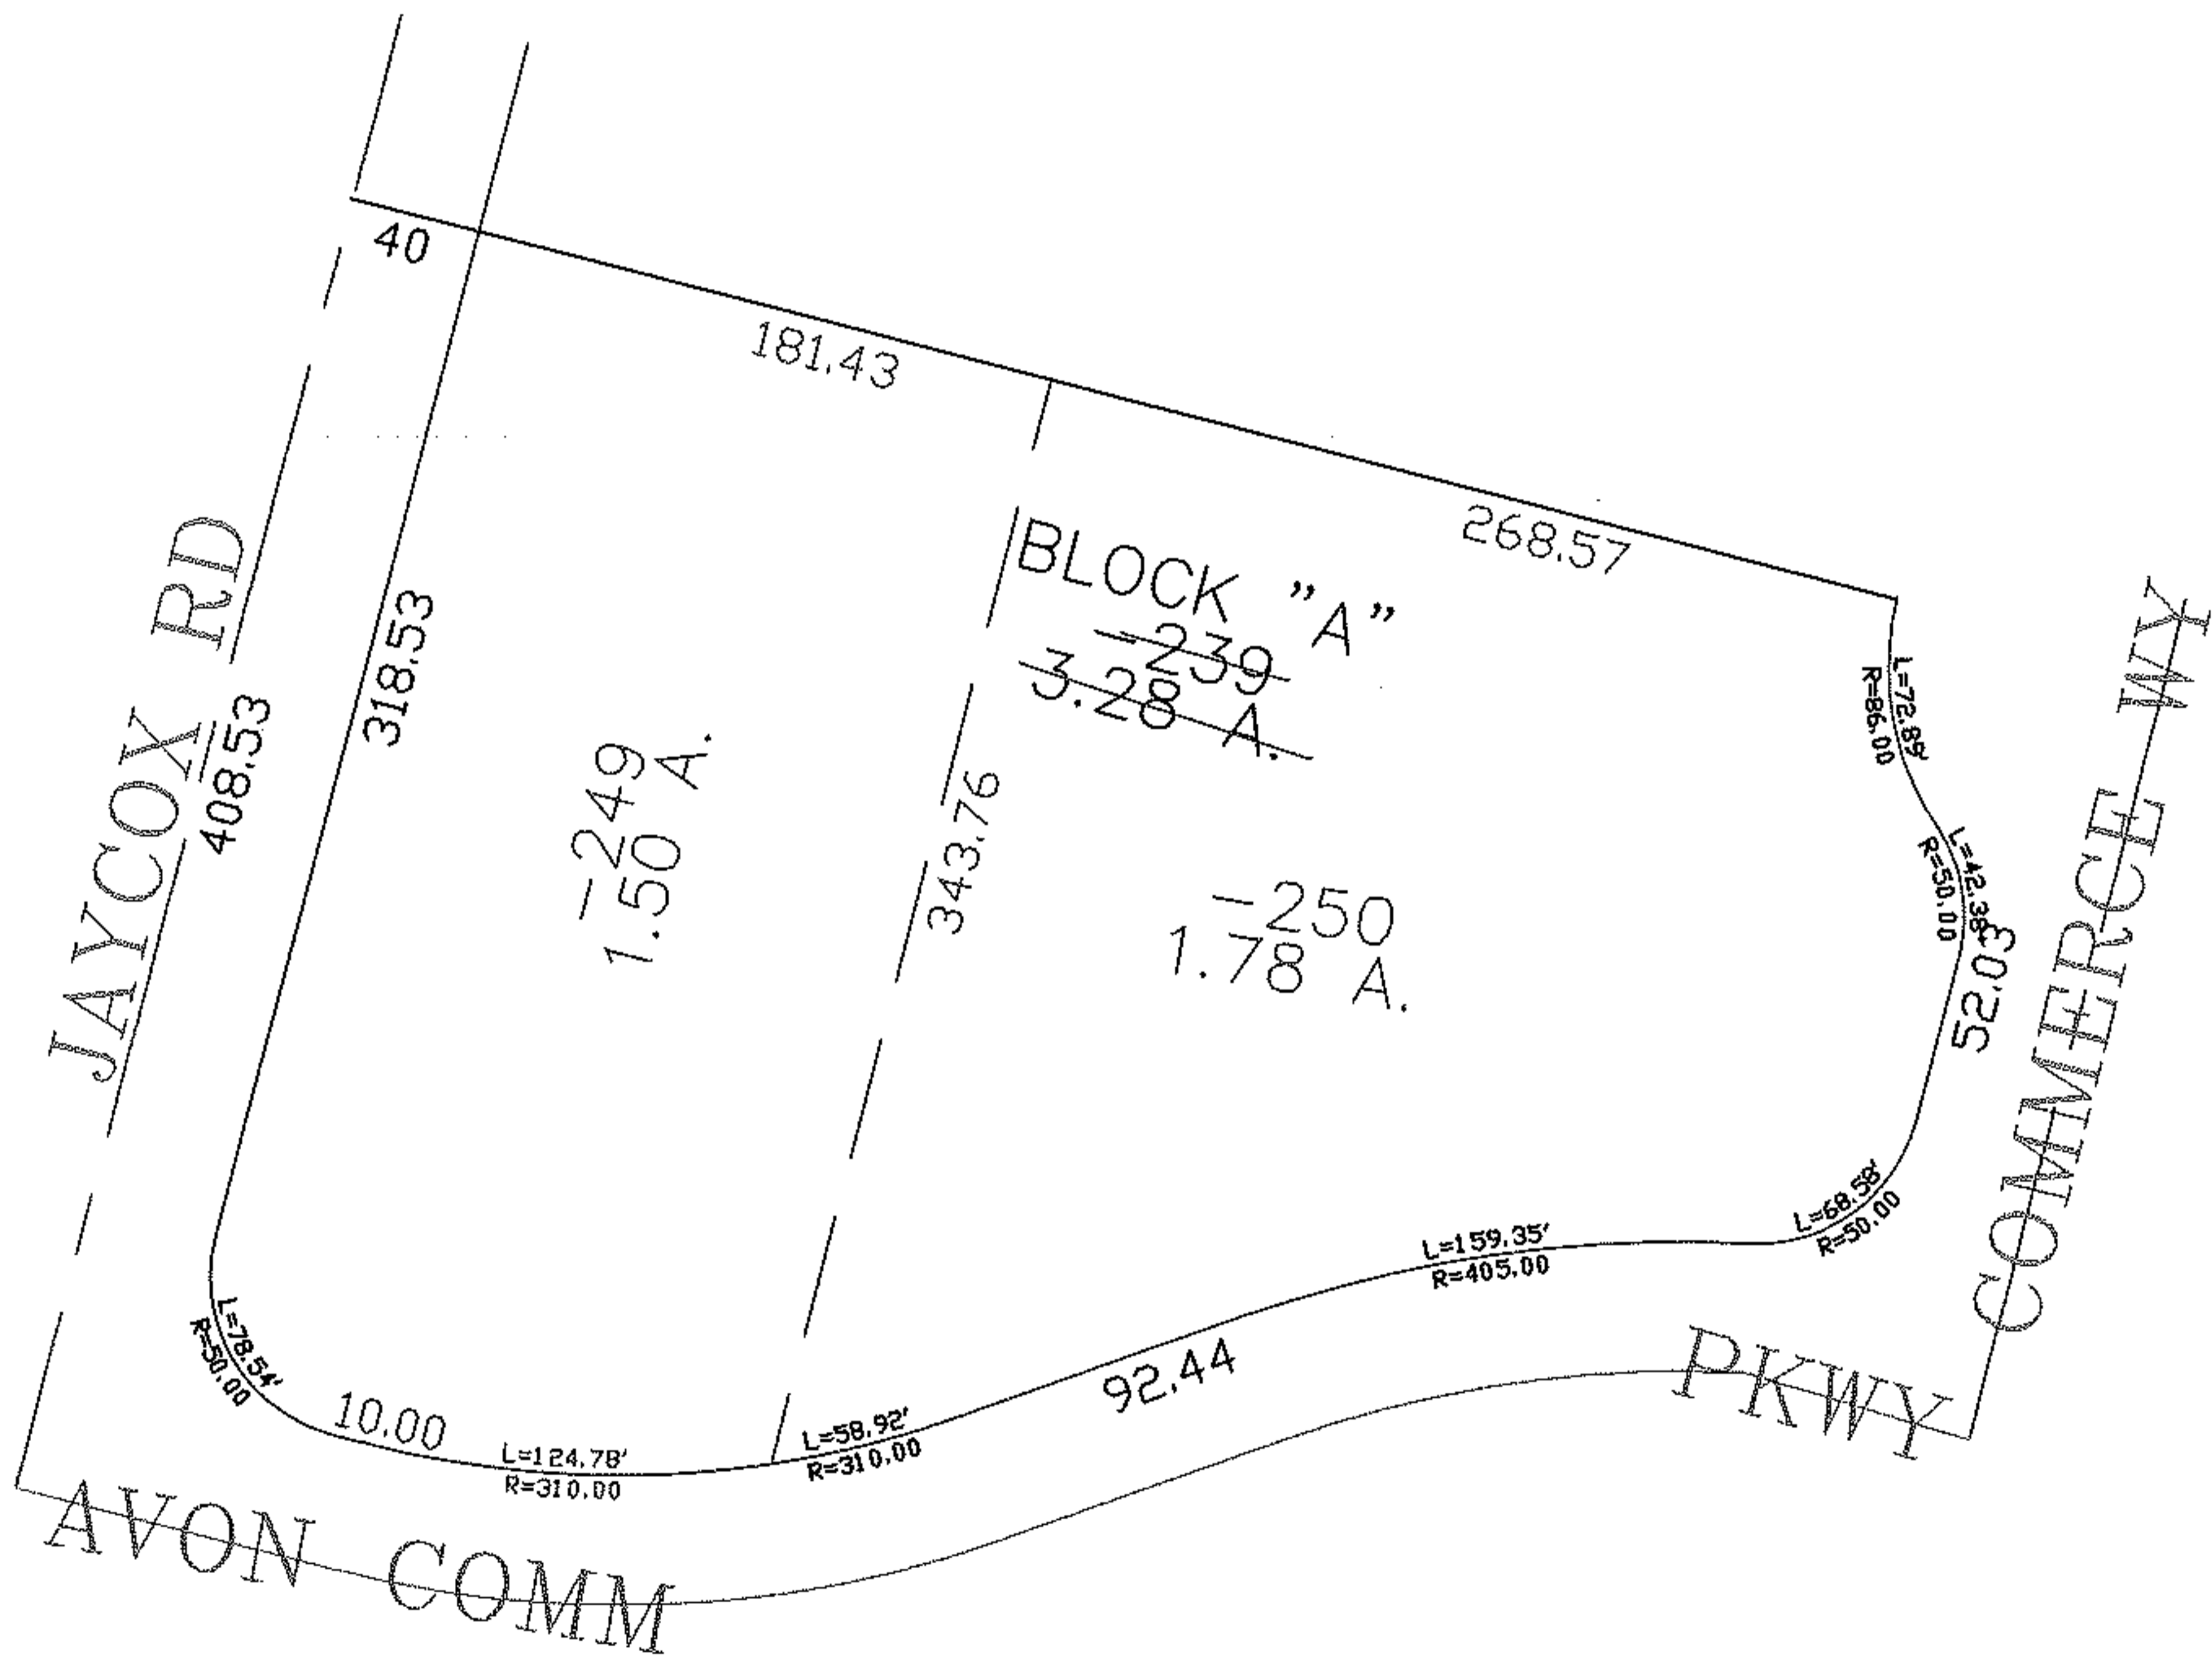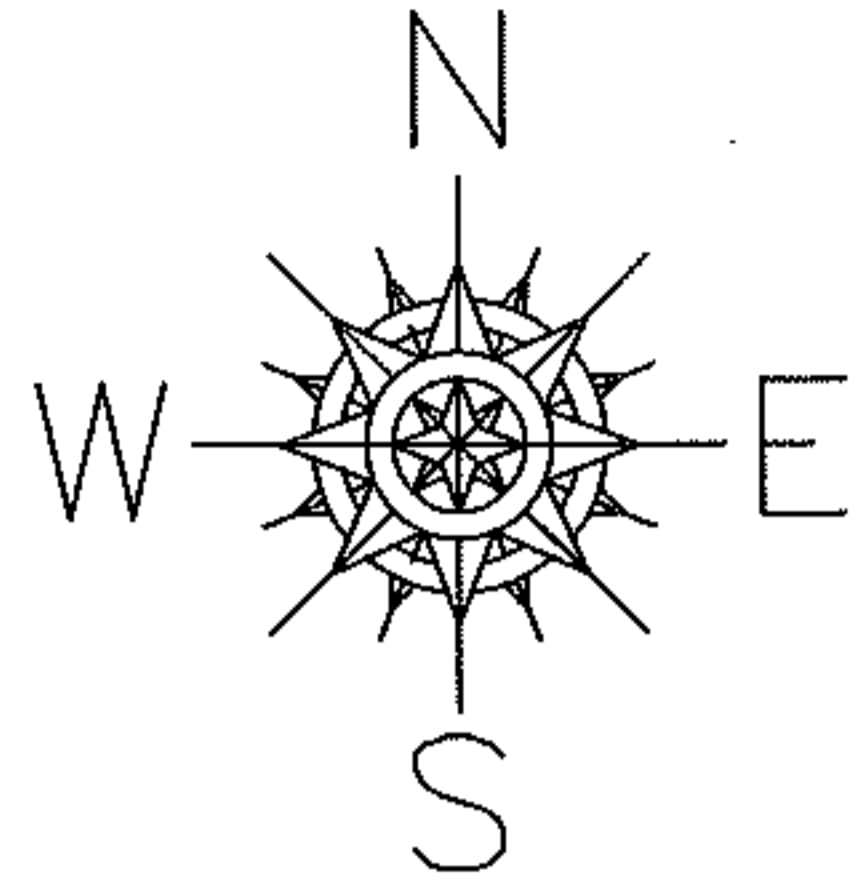

SPLITS/DEEDS PROCESSED

LORAIN COUNTY TAX MAP DEPARTMENT
226 MIDDLE AVE. ELYRIA, OHIO

SURVEYED BY: MIKE SPELLACY
 CLOSURE: 0.00 : 10.000
 MAP PAGE(S): 04-00-021-C
 APPROVED BY: JAH DATE: 8-7-08
 SCALE: 1" = 100 PRIOR INSTRUMENT: 20020834839