



RASTER

PARENT PARCEL: 07-00-028-101-083, -096

CHILD PARCEL: 07-00-028-101-122 THRU -124

STARTING POINT: CENTERLINE OF CENTER RIDGE RD & STONEY RIDGE RD

08-02596

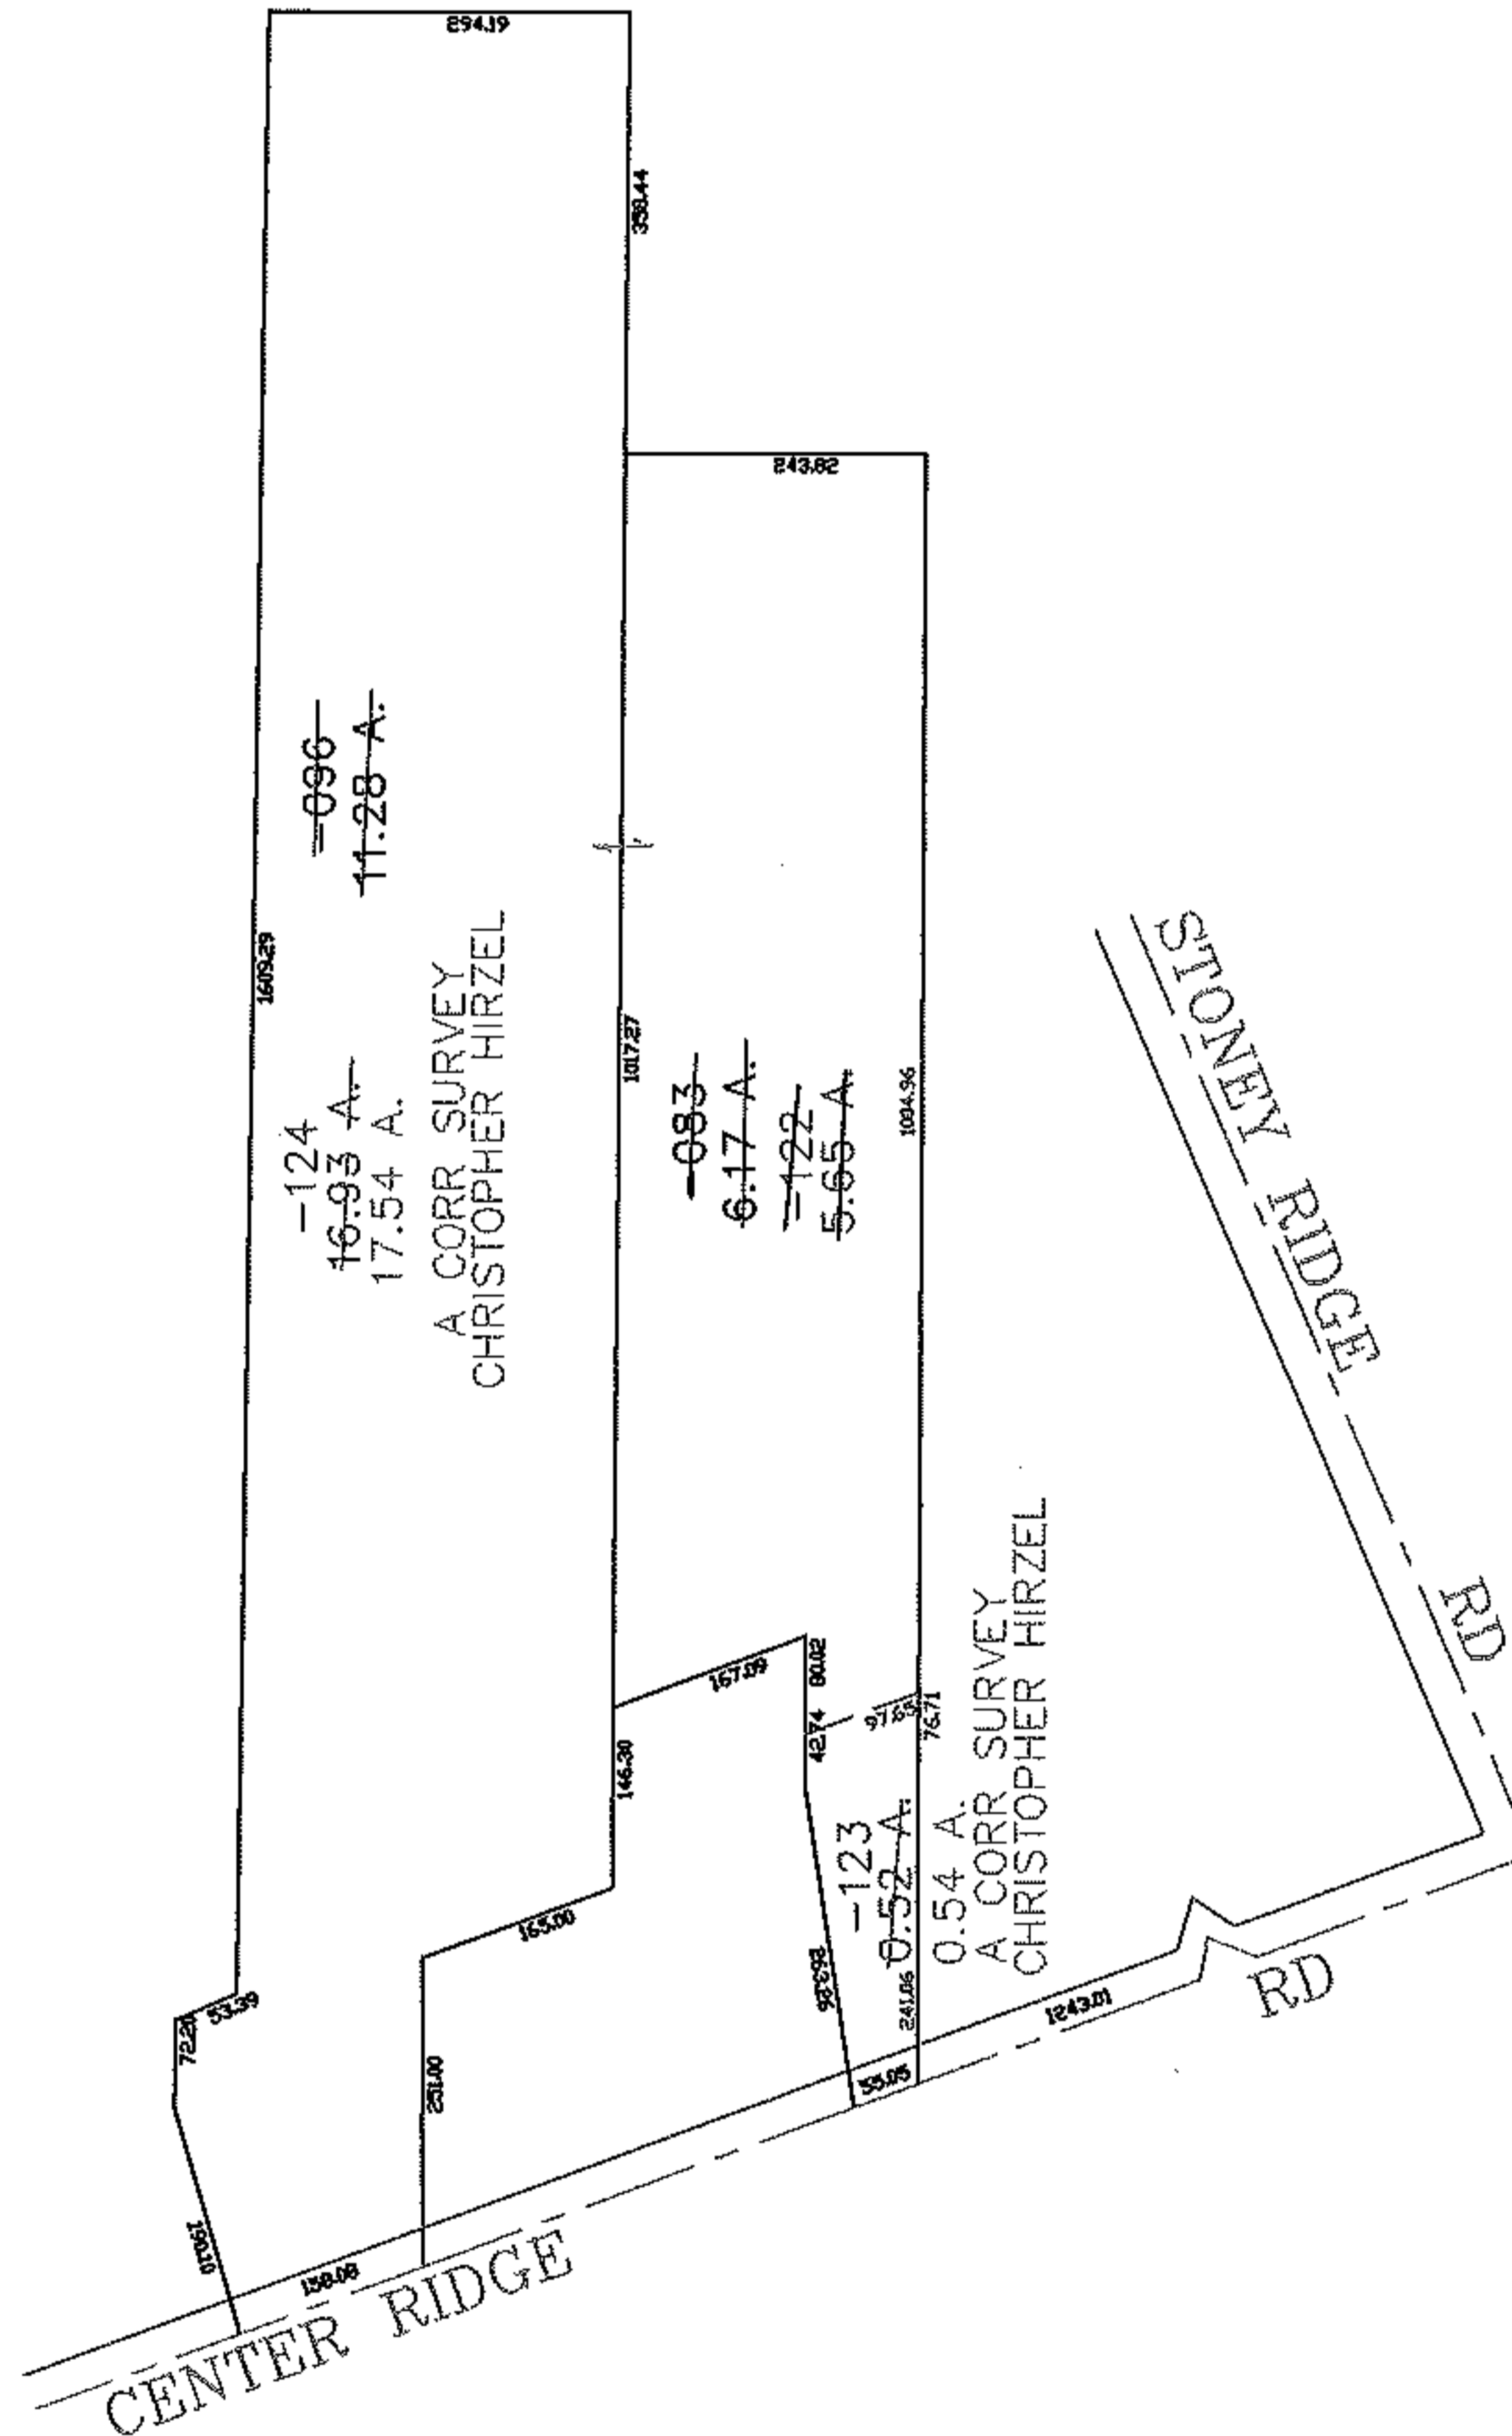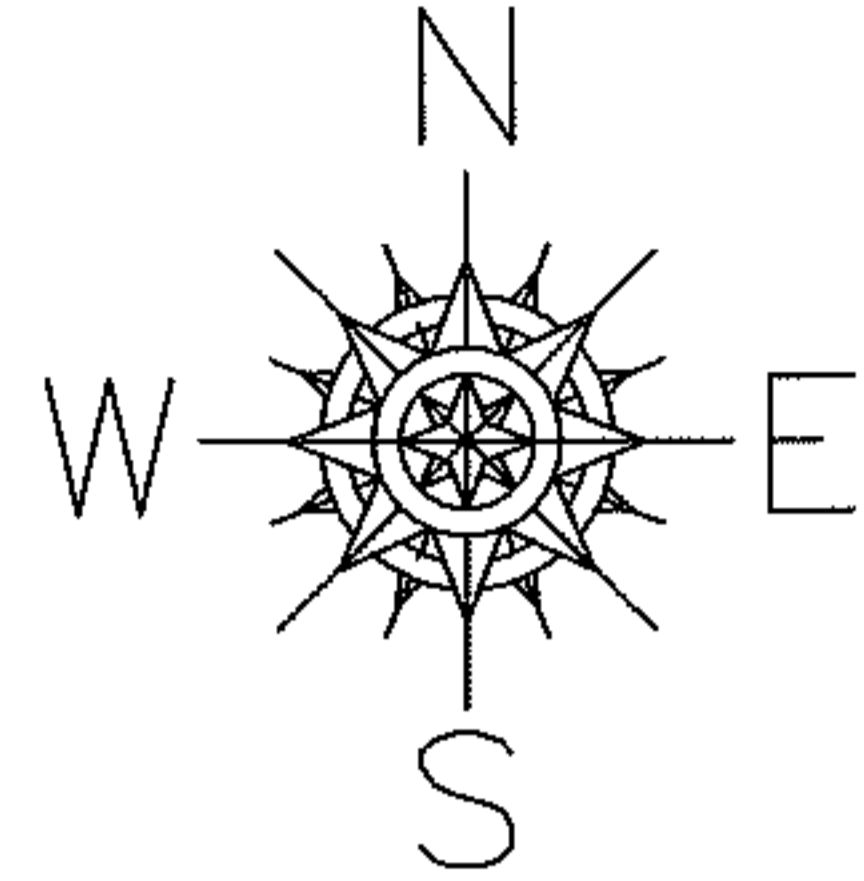

SPLITS/DEEDS PROCESSED

LORAIN COUNTY TAX MAP DEPARTMENT
226 MIDDLE AVE. ELYRIA, OHIO

SURVEYED BY: CHRISTOPHER HIRZEL

CLOSURE: 0.00 : 10,000

MAP PAGE(S): 07-00-028-C

APPROVED BY: JAH DATE: 8-22-08

SCALE: 1" = 300 PRIOR INSTRUMENT: OR 442/462