



RASTER

PARENT PARCEL: 21-05-031-000-001 & 21-05-032-000-004

CHILD PARCEL: XX-XX-XXX-XXX-XXX

STARTING POINT: S.W. CORNER OF O.L. 31

12-02599-C

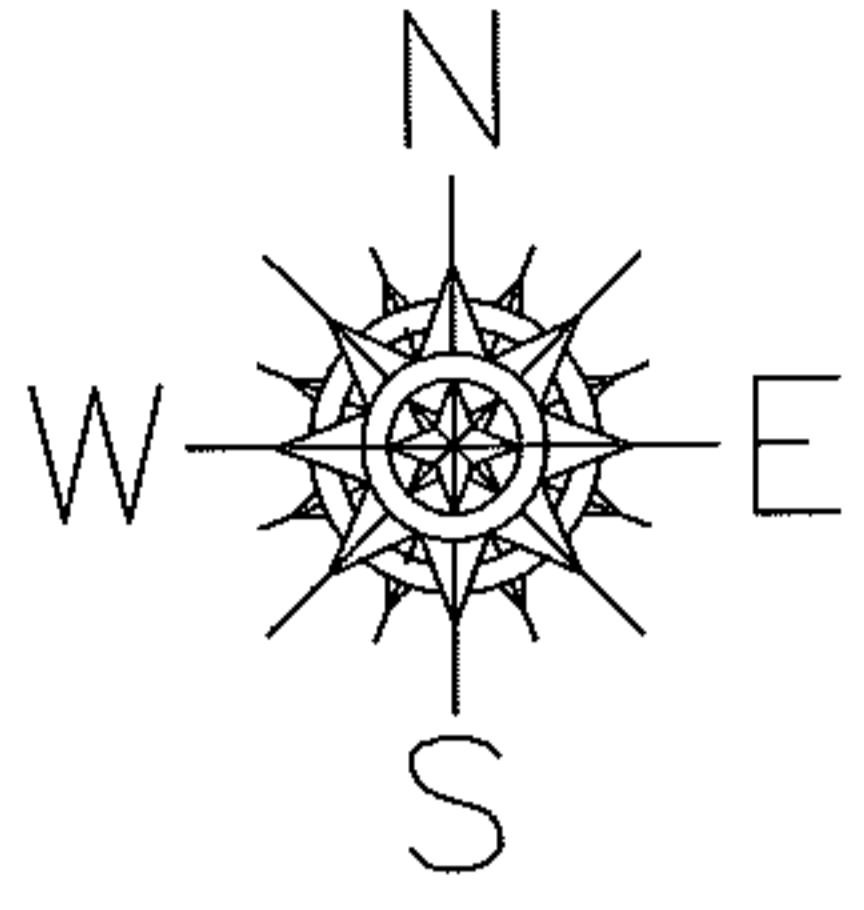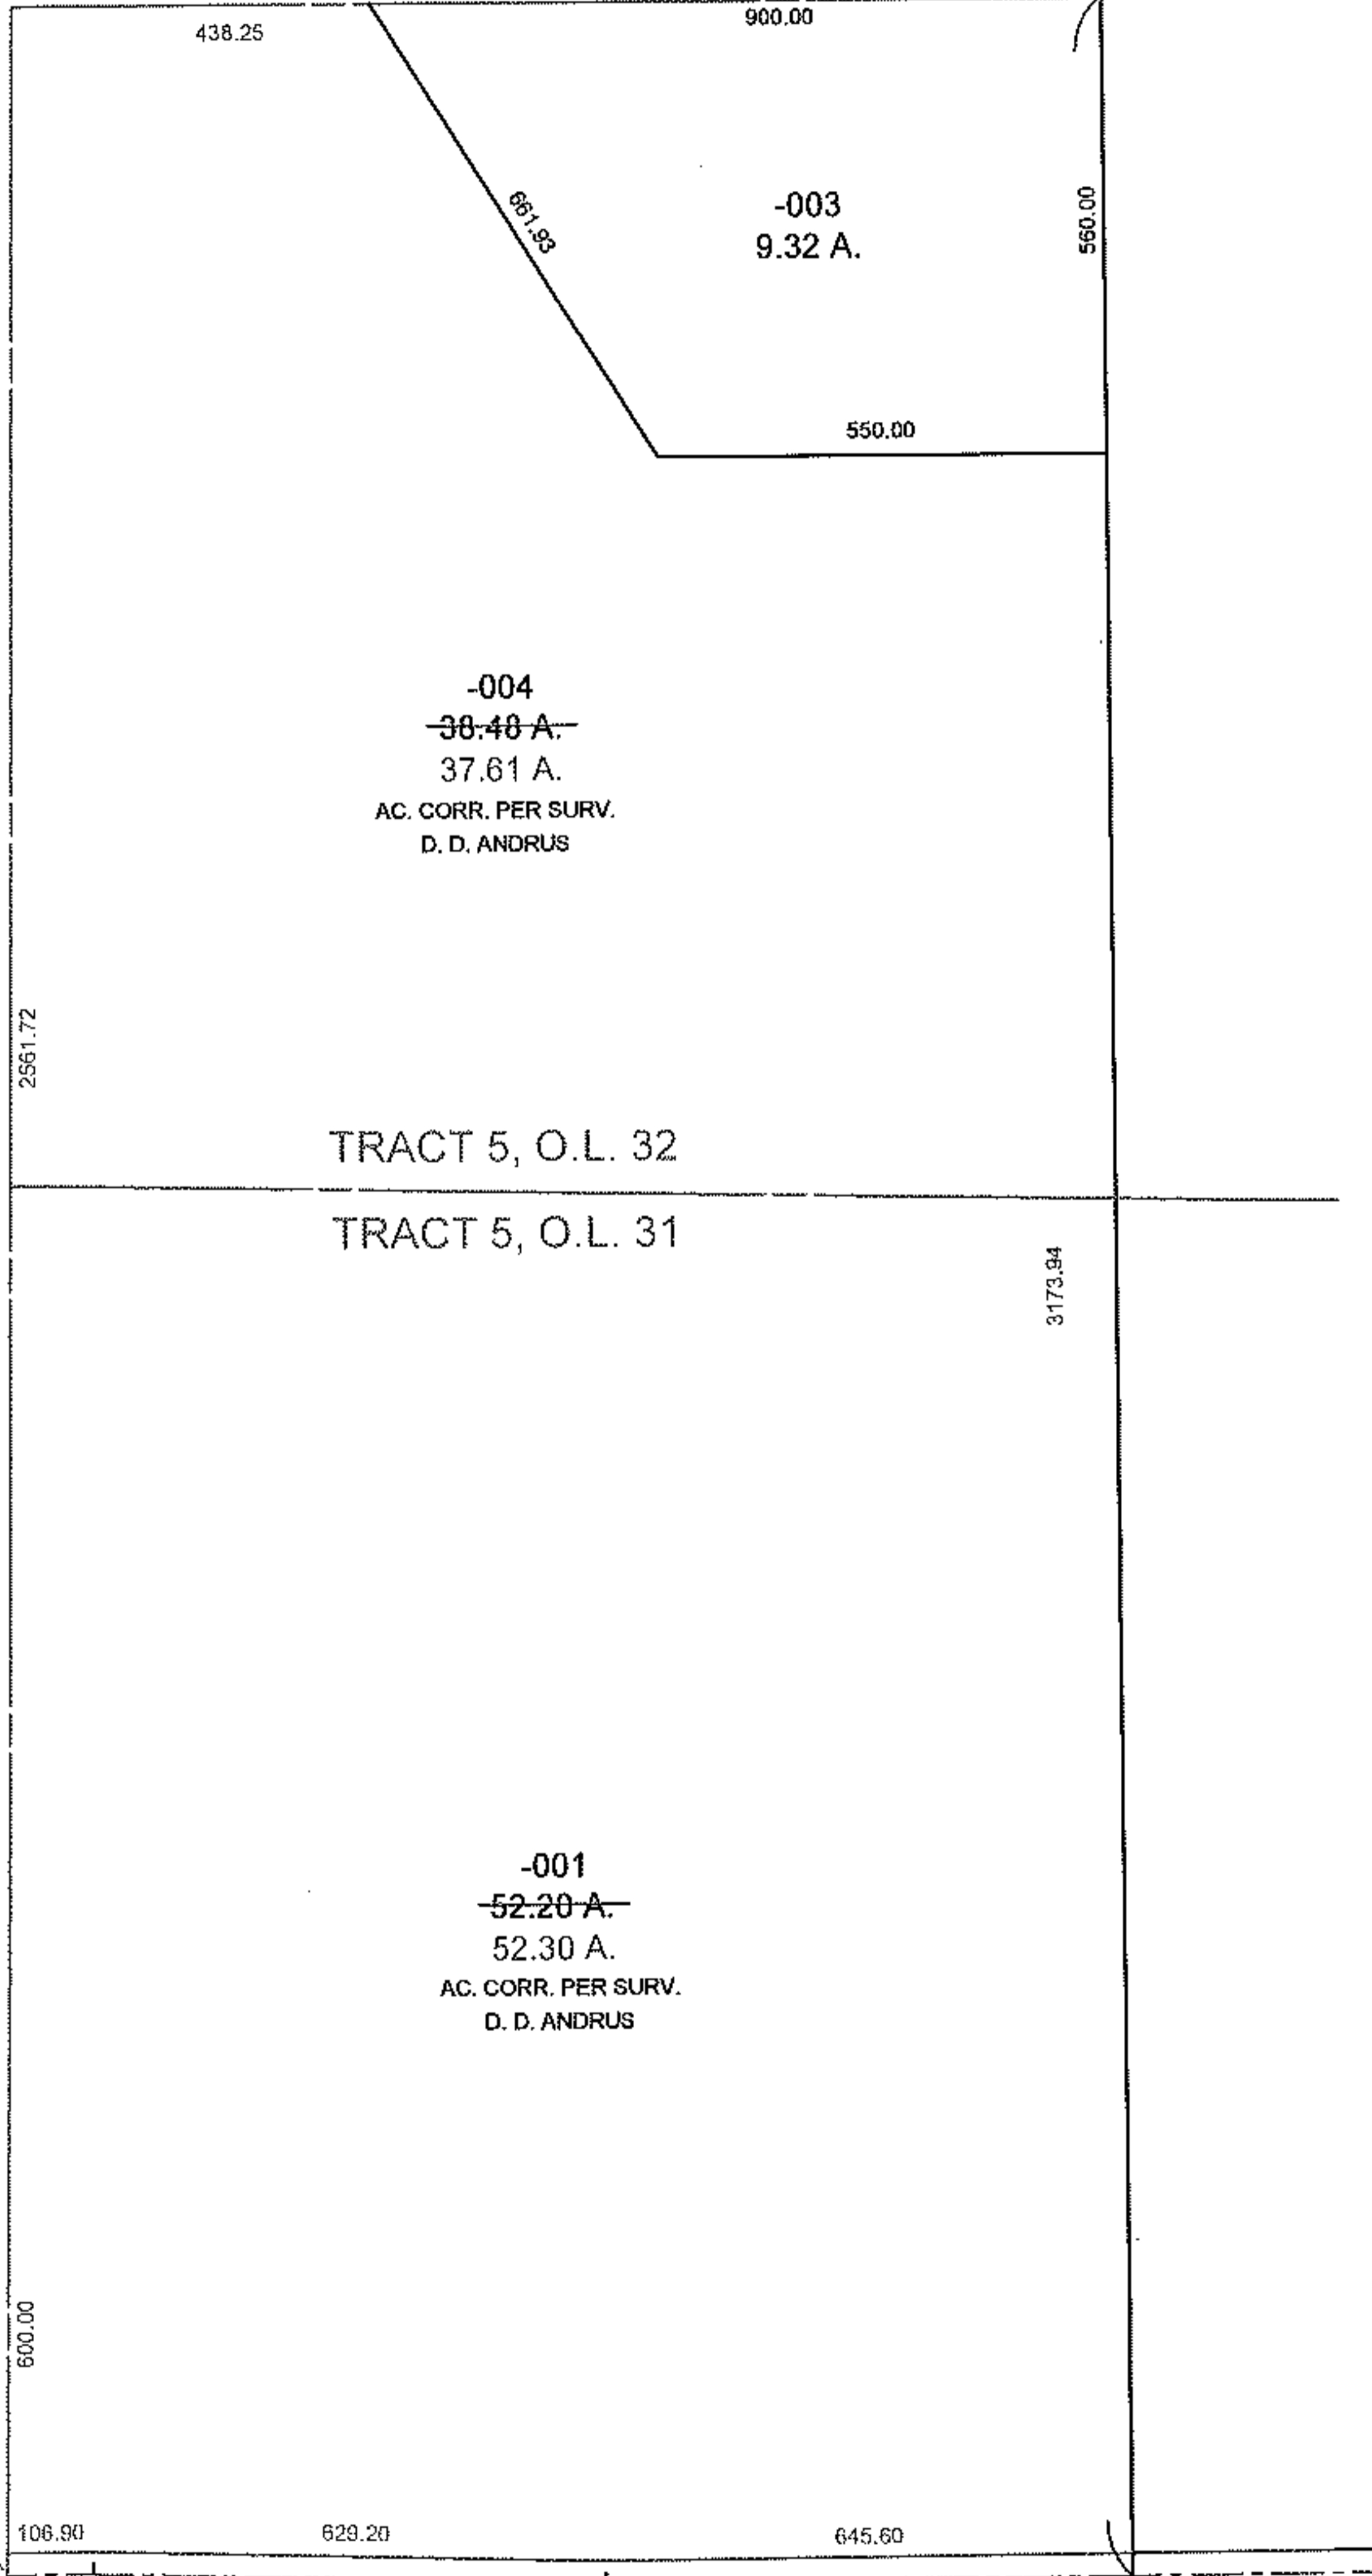

TRACT 5, O.L. 32

TRACT 5, O.L. 31

-001
~~52.20 A.~~
52.30 A.
AC. CORR. PER SURV.
D. D. ANDRUS

-004
~~38.48 A.~~
37.61 A.
AC. CORR. PER SURV.
D. D. ANDRUS

-003
9.32 A.

BEGINNING

GRIGGS RD. 60'



SPLITS/DEEDS PROCESSED
LORAIN COUNTY TAX MAP DEPARTMENT
226 MIDDLE AVE. ELYRIA, OHIO

SURVEYED BY: D. D. ANDRUS
 CLOSURE: 1 : 10,000
 MAP PAGE(S): 21-A
 APPROVED BY: TJS DATE: 10/15/12
 SCALE: 1" = 400 PRIOR INSTRUMENT: DV 1352/637