



RASTER

PARENT PARCEL: 04-00-015-103-071, -045

CHILD PARCEL: 04-00-015-103-072 THRU -077

08-02601

POINT: CENTERLINE OF DETROIT RD % MIDDLETON RD

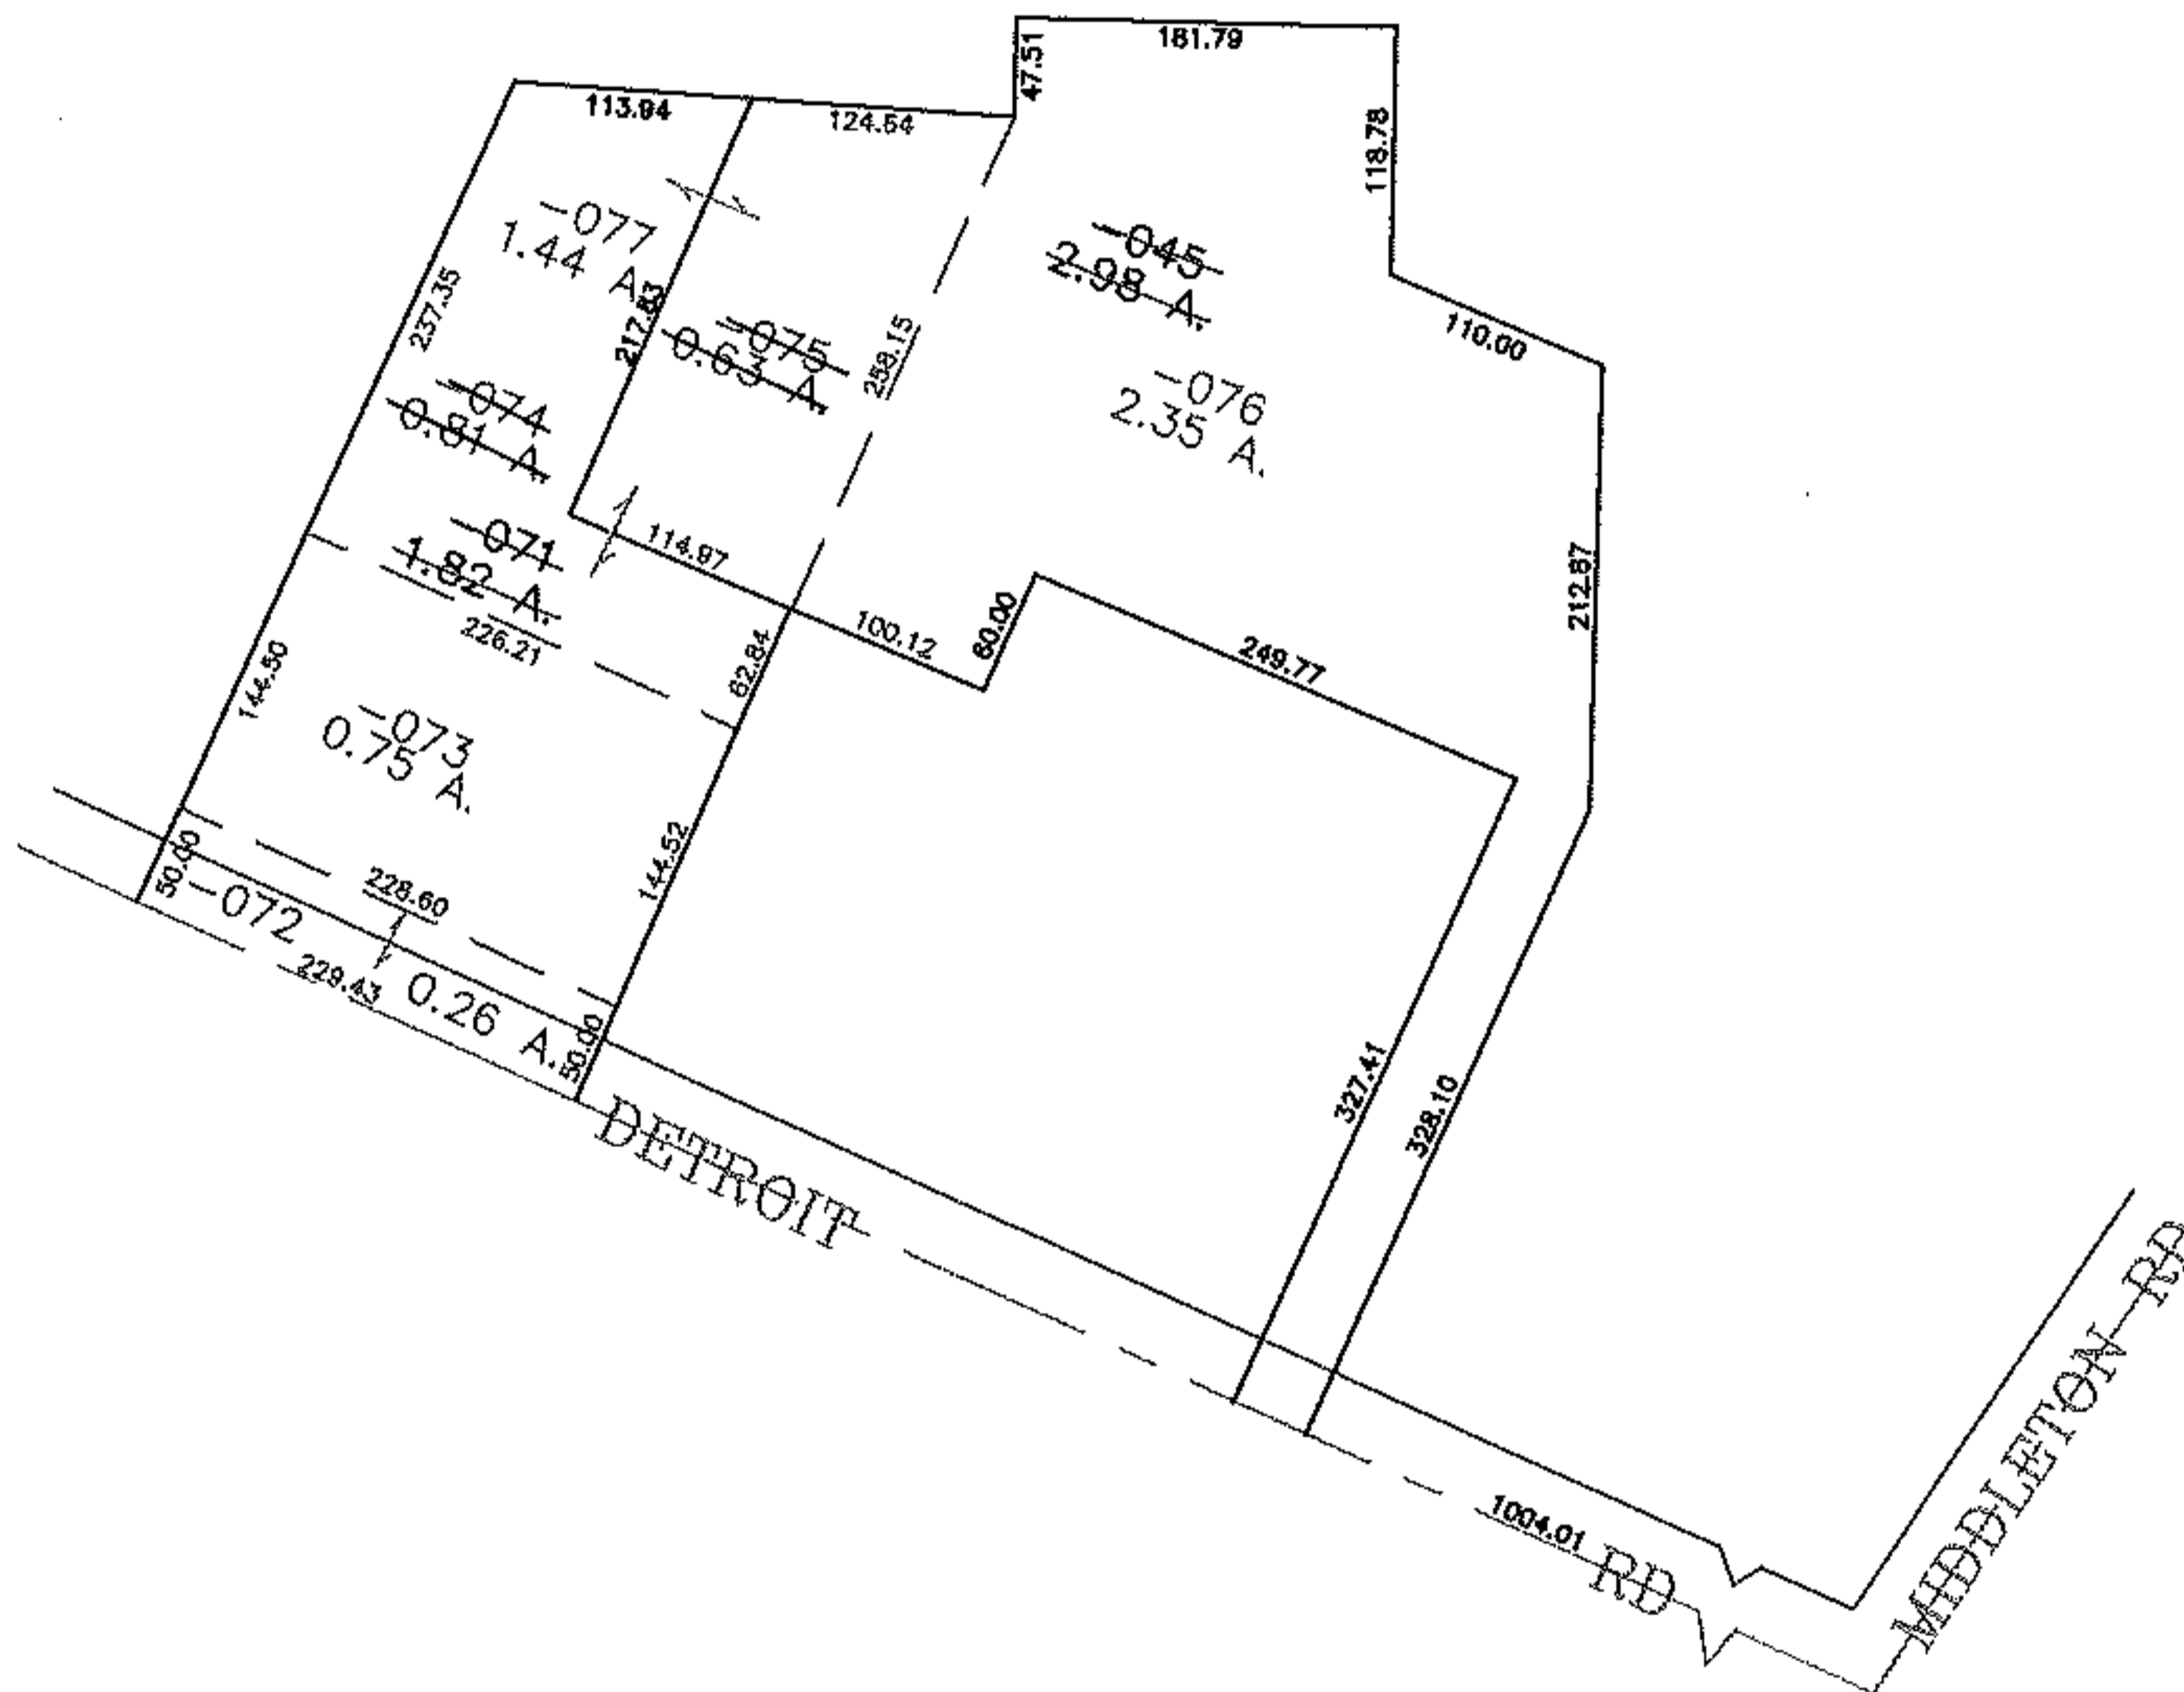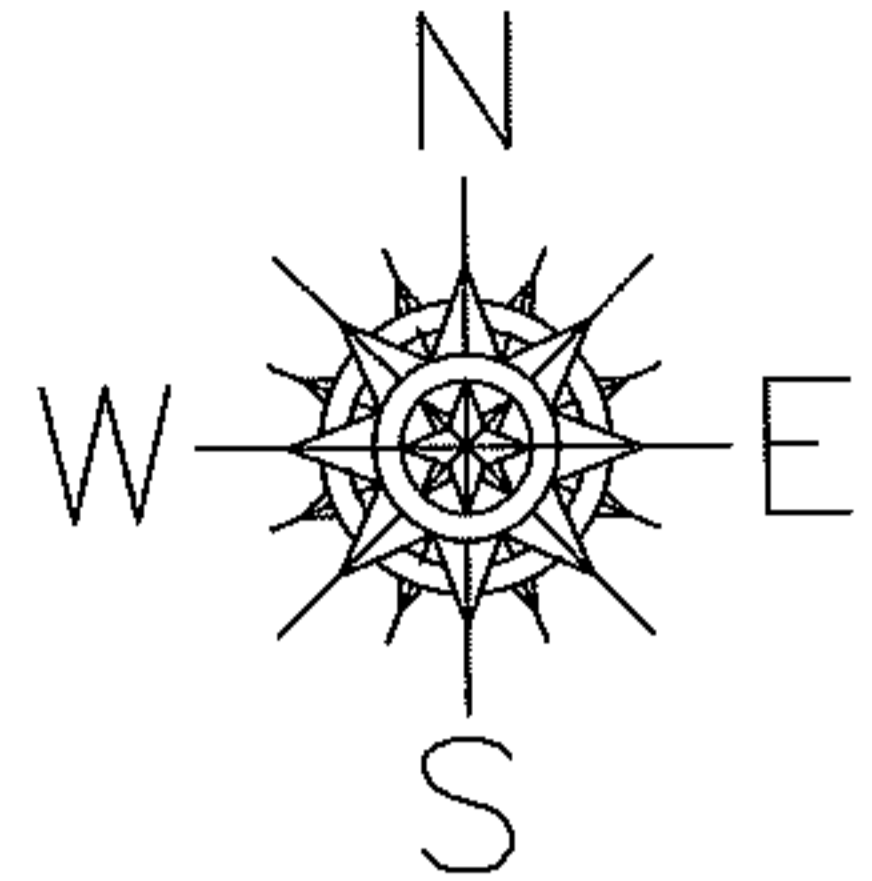

**SPLITS/DEEDS PROCESSED**

LORAIN COUNTY TAX MAP DEPARTMENT  
226 MIDDLE AVE. ELYRIA, OHIO

SURVEYED BY: DAVE ELWELL

CLOSURE: 0.00 : 10.000

MAP PAGE(S): 04-00-015-A

APPROVED BY: JAH DATE: 8-22-08

SCALE: 1" = 200 PRIOR INSTRUMENT: 20070217526