



RASTER

PARENT PARCEL: 03-00-075-108-037, -021

CHILD PARCEL: 03-00-075-108-042

STARTING POINT: NO DESCRIPTION

08-02605

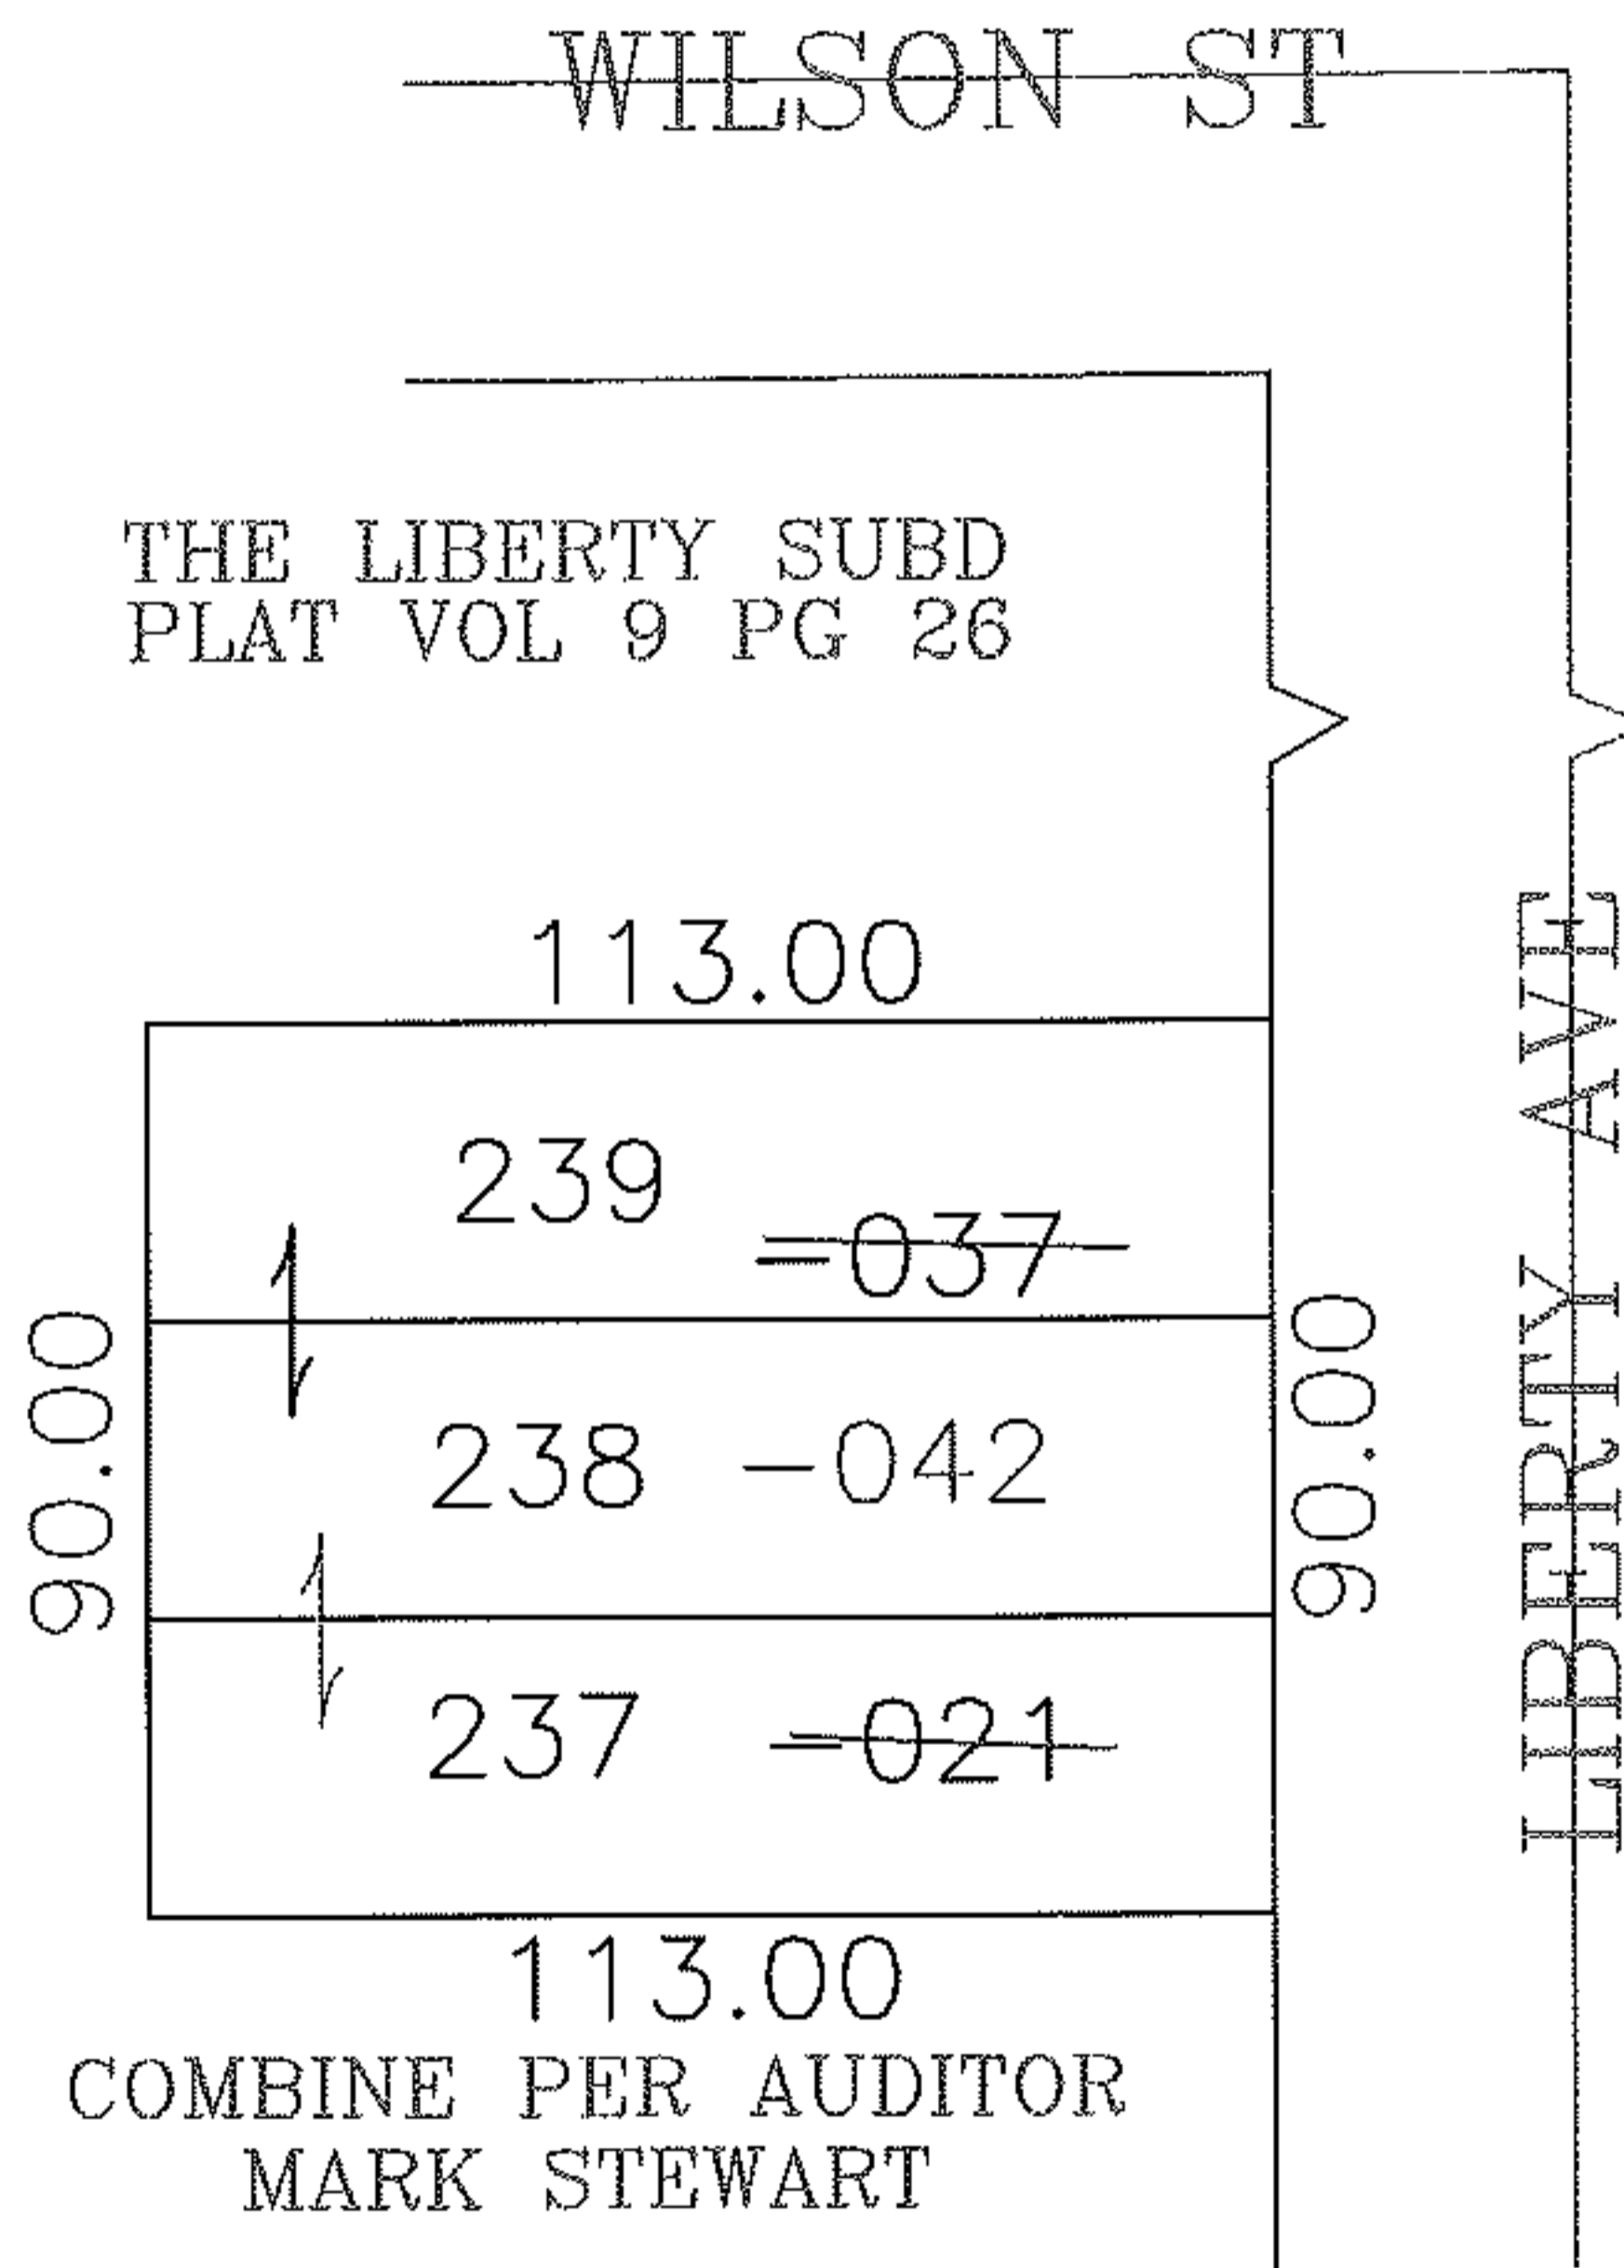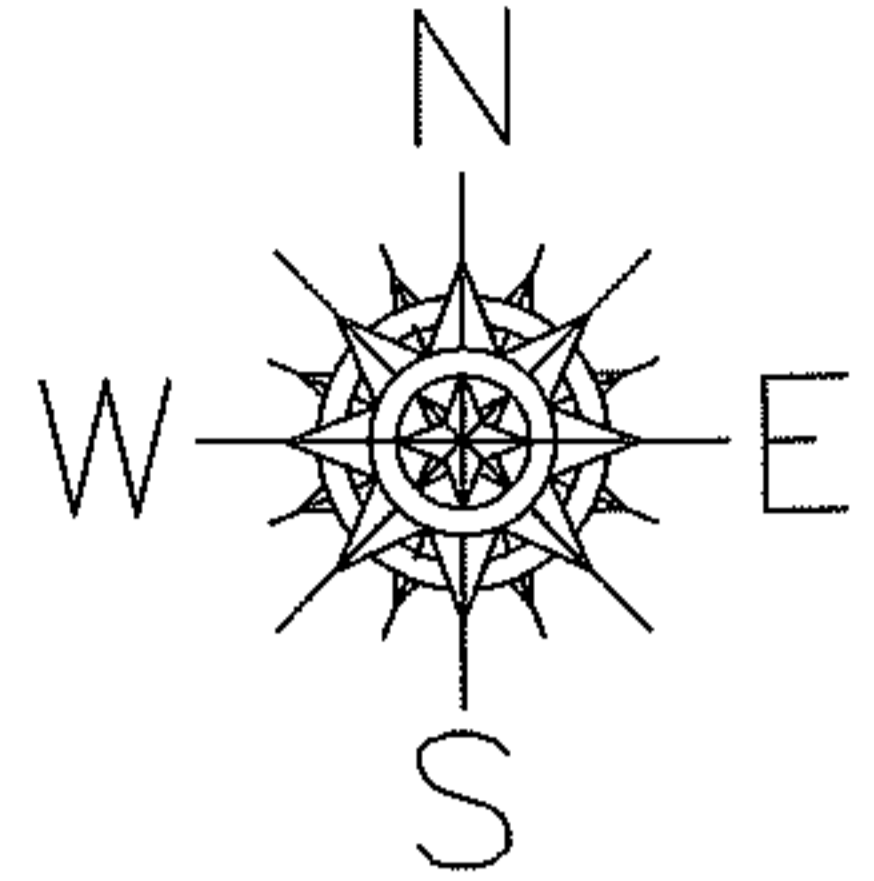

SPLITS/DEEDS PROCESSED

LORAIN COUNTY TAX MAP DEPARTMENT  
226 MIDDLE AVE. ELYRIA, OHIO

SURVEYED BY: COMB PER MARK STEWART

CLOSURE: N/A

MAP PAGE(S): 03-00-075-A

APPROVED BY: JAH DATE: 8-27-08

SCALE: 1" = 100' PRIOR INSTRUMENT: PL VL 9/26