


PARENT PARCEL: 03-00-040-125-069, -068, -067

CHILD PARCEL: 03-00-040-125-074

STARTING POINT: NO DESCRIPTION


08-02606

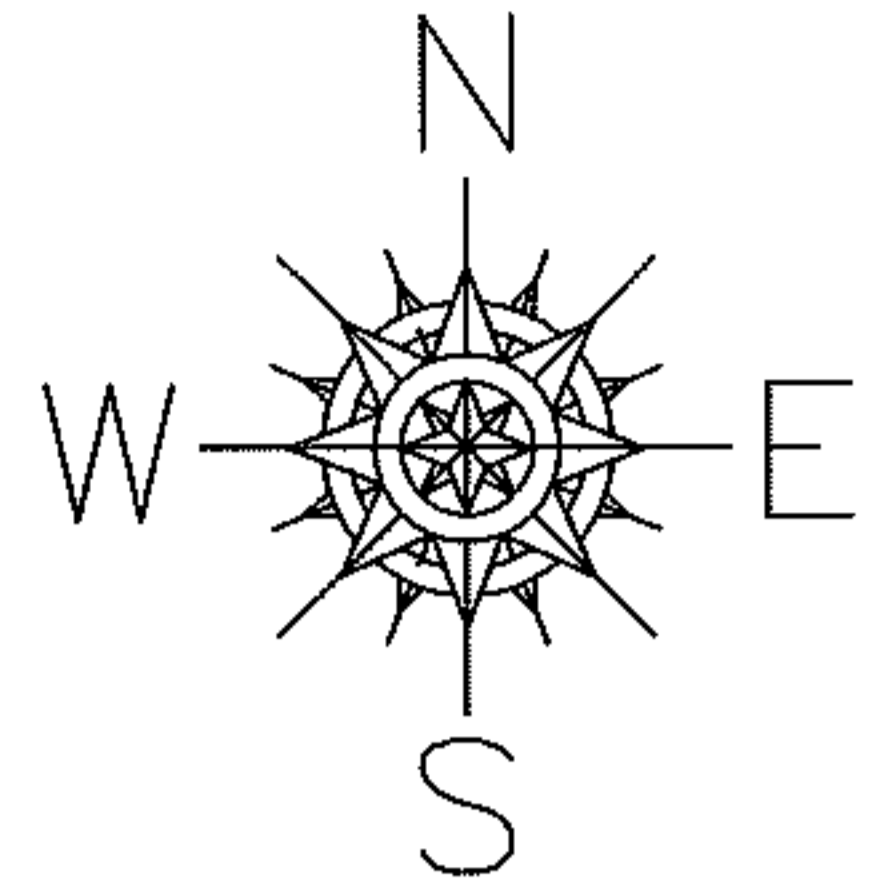

~~FERNDALE AVE~~

CLEVELAND BEACH ALLT
VOL 9 PG 30

100.00

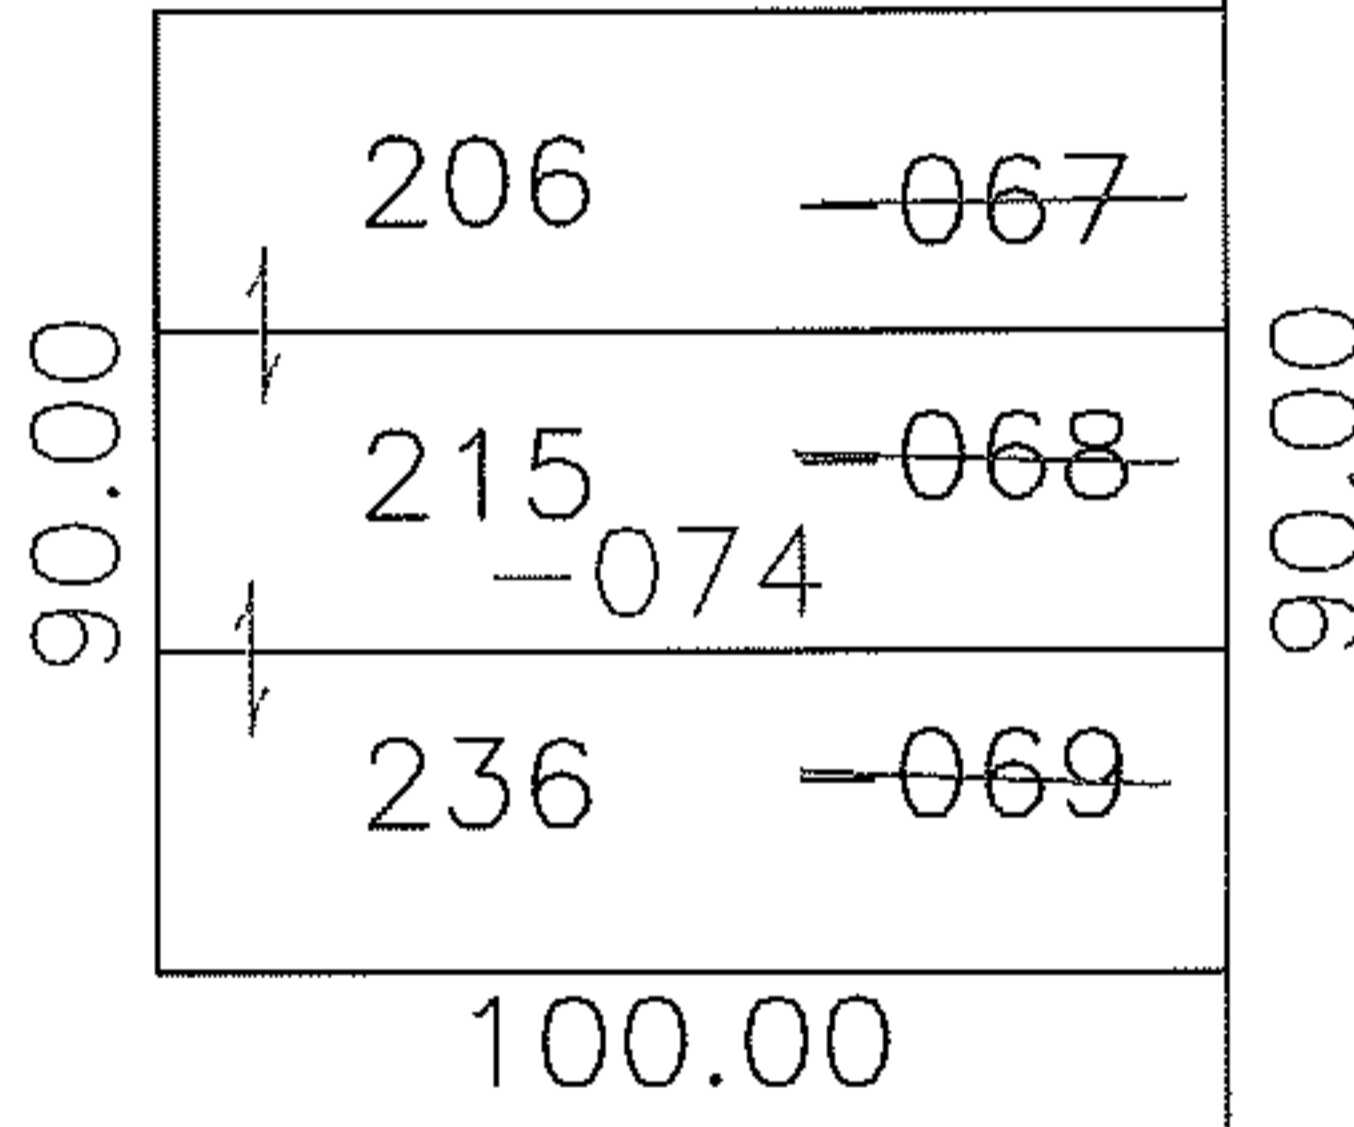

~~IDLEWOOD AVE~~

COMBINE PER AUDITOR
MARK STEWART

SPLITS/DEEDS PROCESSED

LORAIN COUNTY TAX MAP DEPARTMENT
226 MIDDLE AVE. ELYRIA, OHIO

SURVEYED BY: COMBINE PER MARK STEWART

CLOSURE: N/A

MAP PAGE(S): 03-00-040

APPROVED BY: JAH DATE: 8-27-08

SCALE: 1" = 100 PRIOR INSTRUMENT: PL VL 9/30