
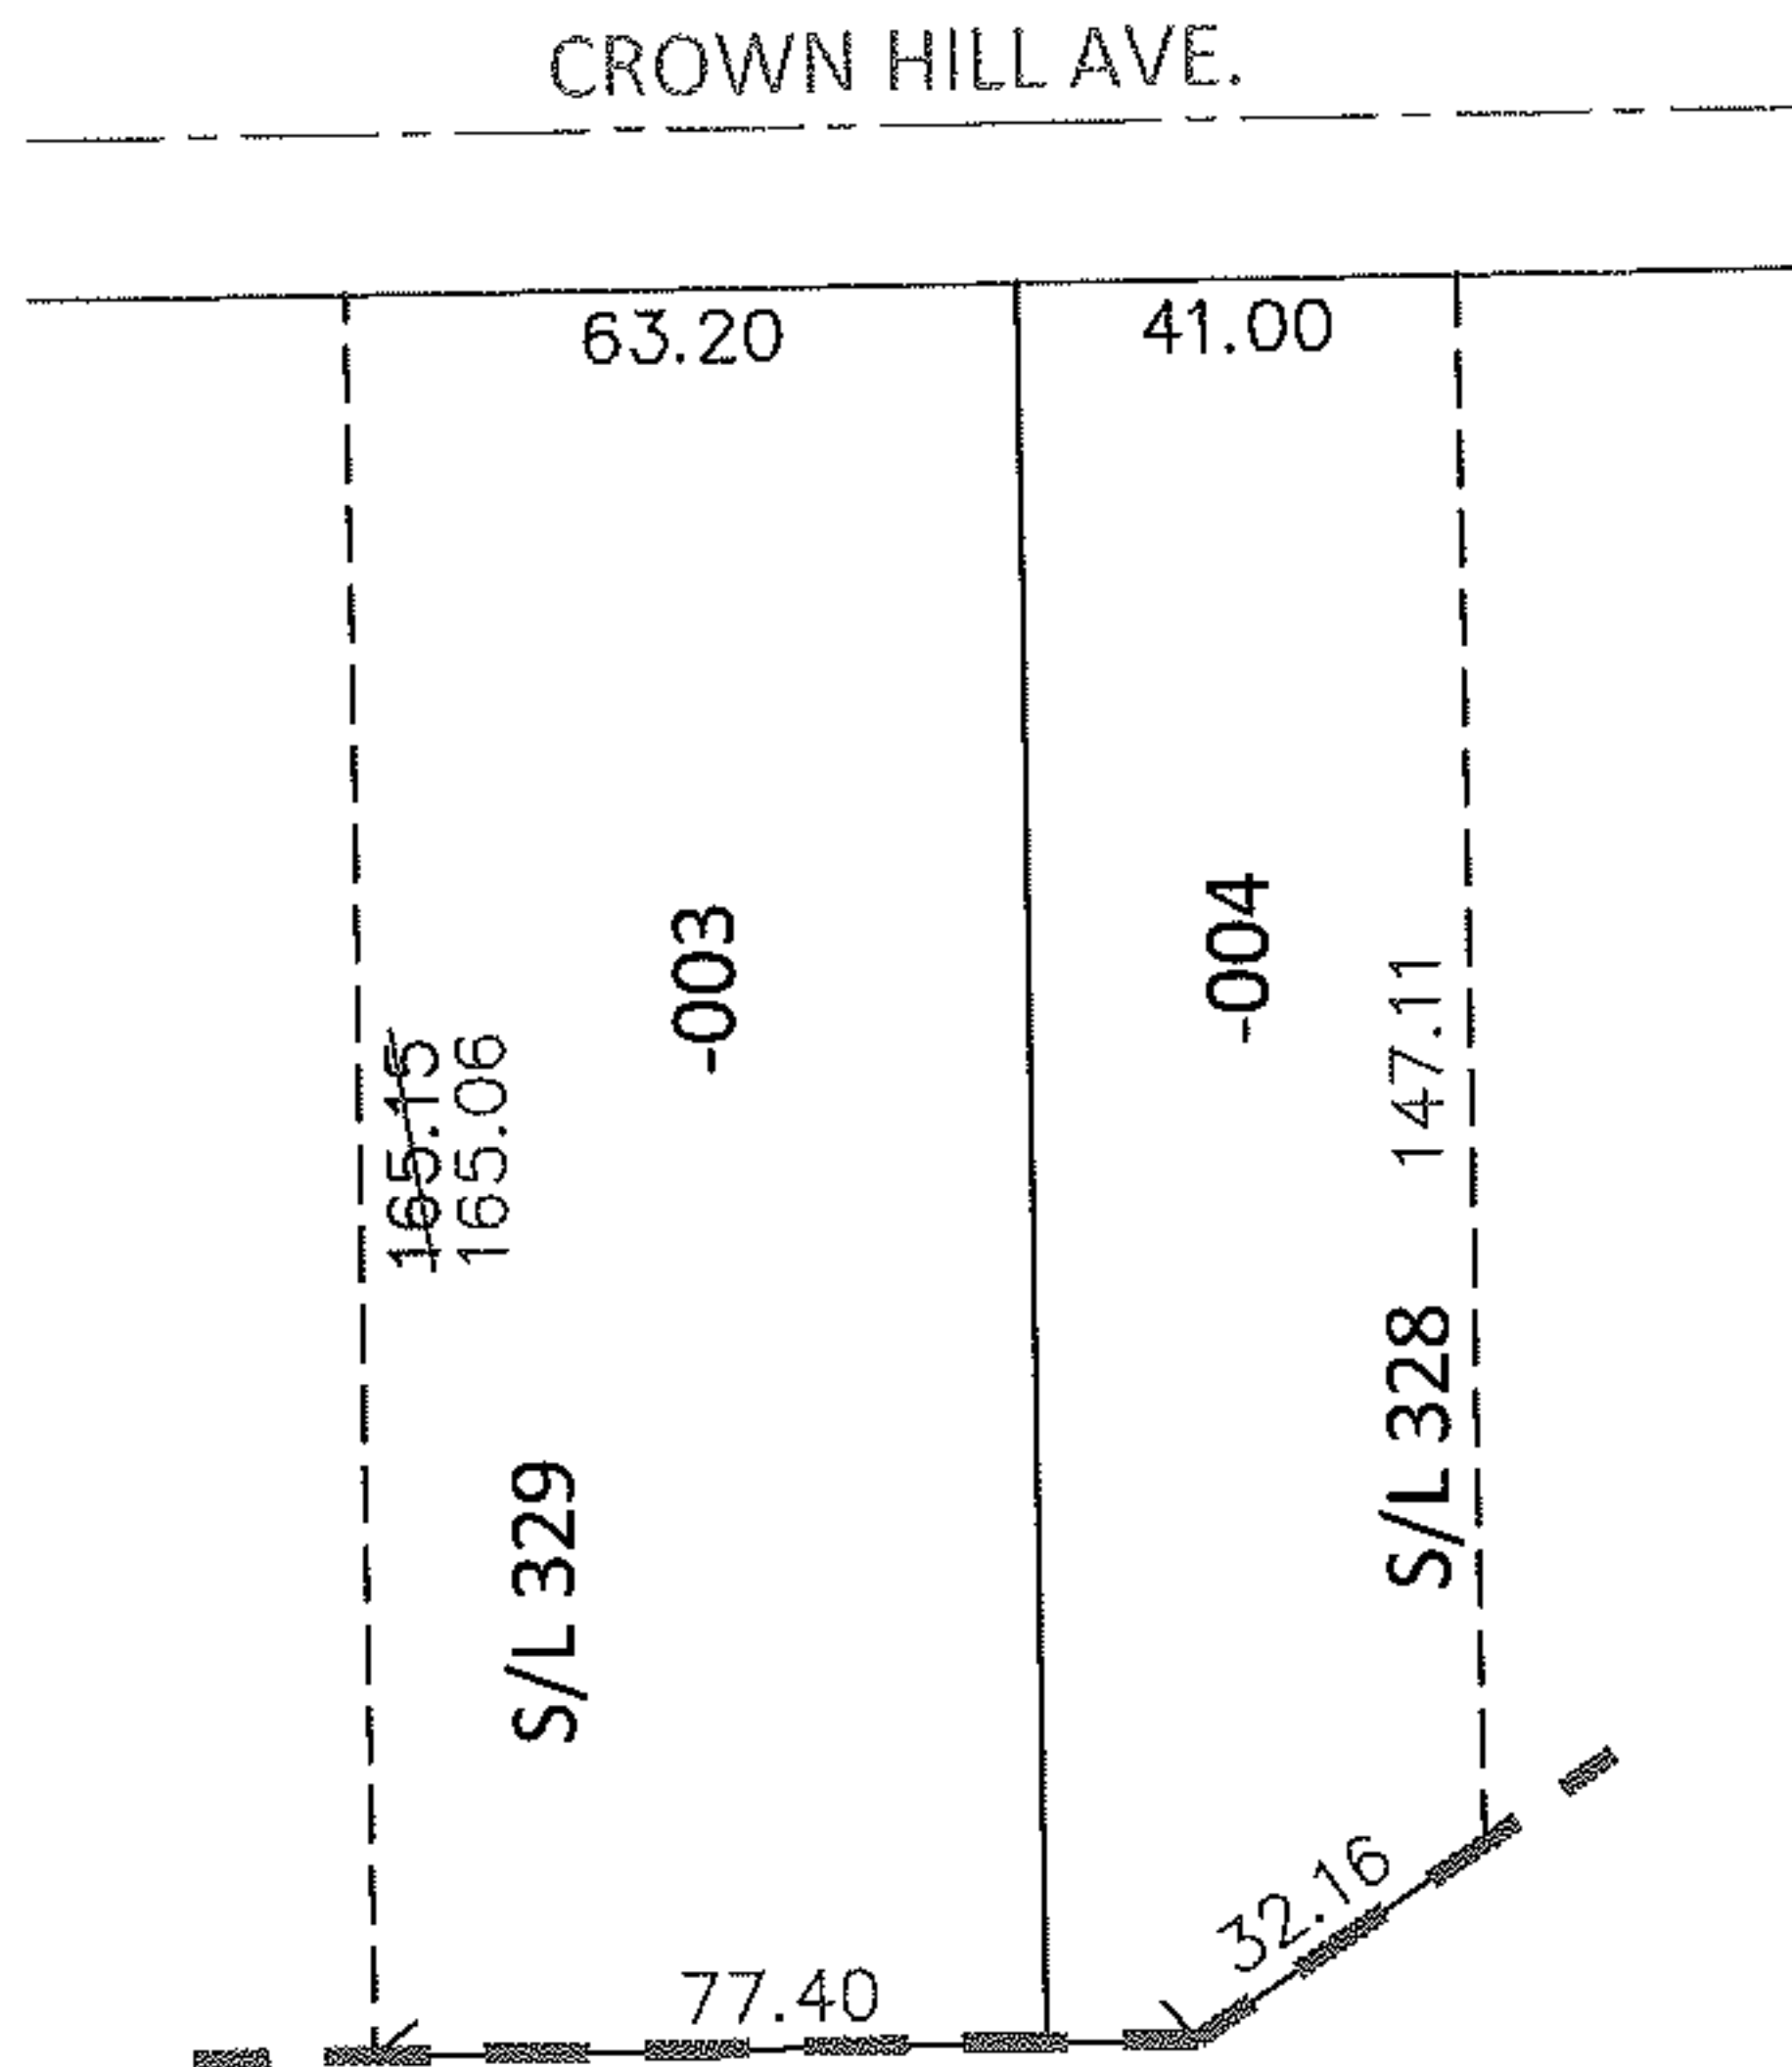


PARENT PARCEL: 05-00-024-116-003, -004

CHILD PARCEL: _____

STARTING POINT: NORTHWEST CORNER OF S/L 328 IN JOHN C. BARNEY'S ADD.(VOL.2 PG.7)

12-02607-D

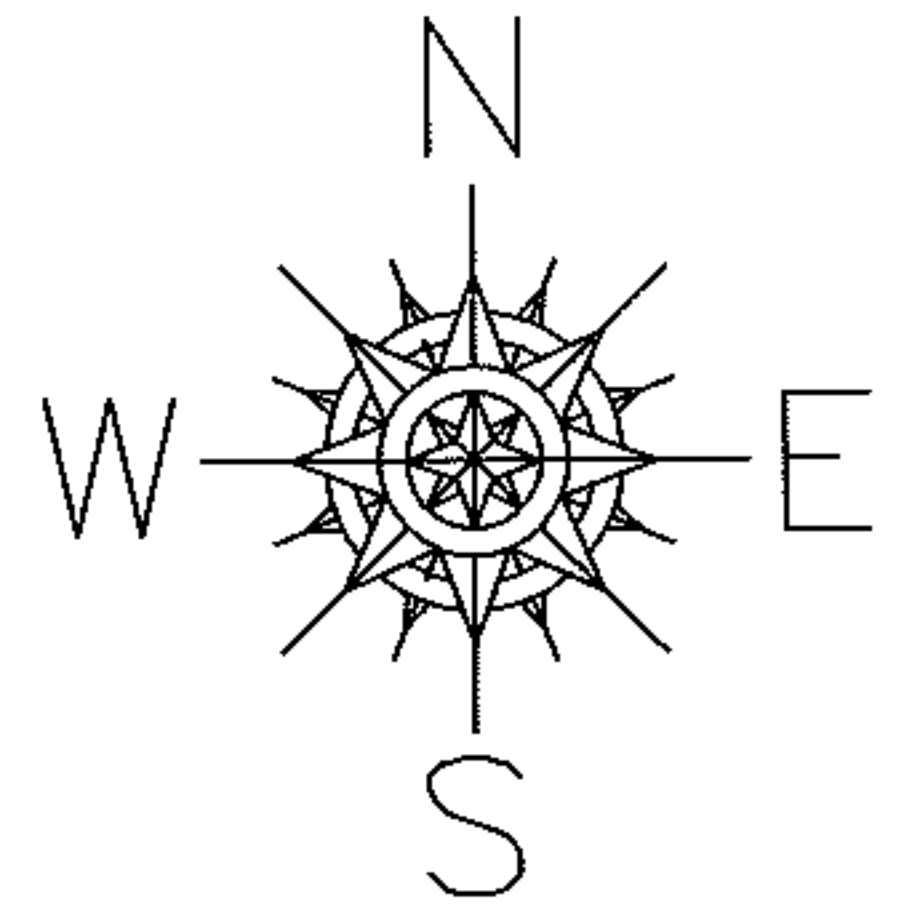

DEPTH CORRECTION

05-00-024-116-003

05-00-024-116-004

165.06

41 X 165

63.20 X ~~165~~

PER SURV. J.YURKSCHATT

SPLITS/DEEDS PROCESSED

LORAIN COUNTY TAX MAP DEPARTMENT
226 MIDDLE AVE. ELYRIA, OHIO

SURVEYED BY: JAMES P. YURKSCHATT

CLOSURE: .01:10,000

MAP PAGE(S): 5-00-024-A

APPROVED BY: RRM DATE: 10-31-12

SCALE: 1" = 50' PRIOR INST.: 20120424467