

RASTER




PARENT PARCEL: *SEE BELOW

CHILD PARCEL: 07-00-032-000-645, -646

STARTING POINT: CENTERLINE OF STONEY RIDGE RD & O.L. 31

08-02607

- *07-00-029-000-001
- 07-00-030-000-094
- 07-00-031-000-120
- 07-00-032-000-014

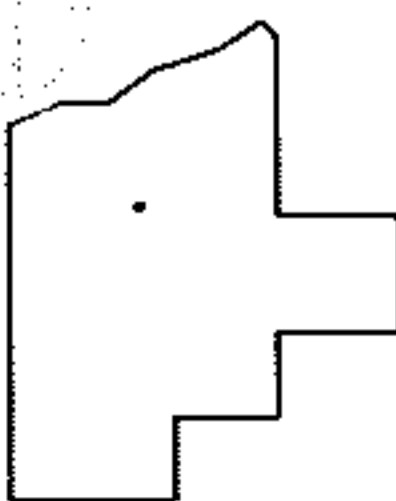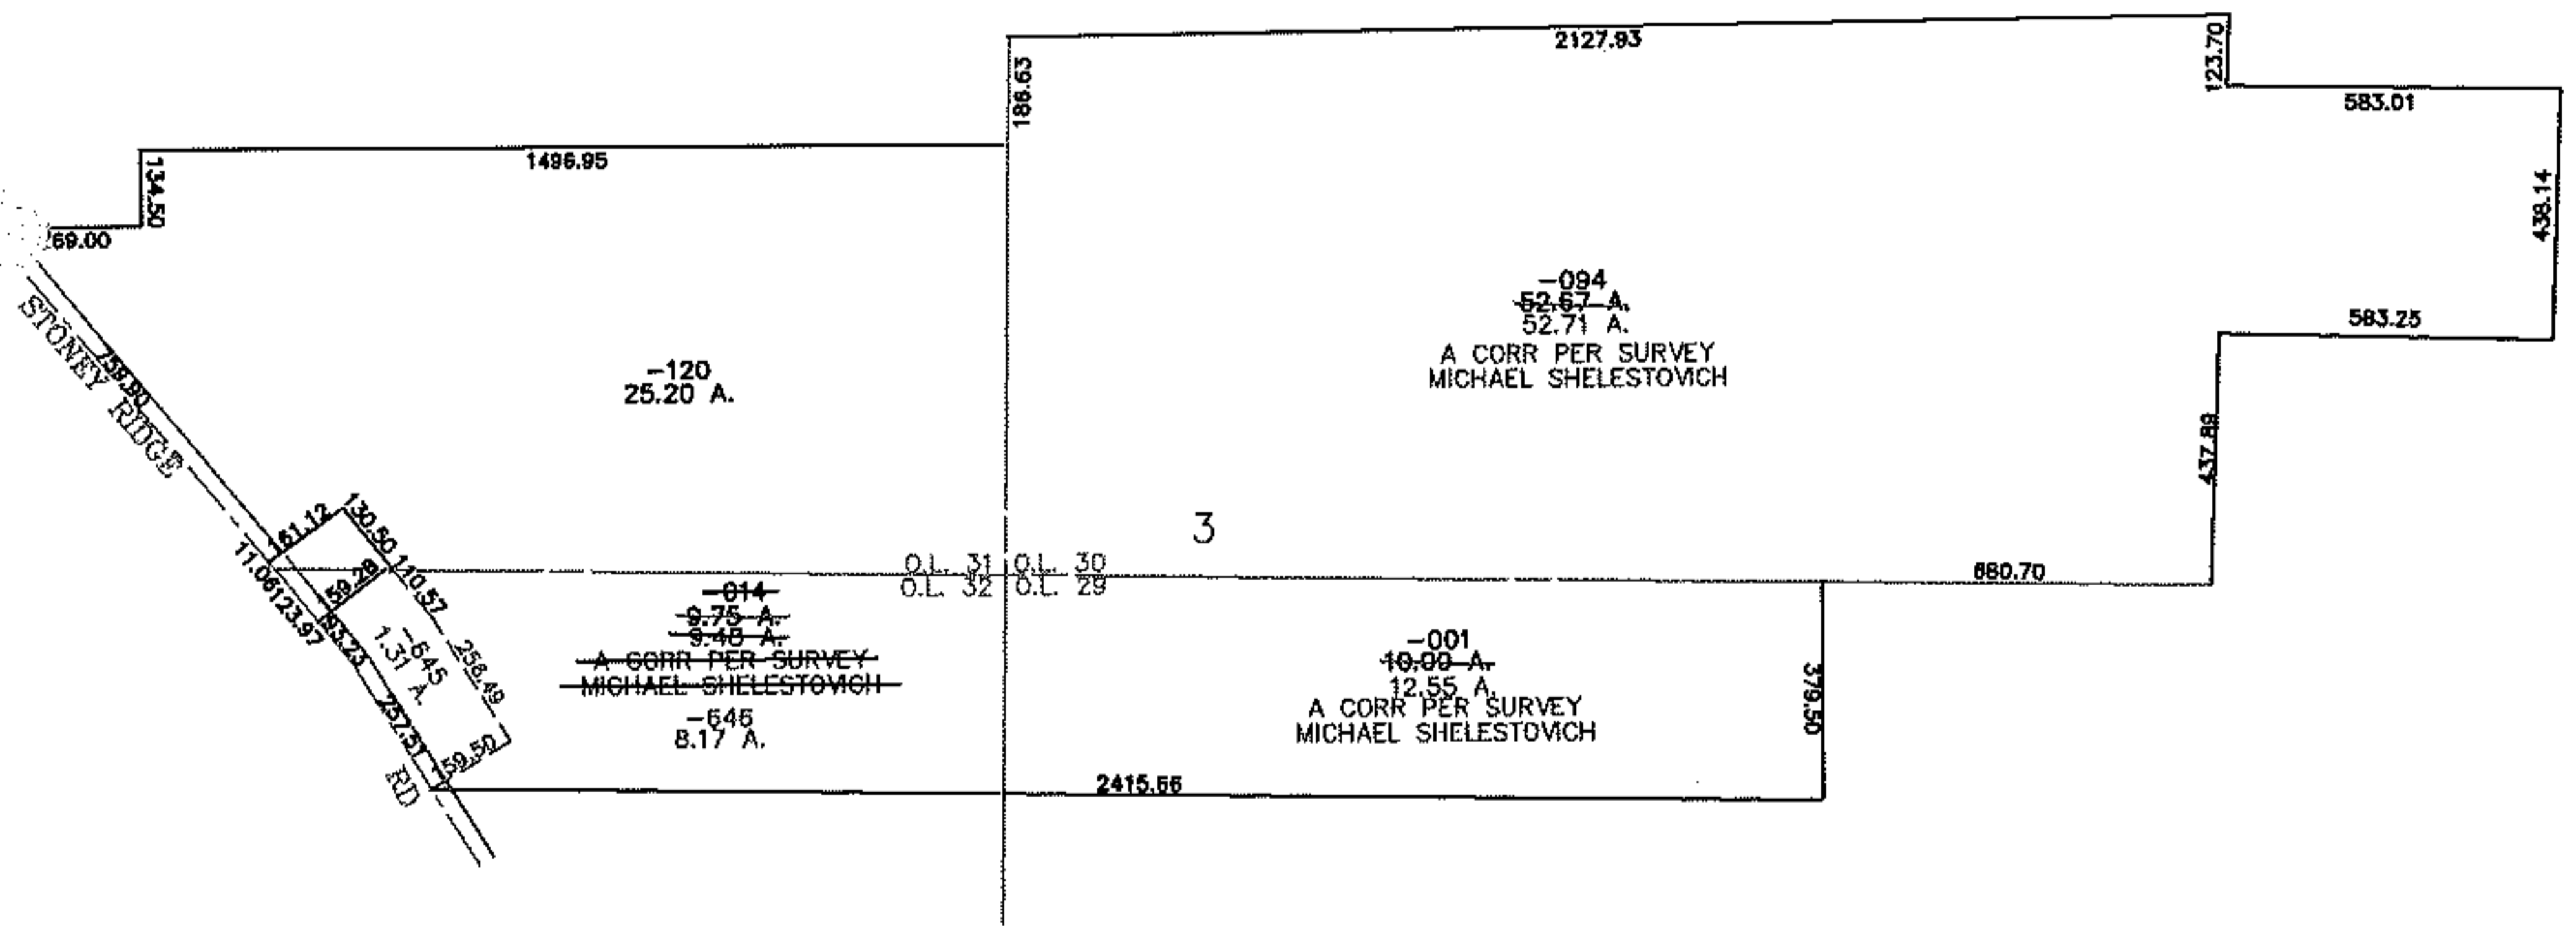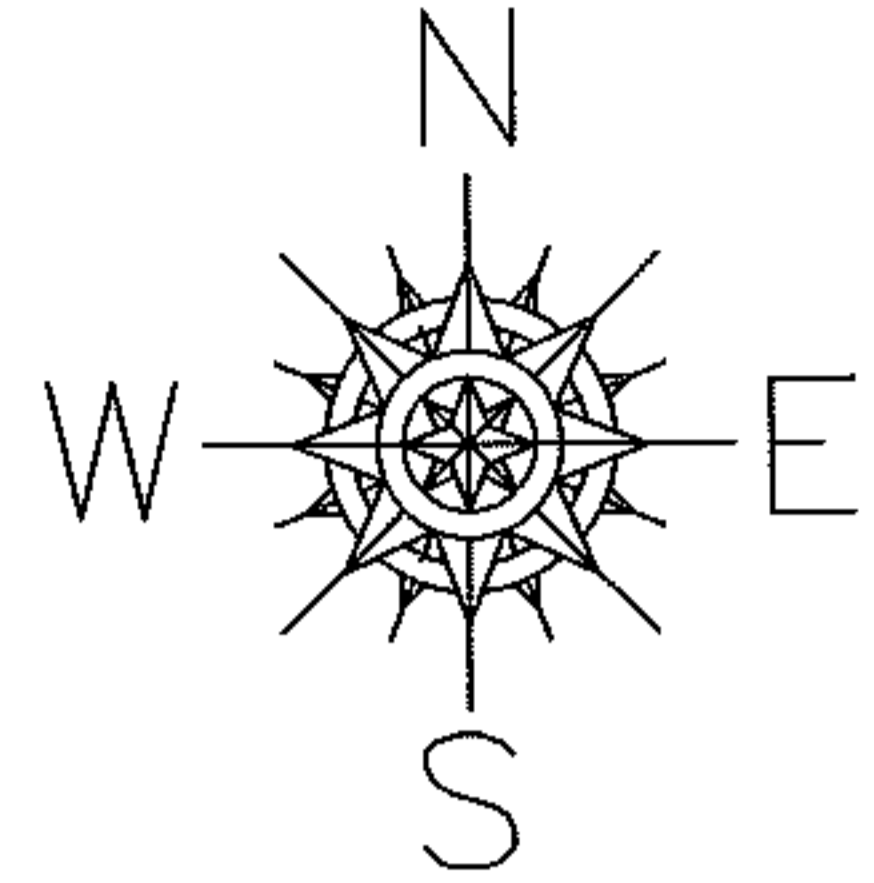

SPLITS/DEEDS PROCESSED

LORAIN COUNTY TAX MAP DEPARTMENT
226 MIDDLE AVE. ELYRIA, OHIO

SURVEYED BY: MICHAEL SHELESTOVICH

CLOSURE: 0.00 : 10.000

MAP PAGE(S): 07-029-A 030-C 031-D 032-B

APPROVED BY: JAH DATE: 9-8-08

SCALE: 1" = 600 PRIOR INSTRUMENT: 20080255985