

RASTER




PARENT PARCEL: 04-00-003-101-089

CHILD PARCEL: 04-00-003-101-448 THRU -453

STARTING POINT: EASTERLY LINE OF SHEFFIELD OL 7 & NORTHERLY LINE OF AVON TWP OL 3

08-02608

SHEFFIELD TWP

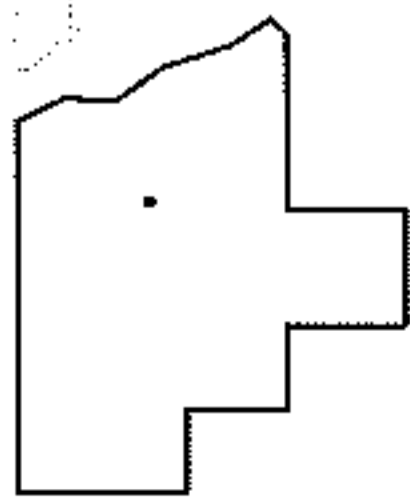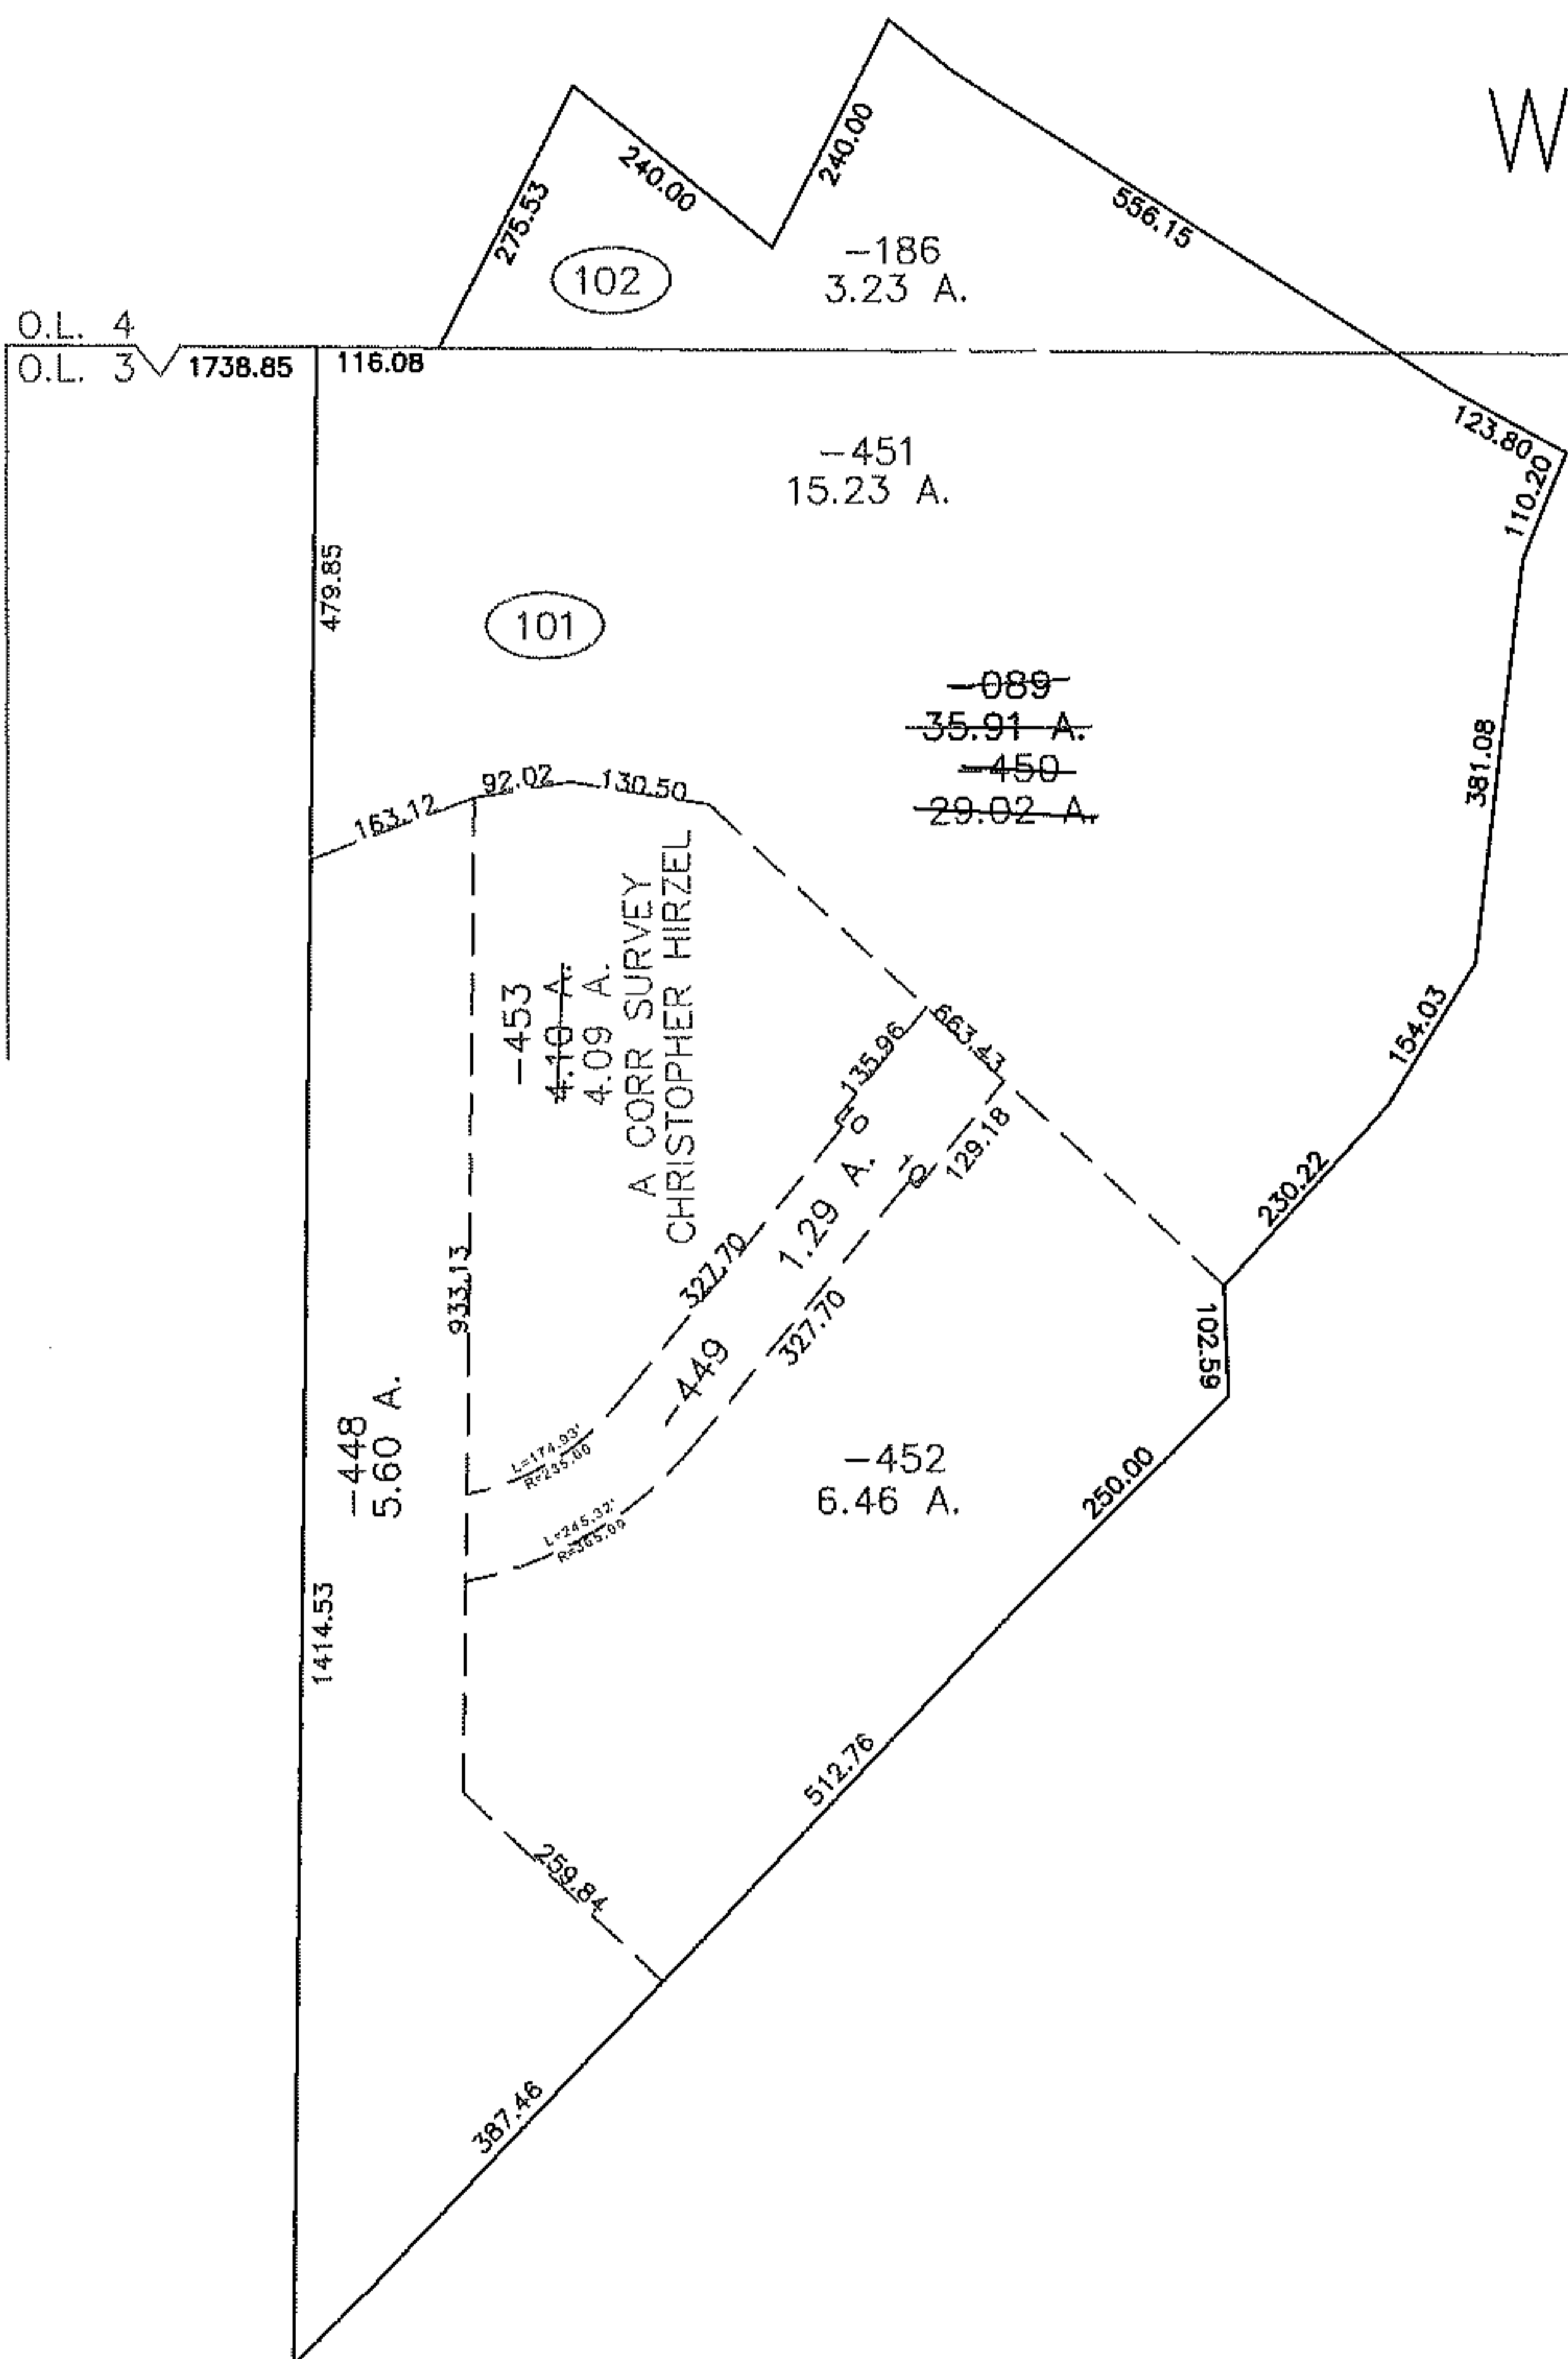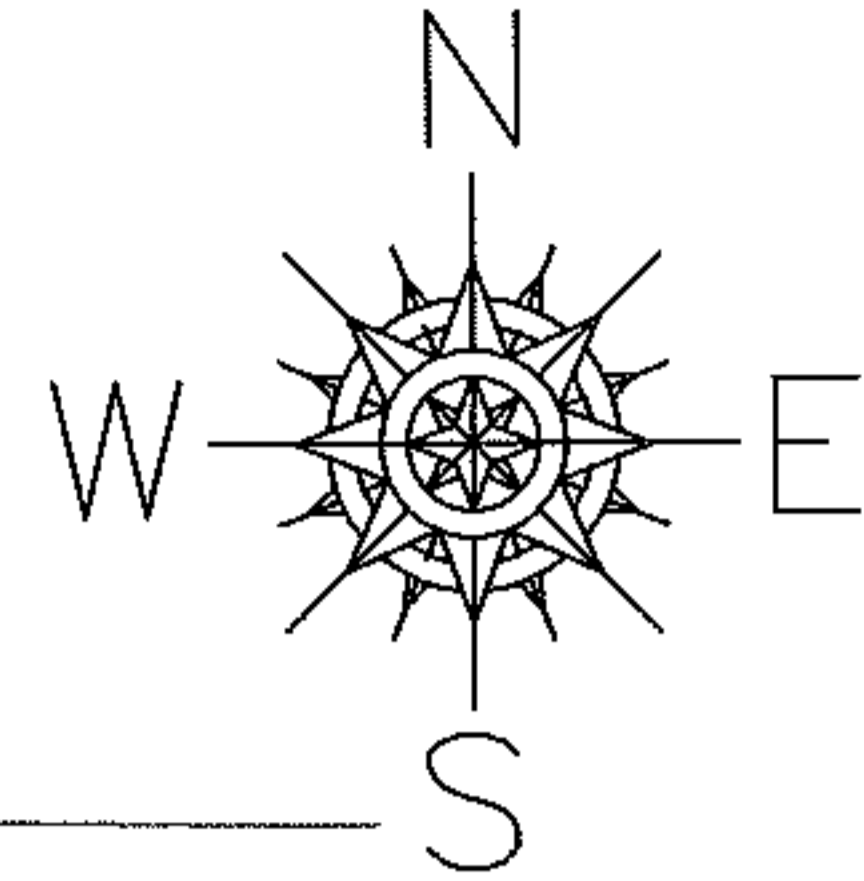

SPLITS/DEEDS PROCESSED
 LORAIN COUNTY TAX MAP DEPARTMENT
 226 MIDDLE AVE. ELYRIA, OHIO

SURVEYED BY: CHRISTOPHER HIRZEL
 CLOSURE: 0.00 : 10,000
 MAP PAGE(S): 04-00-003-B 004-F
 APPROVED BY: JAH DATE: 8-28-08
 SCALE: 1" = 300 PRIOR INSTRUMENT: 20020833557