




RASTER

PARENT PARCEL: 04-00-012-103-265, -288

CHILD PARCEL: 04-00-012-103-290 THRU -292

STARTING POINT: SW CORNER OF SOUTH PARK DR IN THE WEST LINE OF HIGHLAND PARK SUB

08-02609

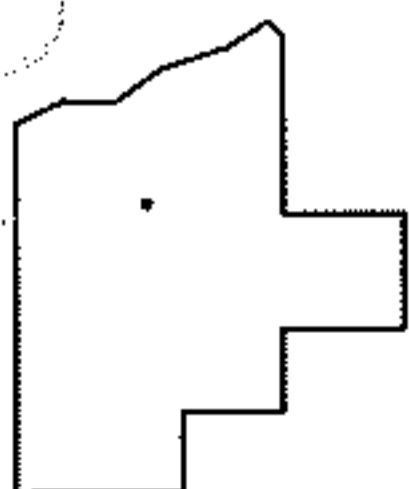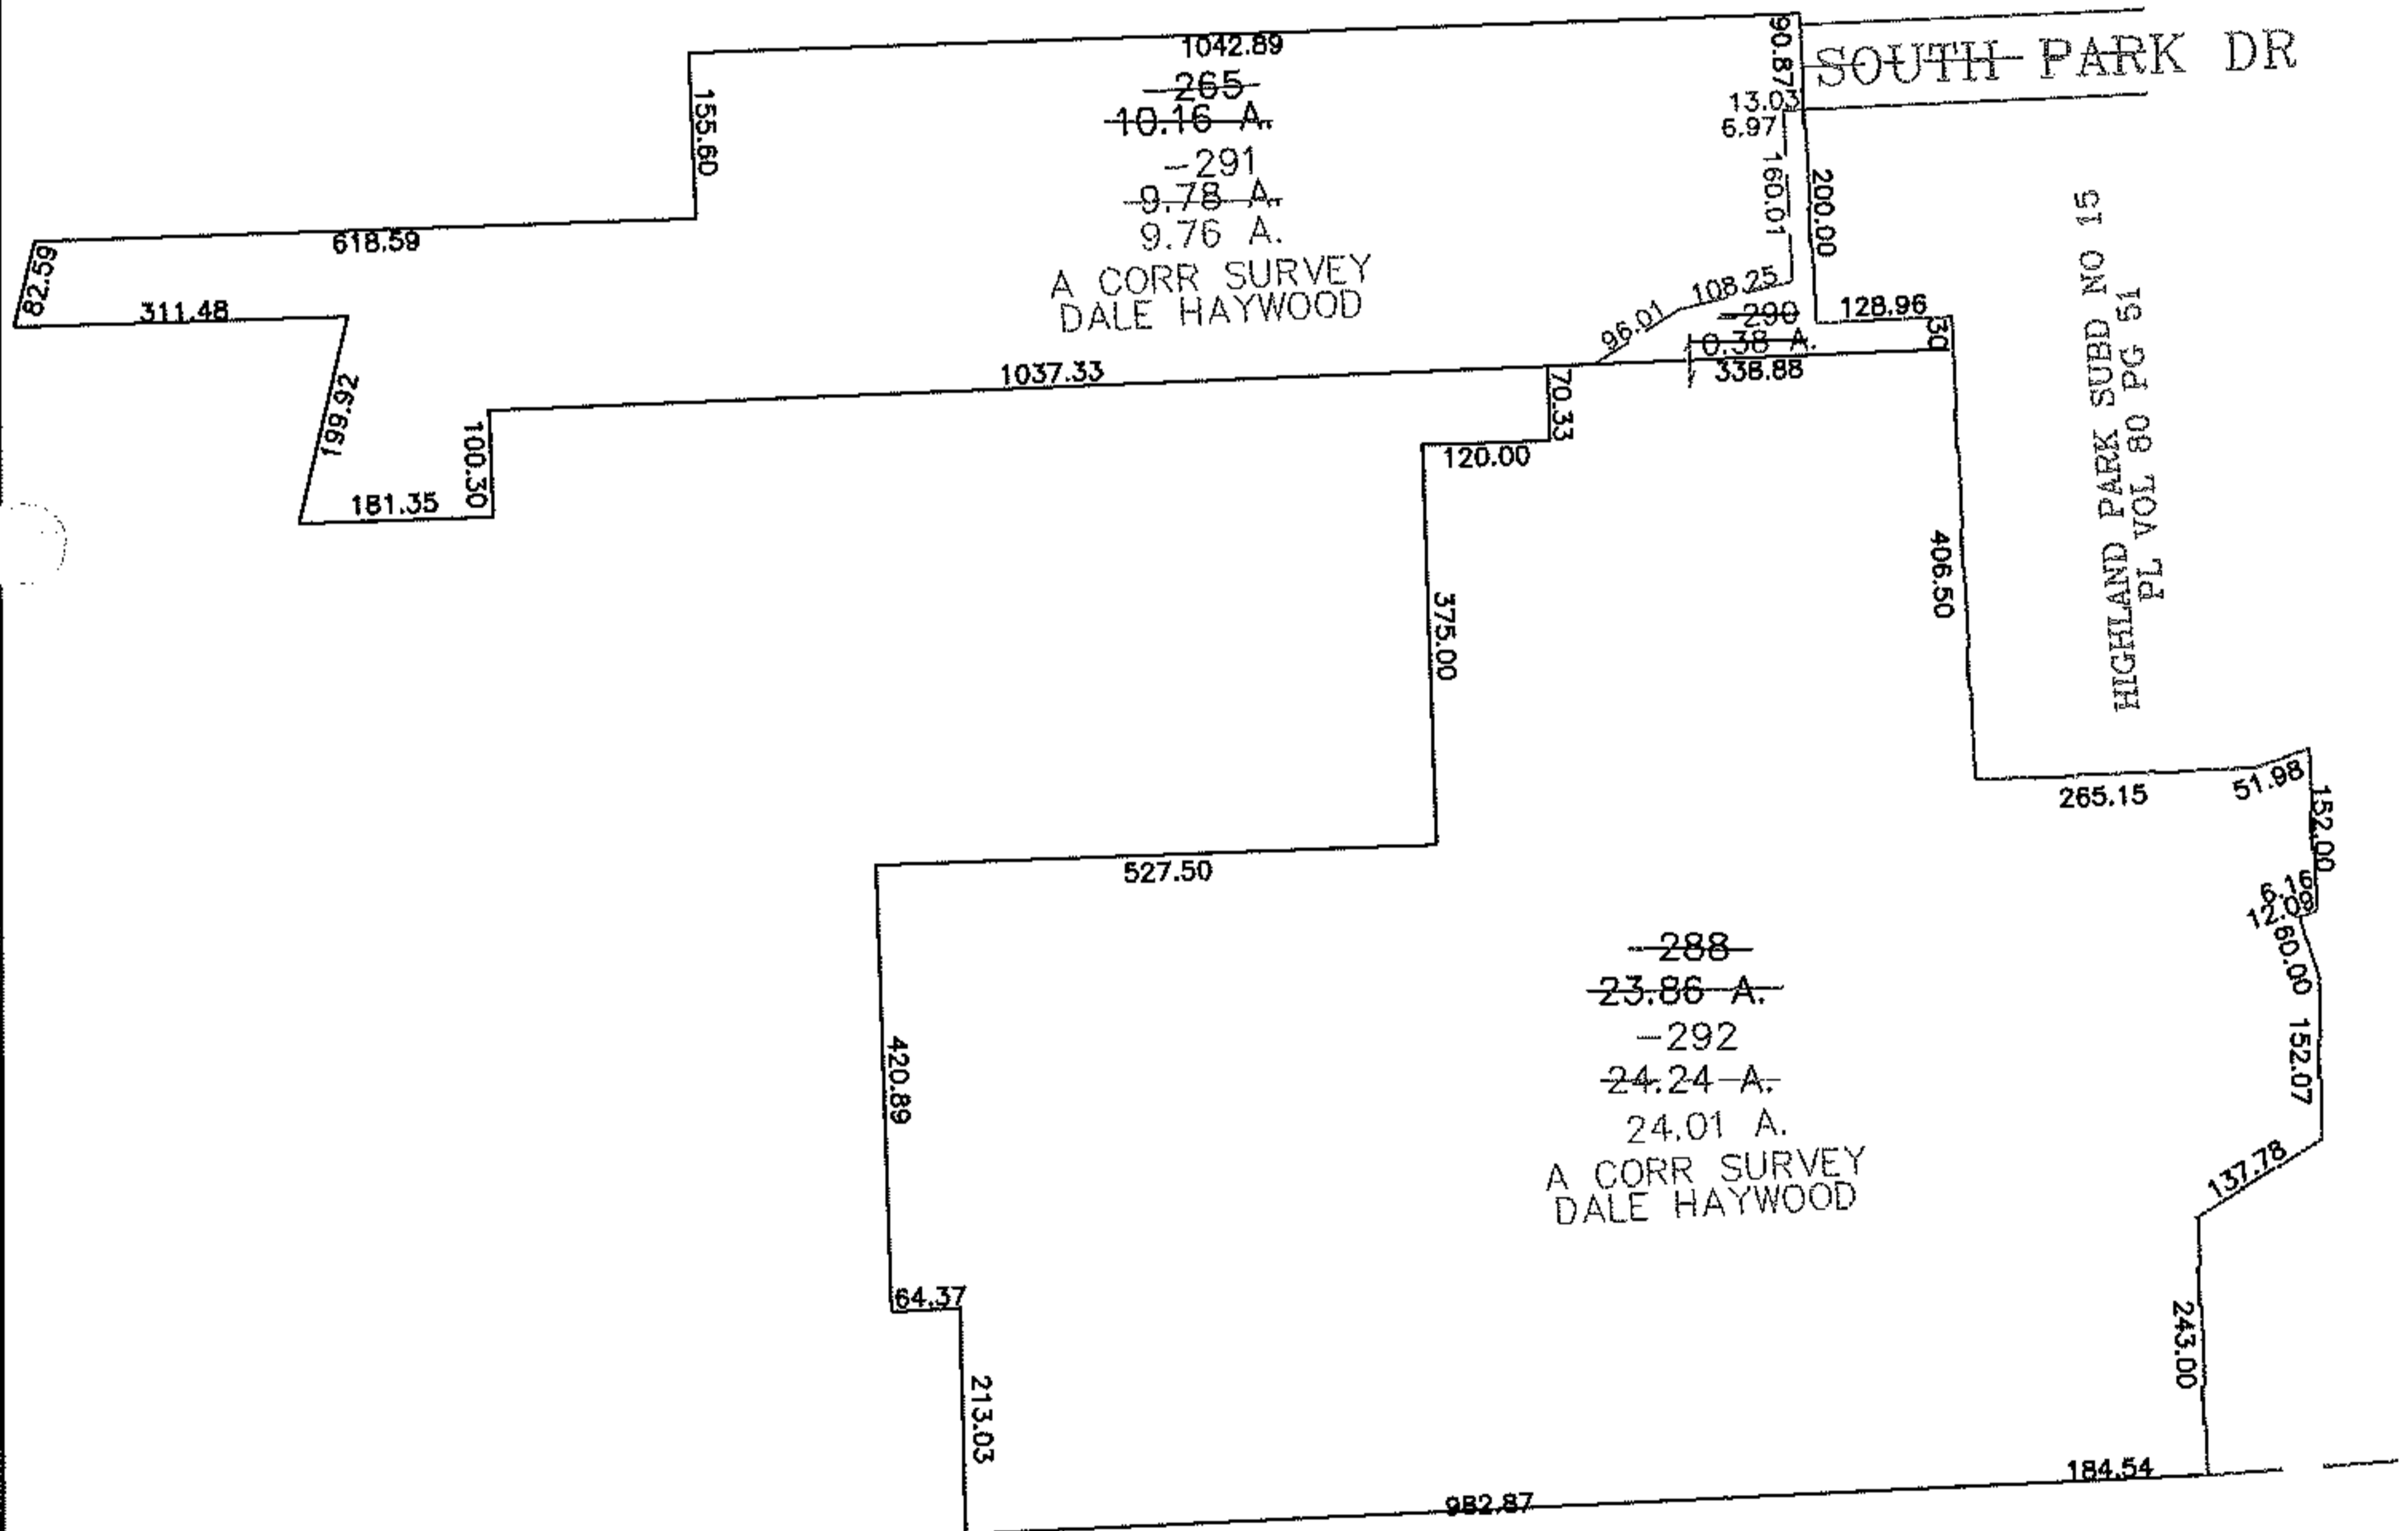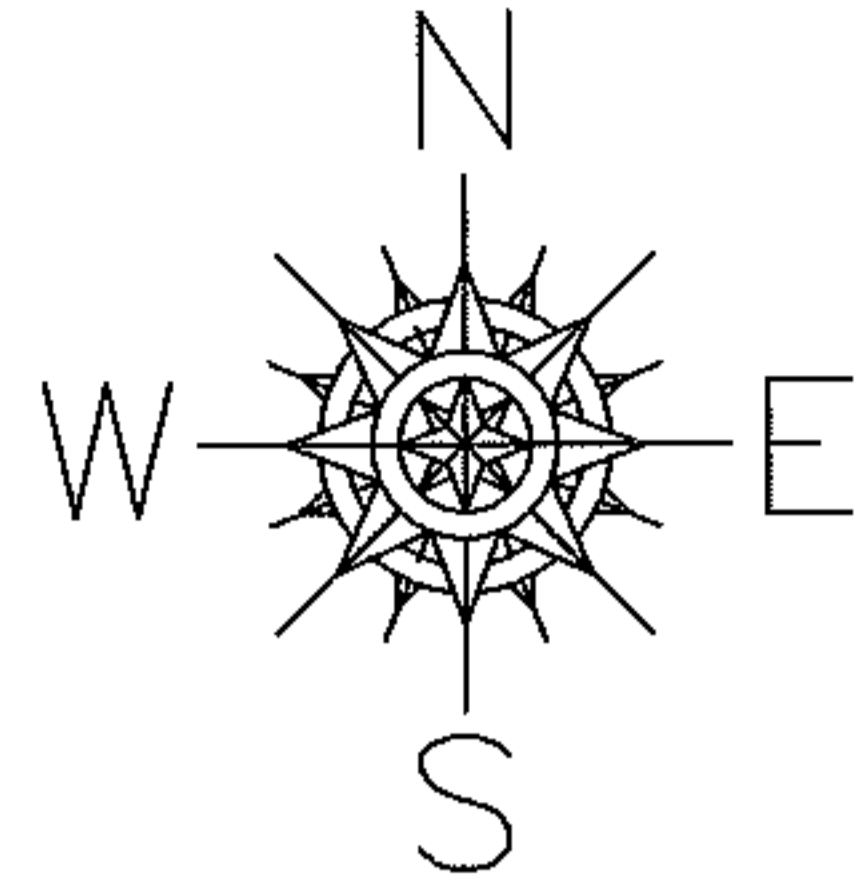

**SPLITS/DEEDS PROCESSED**  
 LORAIN COUNTY TAX MAP DEPARTMENT  
 226 MIDDLE AVE. ELYRIA, OHIO

SURVEYED BY: DALE HAYWOOD  
 CLOSURE: 0.00 : 10.000  
 MAP PAGE(S): 04-00-012-G  
 APPROVED BY: JAH DATE: 8-28-08  
 SCALE: 1" = 300 PRIOR INSTRUMENT: 20040010817