
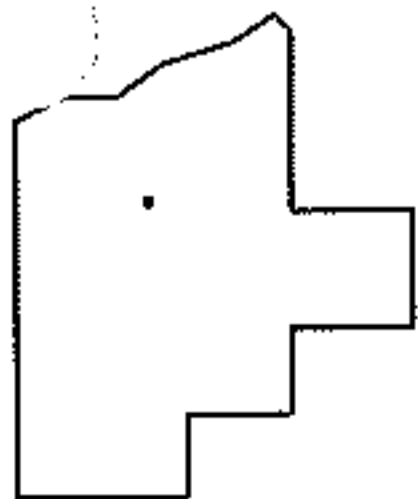
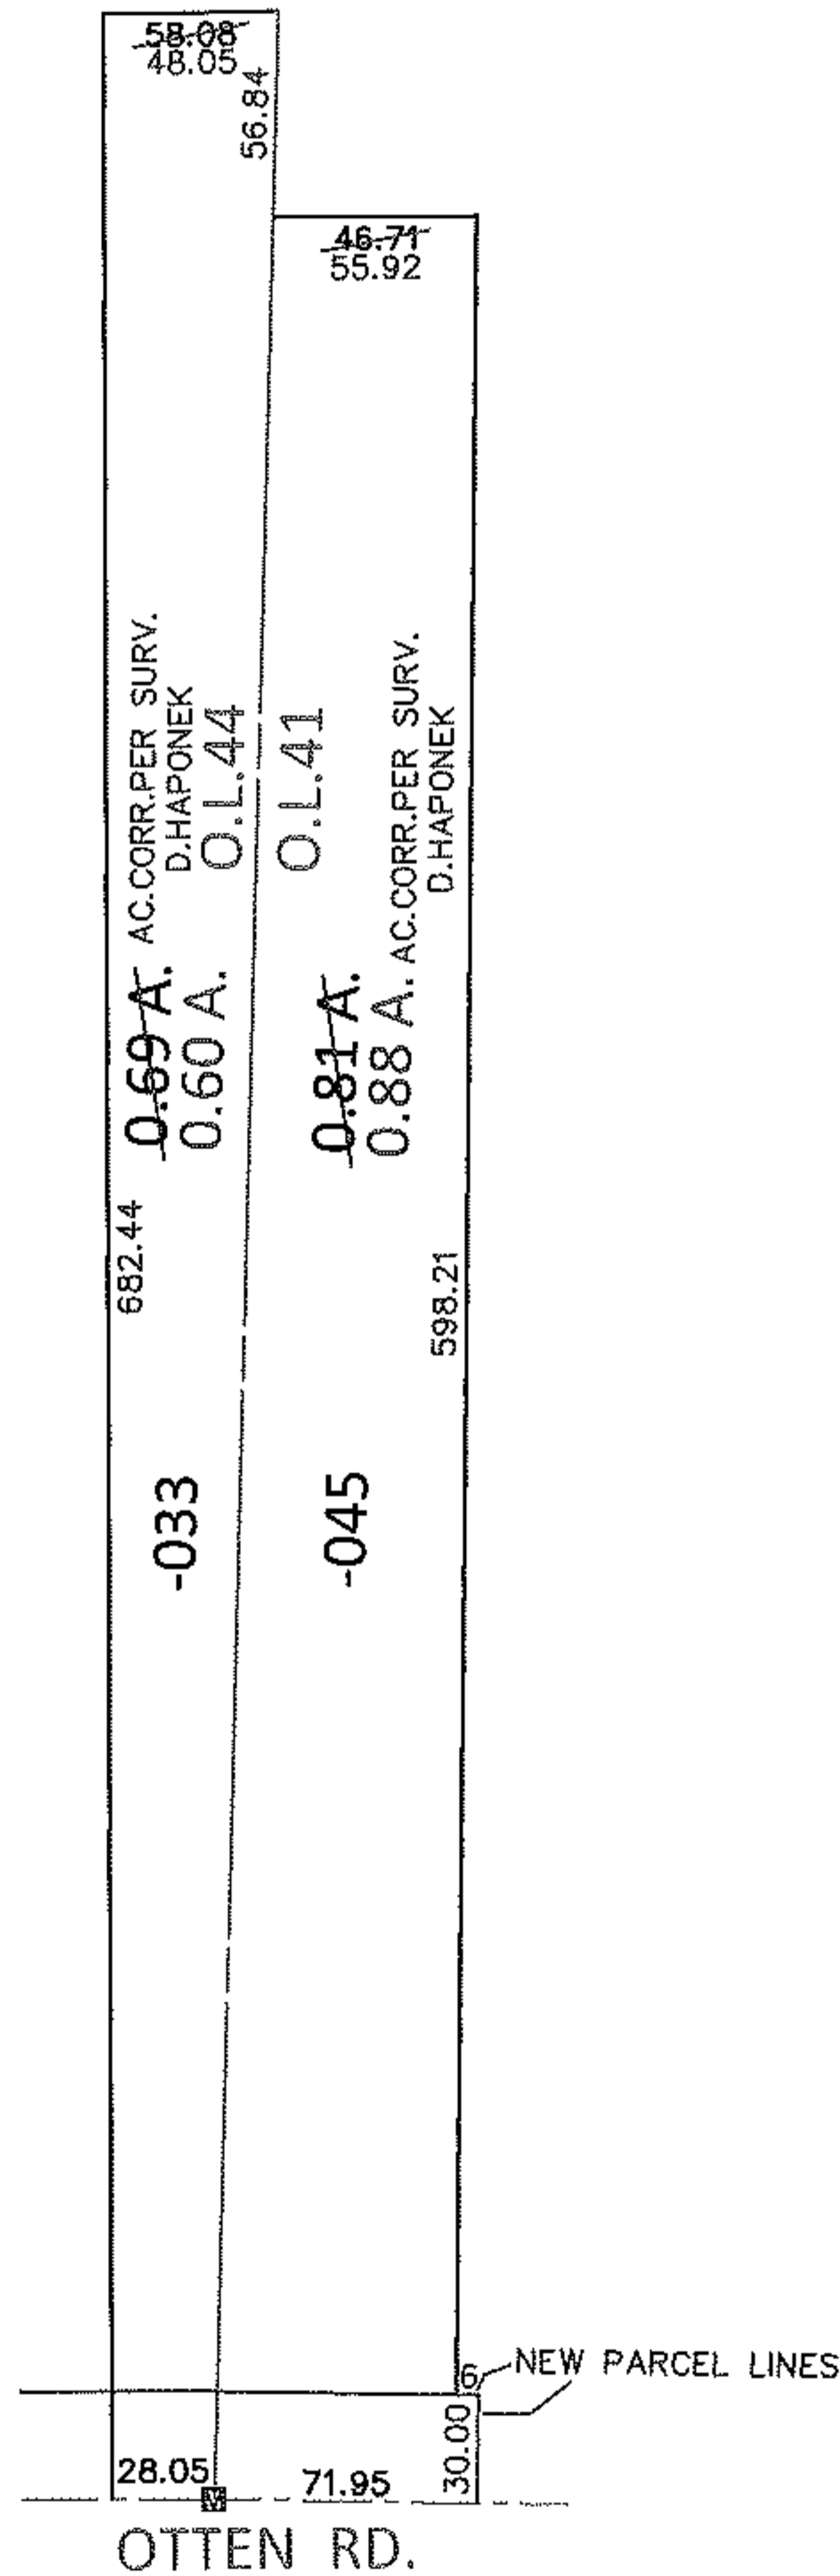


PARENT PARCEL: 07-00-041-000-045, 07-00-044-103-033

12-02610-A

CHILD PARCEL: \_\_\_\_\_

STARTING POINT: AT A MON BOX AT THE SOUTHEAST CORNER OF O.L.44 IN THE C/L OF OTTEN RD.

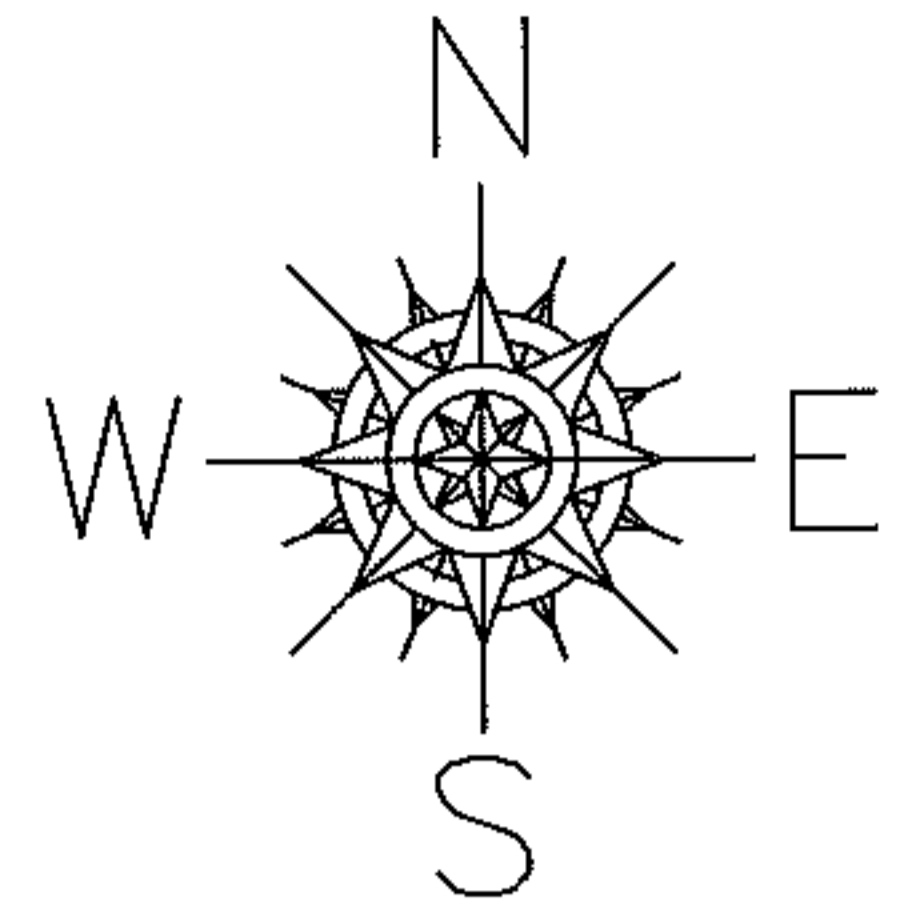

**SPLITS/DEEDS PROCESSED**

LORAIN COUNTY TAX MAP DEPARTMENT  
226 MIDDLE AVE. ELYRIA, OHIO

SURVEYED BY: DANE A. HAPONEK

CLOSURE: .01:10,000

MAP PAGE(S): 7-A, 7-00-044-D

APPROVED BY: RRM DATE: 11-15-12

SCALE: 1"= 100 PRIOR INST.: 20040034708