

RASTER

PARENT PARCEL: 03-00-094-107-002



12-02611-C

CHILD PARCEL:

STARTING POINT: 50FT. NORTH OF INTERSECTION OF WEST LINE OF GROVE AVE. AND NORTH LINE OF E.36TH ST.


MAP CORRECTION ONLY

PER DEED VOL.540 PG.387

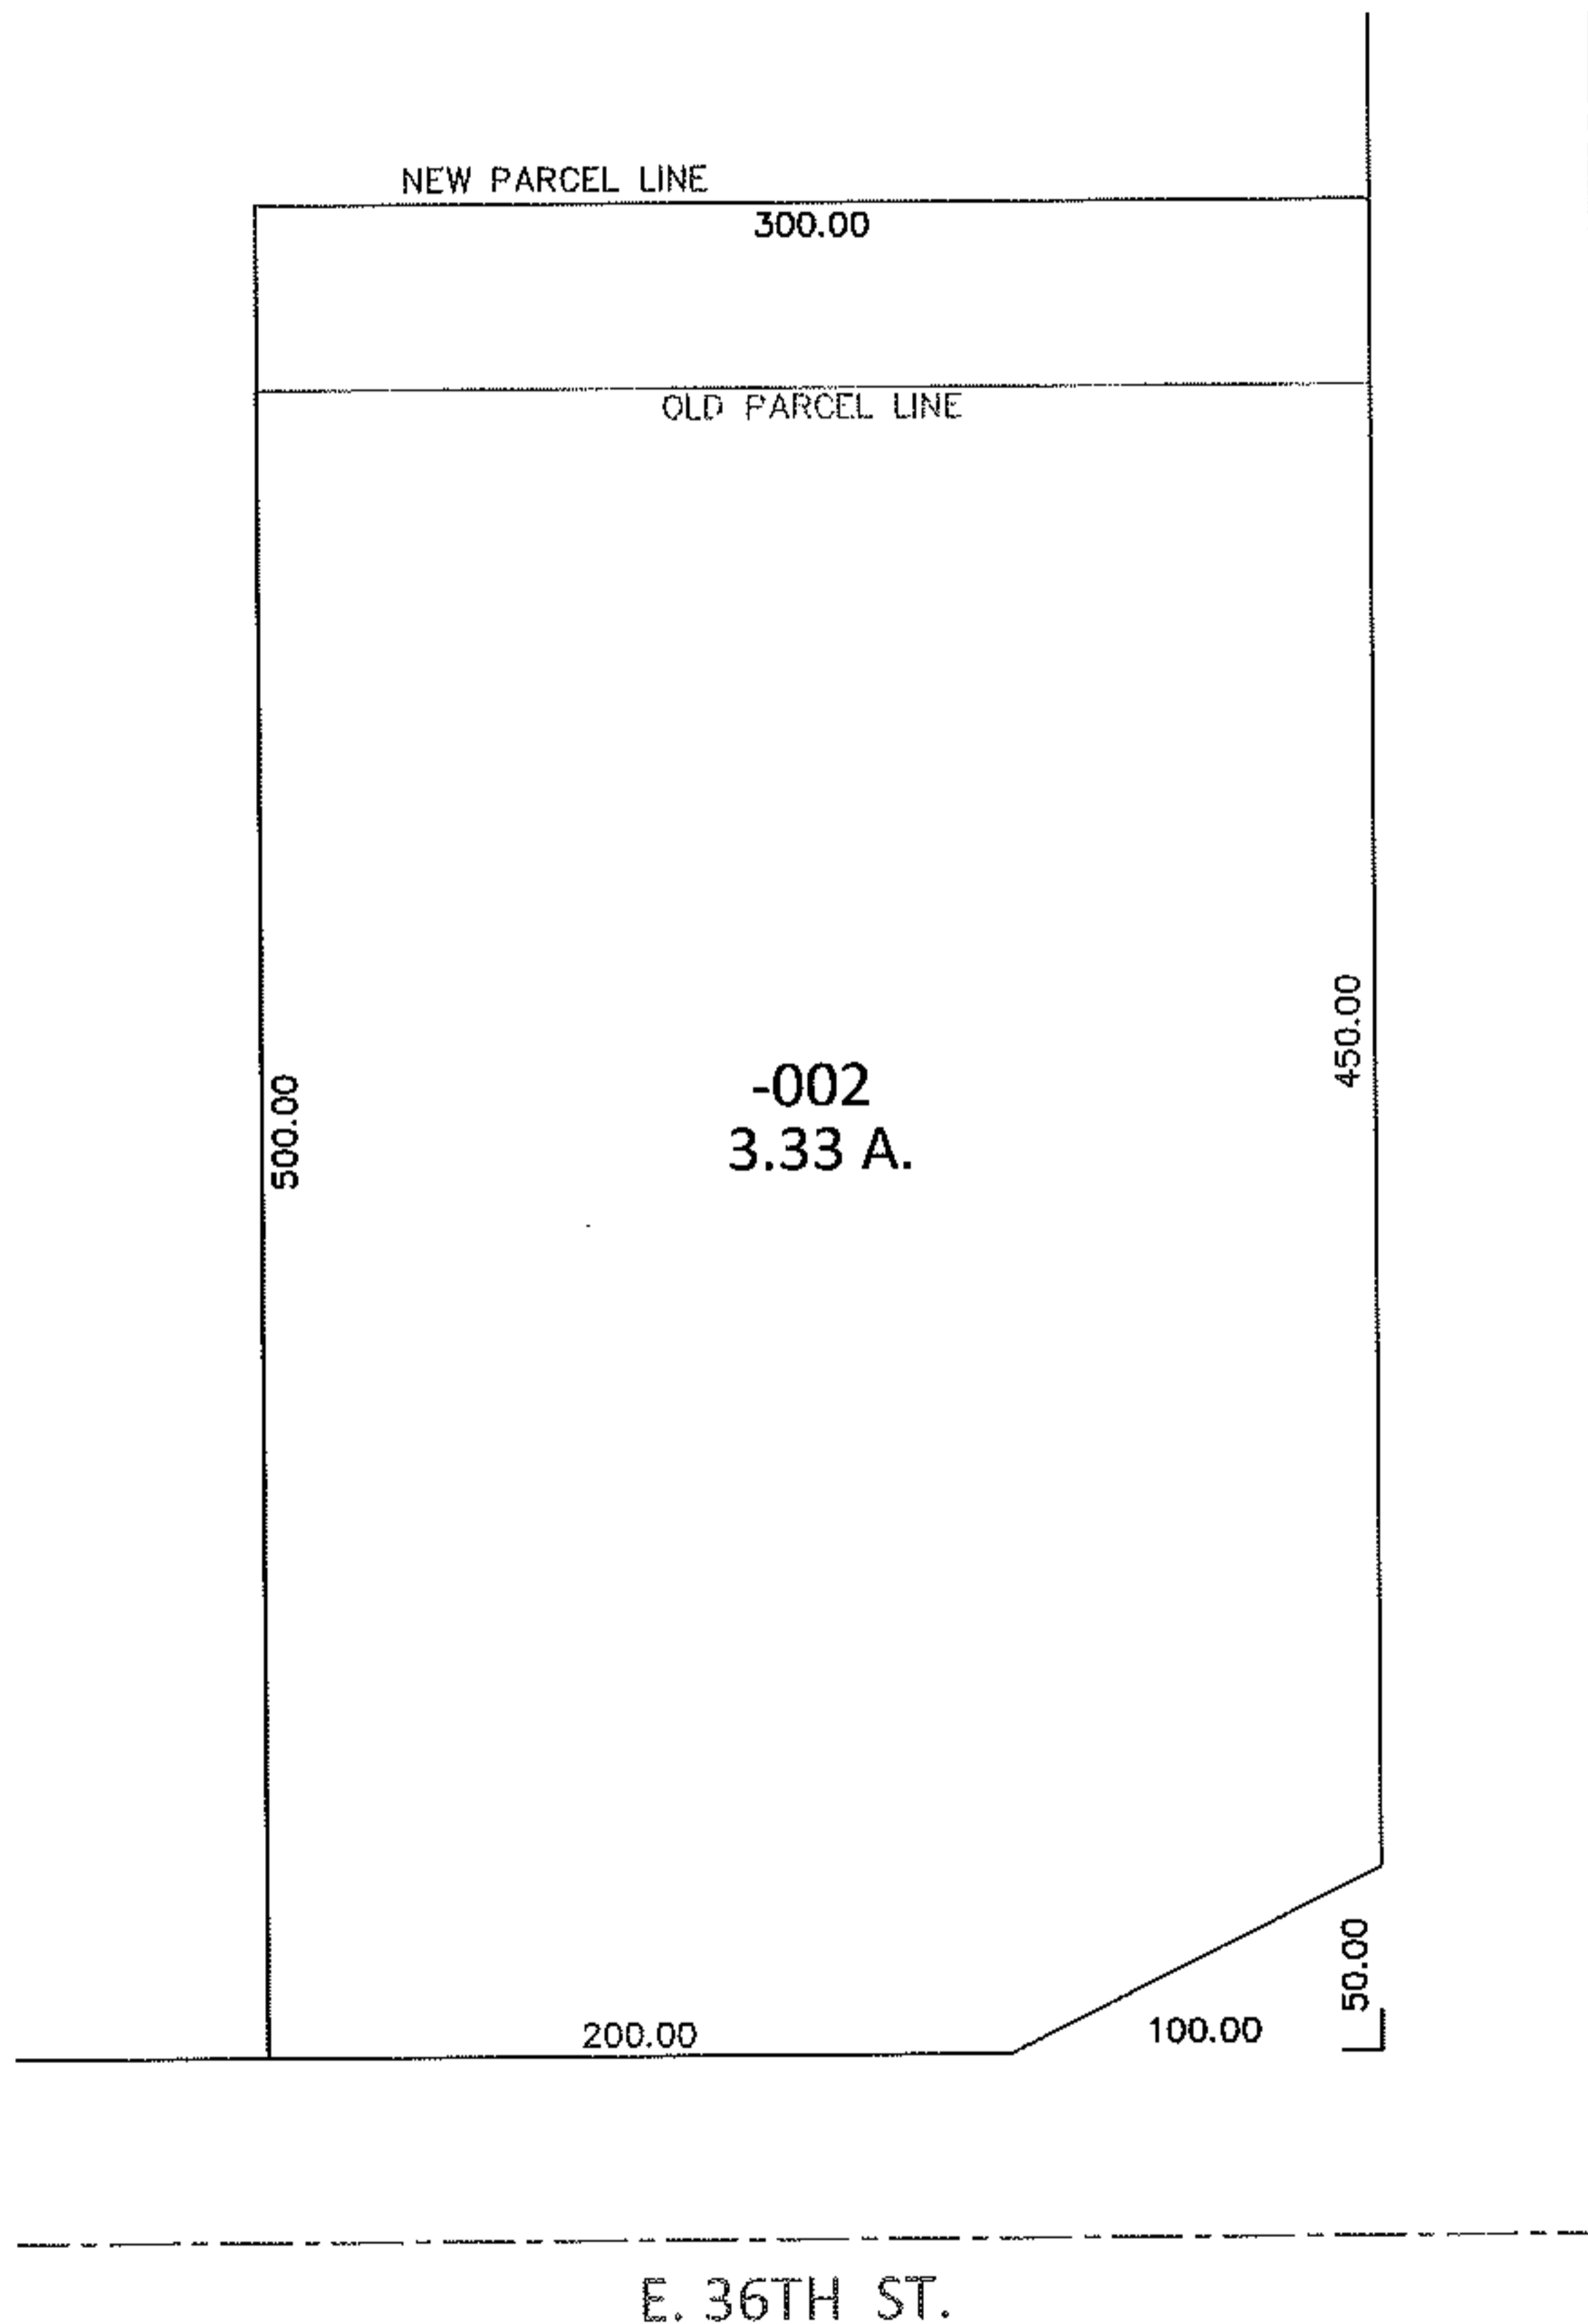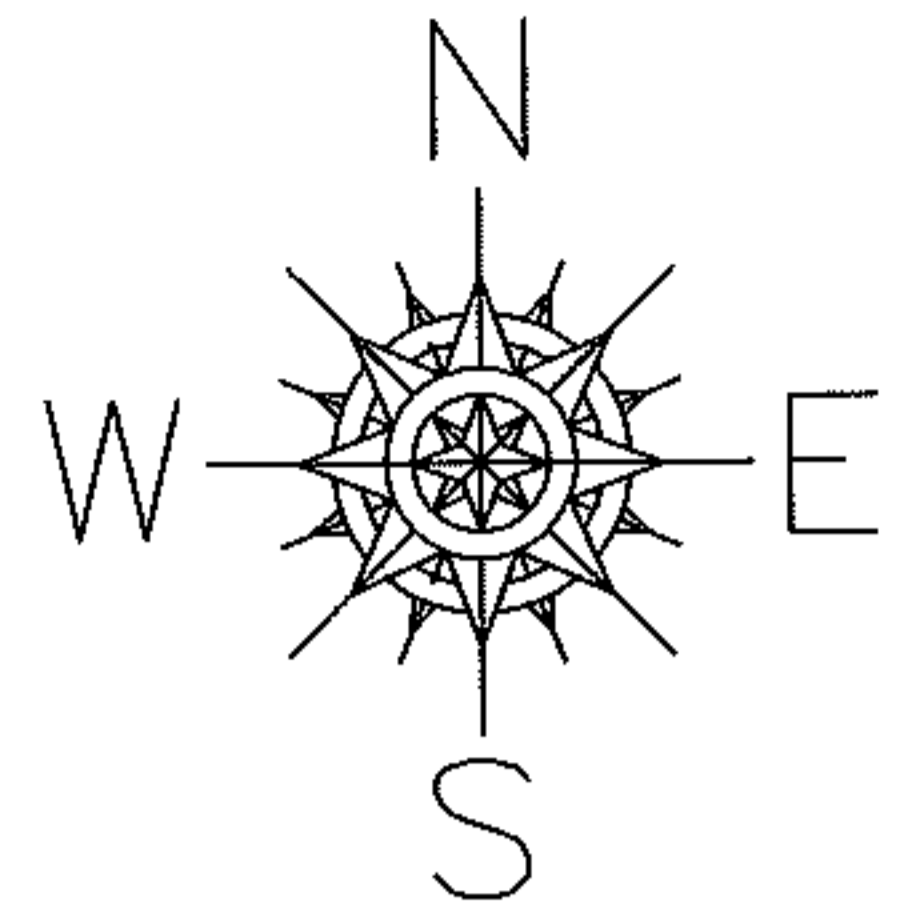

GROVE AVE.

E. 36TH ST.

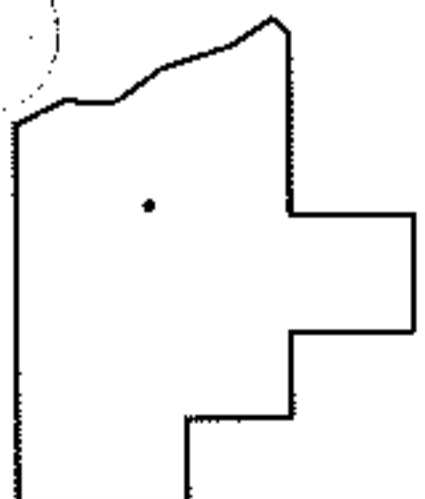

SPLITS/DEEDS PROCESSED

LORAIN COUNTY TAX MAP DEPARTMENT
226 MIDDLE AVE. ELYRIA, OHIO

SURVEYED BY: N/A

CLOSURE: N/A

MAP PAGE(S): 3-00-094-A

APPROVED BY: RRM DATE: 11-8-12

SCALE: 1"= 100 PRIOR INST.: DV 540/387