
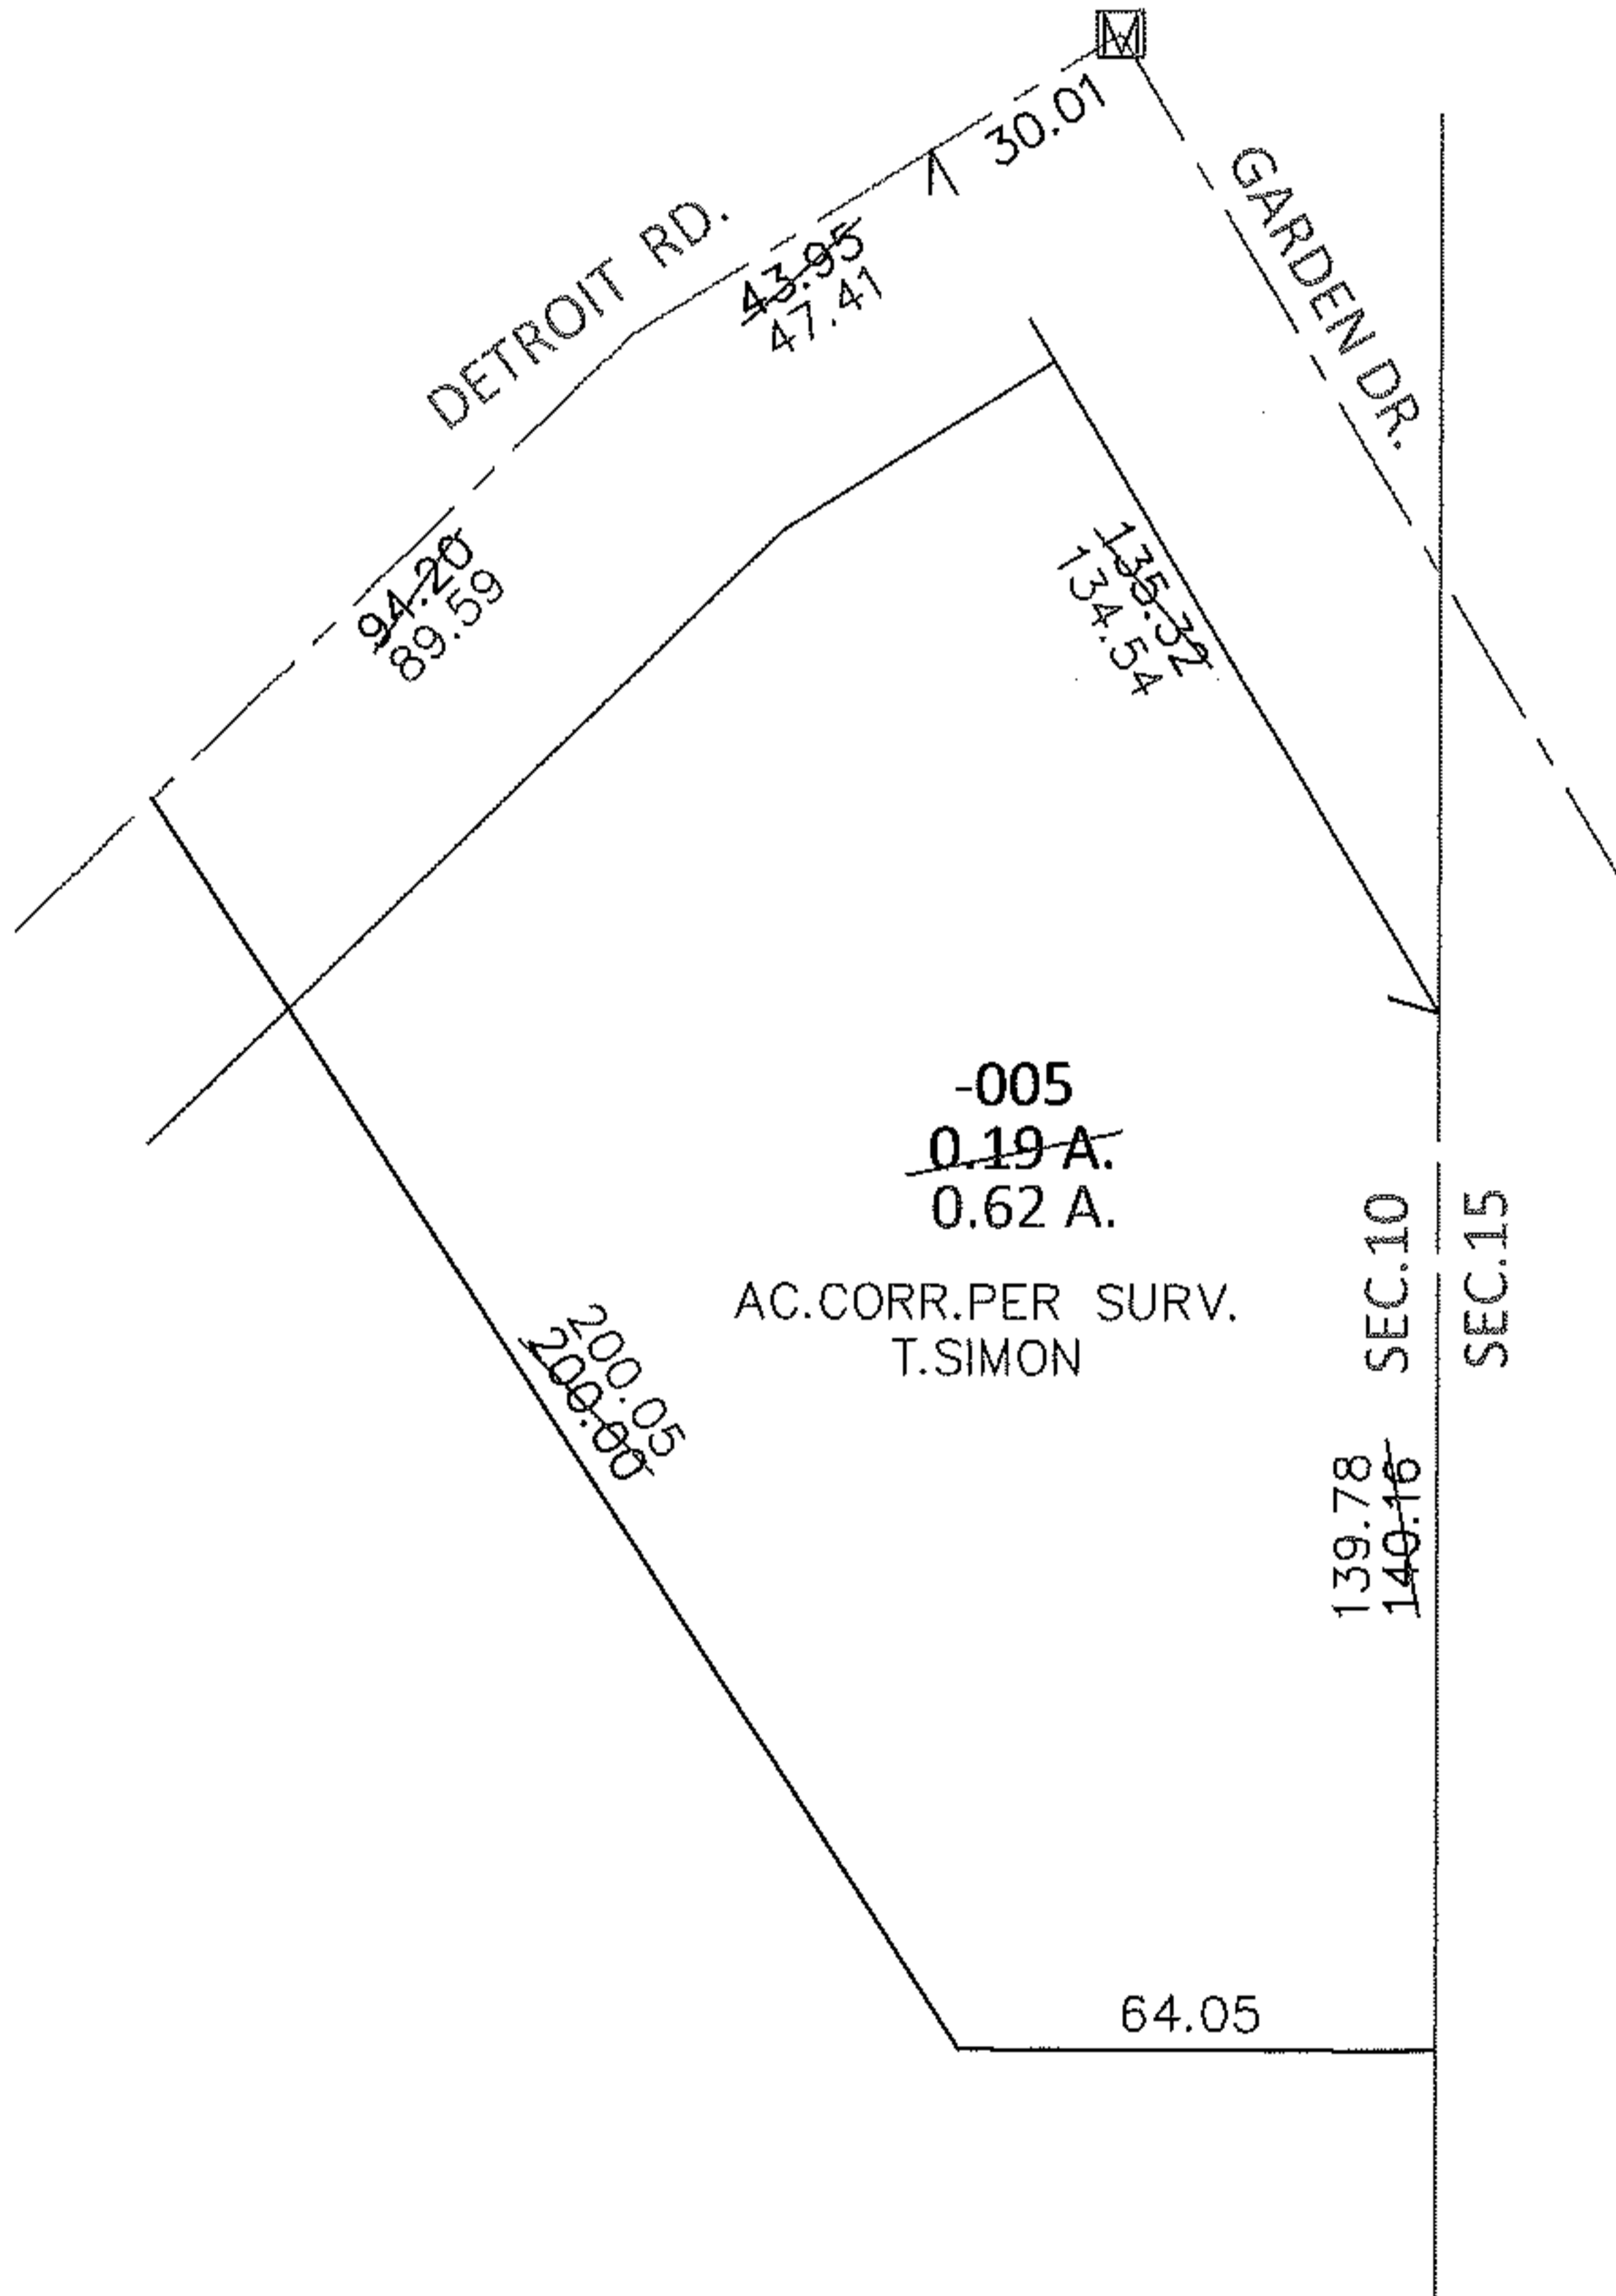


PARENT PARCEL: 04-00-010-119-005

CHILD PARCEL: _____

12-02612-A


STARTING POINT: AT A MON BOX AT THE INTERSECTION OF C/L OF DETROIT RD. AND C/ OF GARDEN DR.

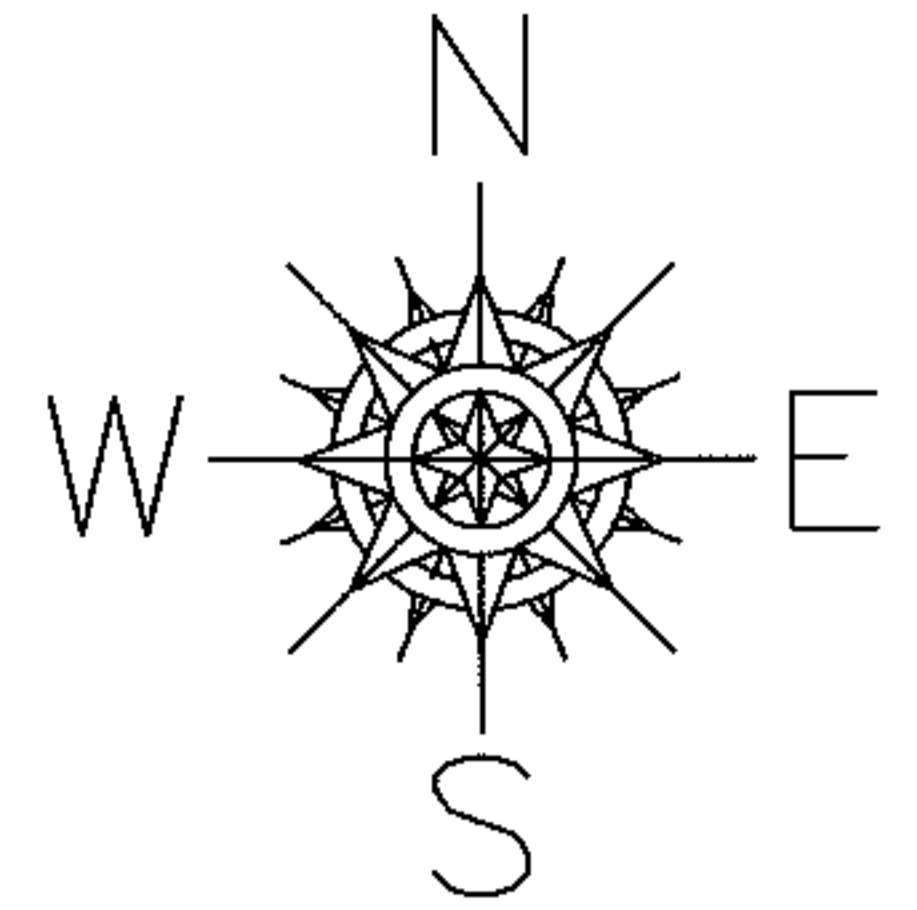

-005
~~0.19 A.~~
0.62 A.

AC.CORR.PER SURV.
T.SIMON

139.78
~~140.16~~
SEC.10
SEC.15

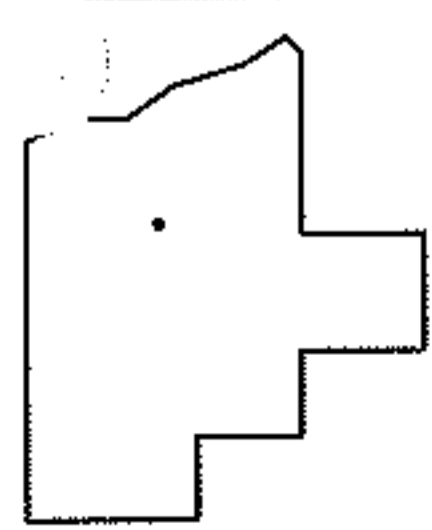

SPLITS/DEEDS PROCESSED

LORAIN COUNTY TAX MAP DEPARTMENT
226 MIDDLE AVE. ELYRIA, OHIO

SURVEYED BY: THOMAS A. SIMON
 CLOSURE: .01:10,000
 MAP PAGE(S): 4-00-010-H
 APPROVED BY: RRM DATE: 11-14-12
 SCALE: 1"= 50' PRIOR INST.: N/A