



RASTER

PARENT PARCEL: 08-00-098-000-010, -026

CHILD PARCEL: 08-00-098-000-039 THRU -045

STARTING POINT: CENTERLINE OF ELYRIA-MILAN RD & O.L. 98

08-02618

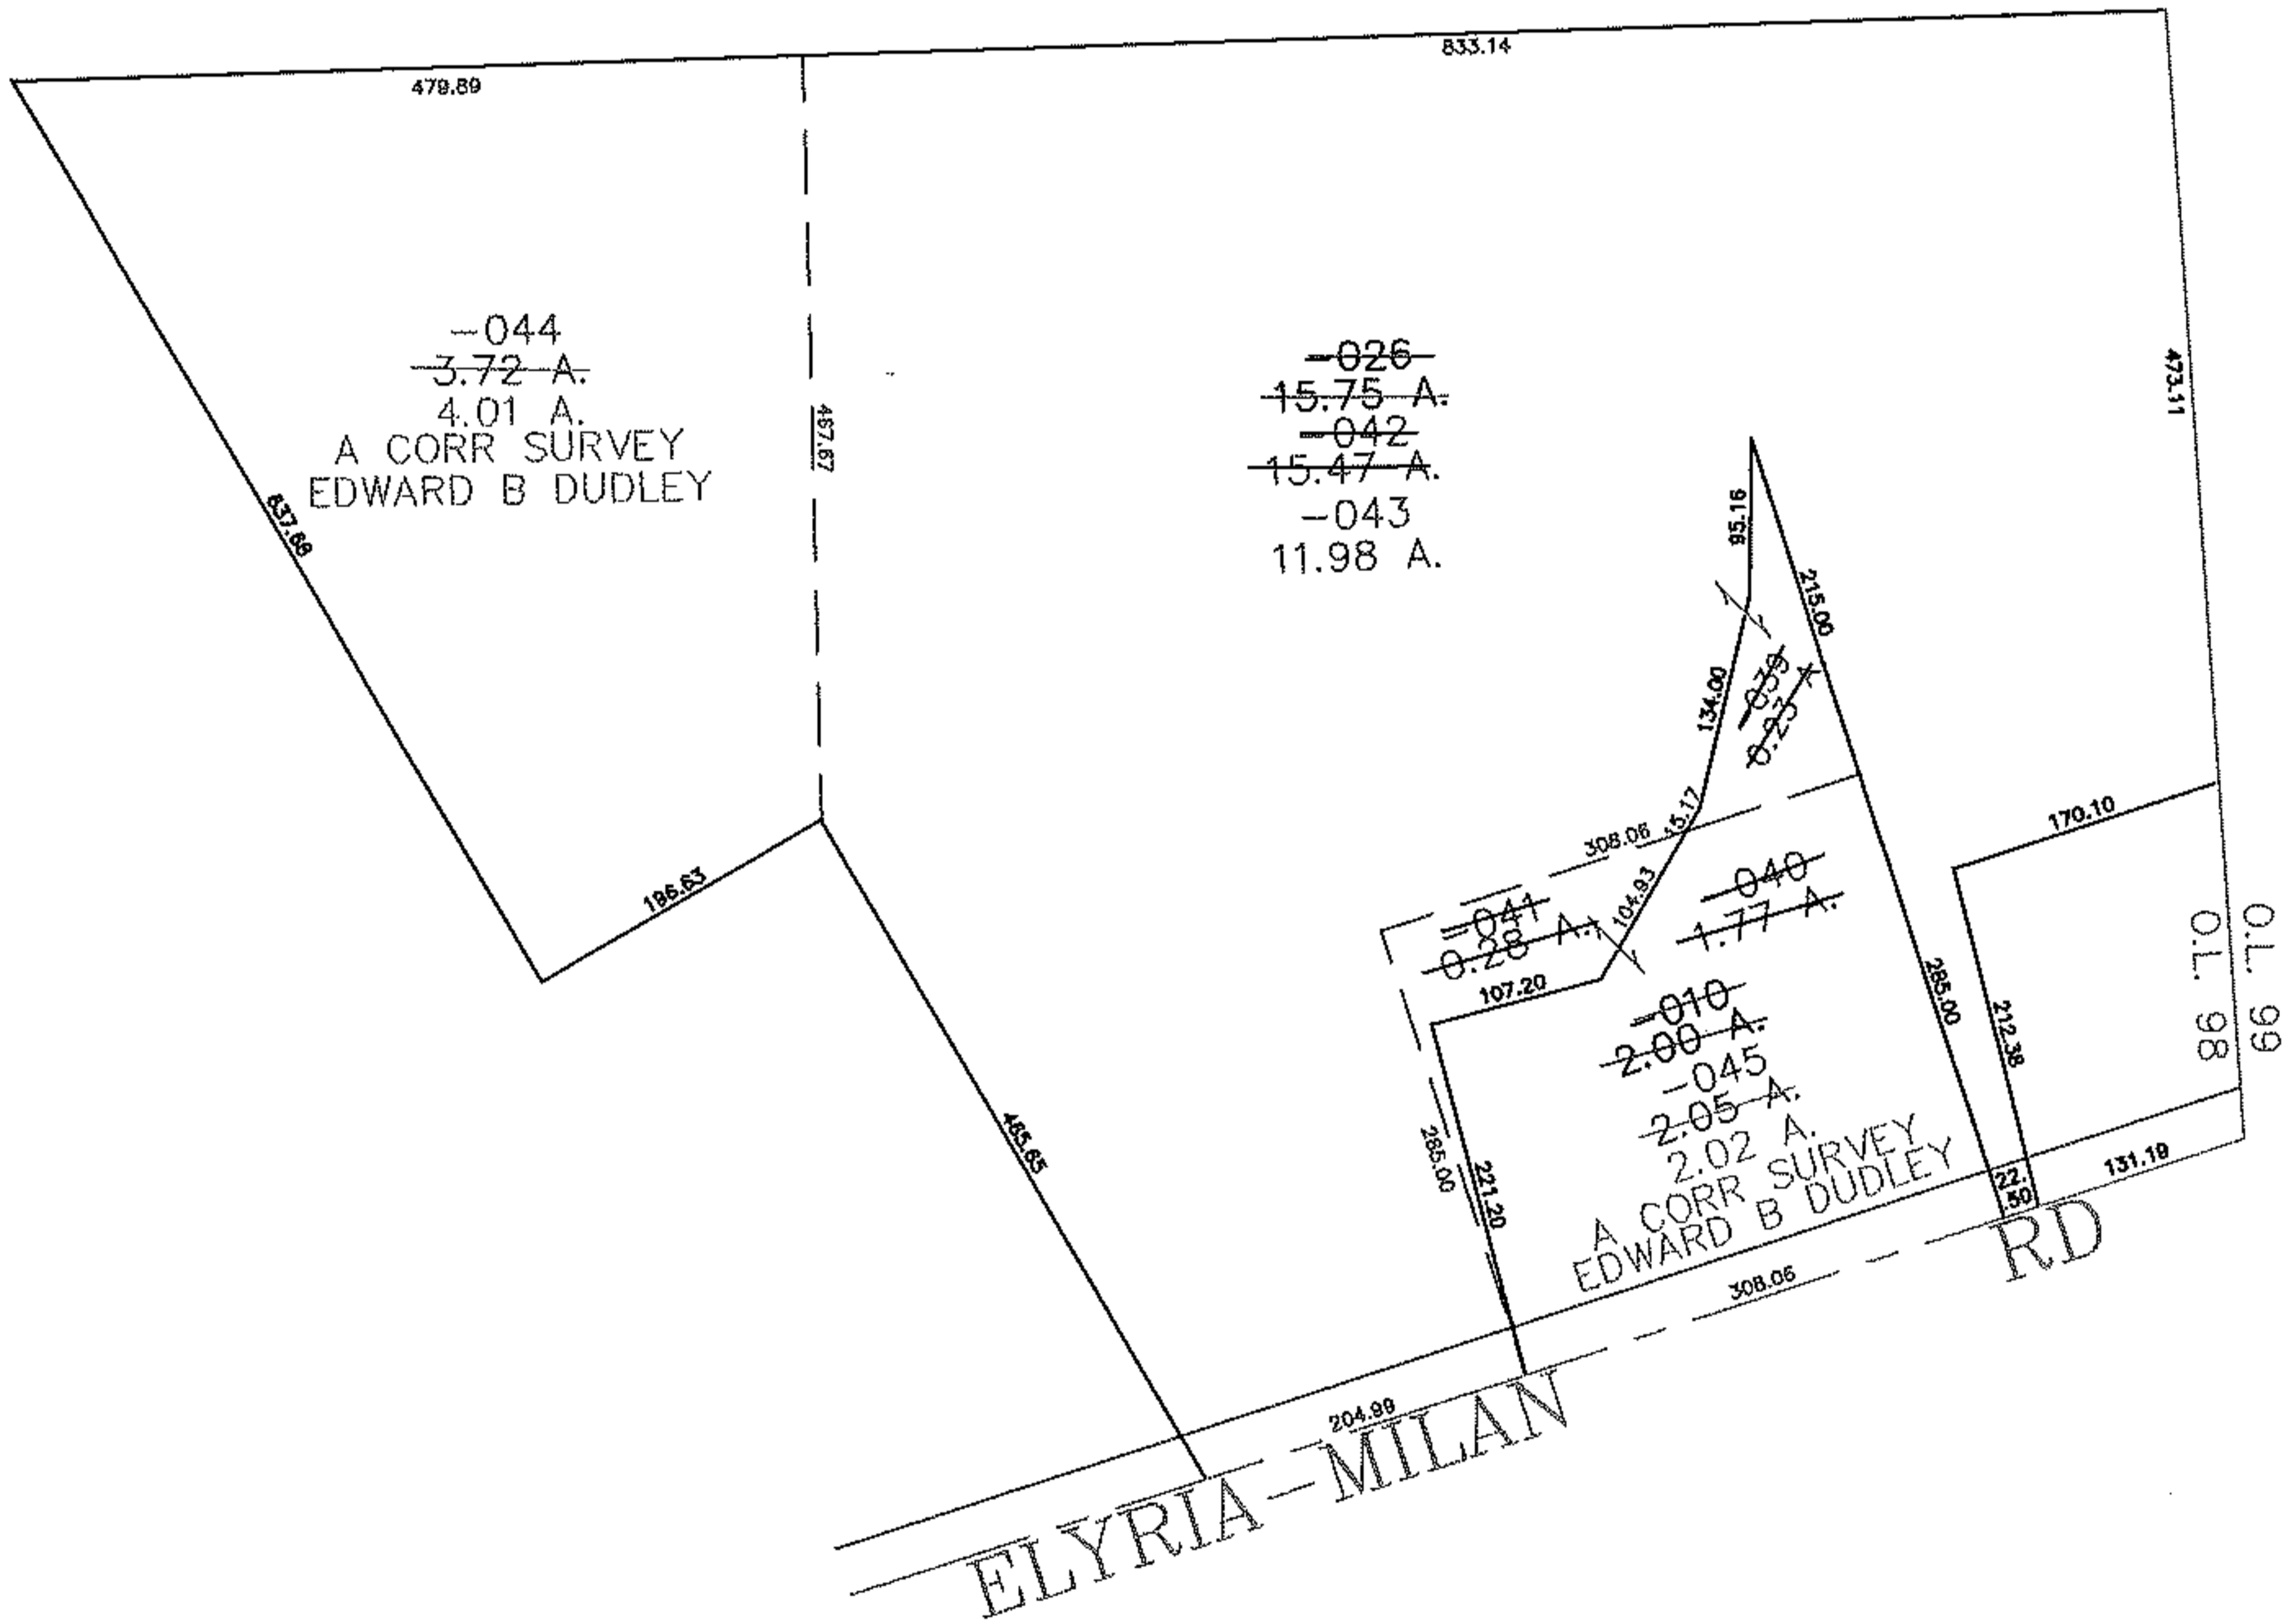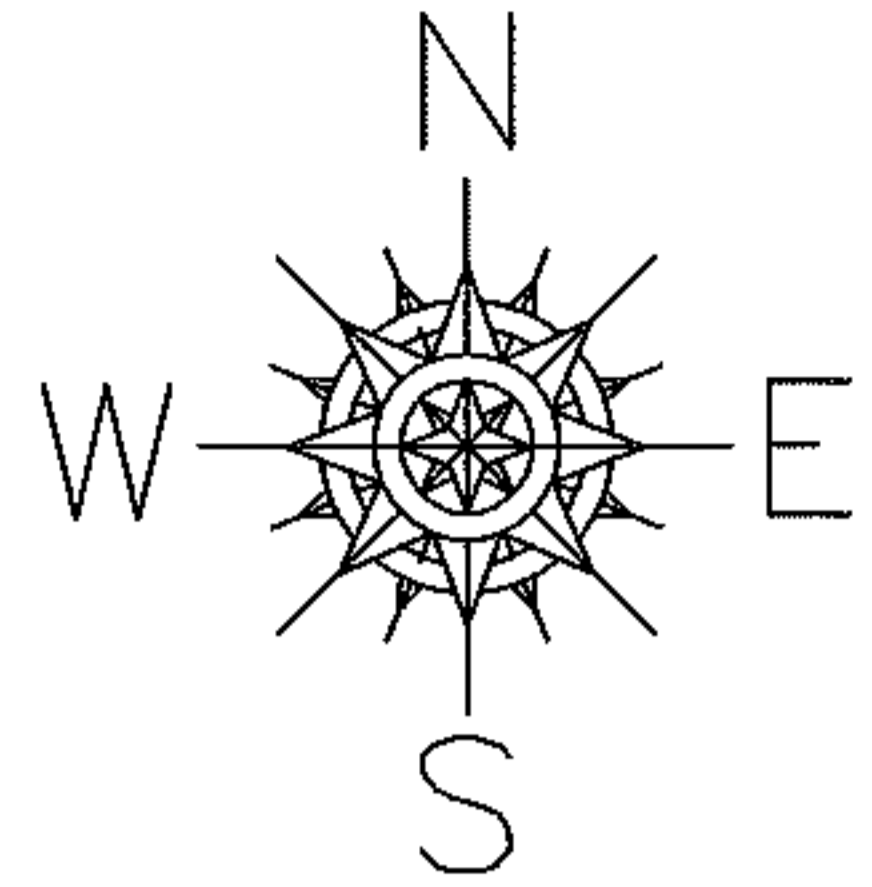

SPLITS/DEEDS PROCESSED

LORAIN COUNTY TAX MAP DEPARTMENT  
226 MIDDLE AVE. ELYRIA, OHIO

SURVEYED BY: EDWARD B DUDLEY

CLOSURE: 0.00 : 10.000

MAP PAGE(S): 8-A

APPROVED BY: JAH DATE: 10-2-08

SCALE: 1" = 200 PRIOR INSTRUMENT: 20060120942