
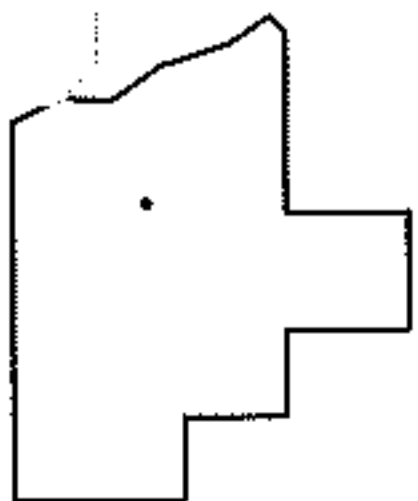
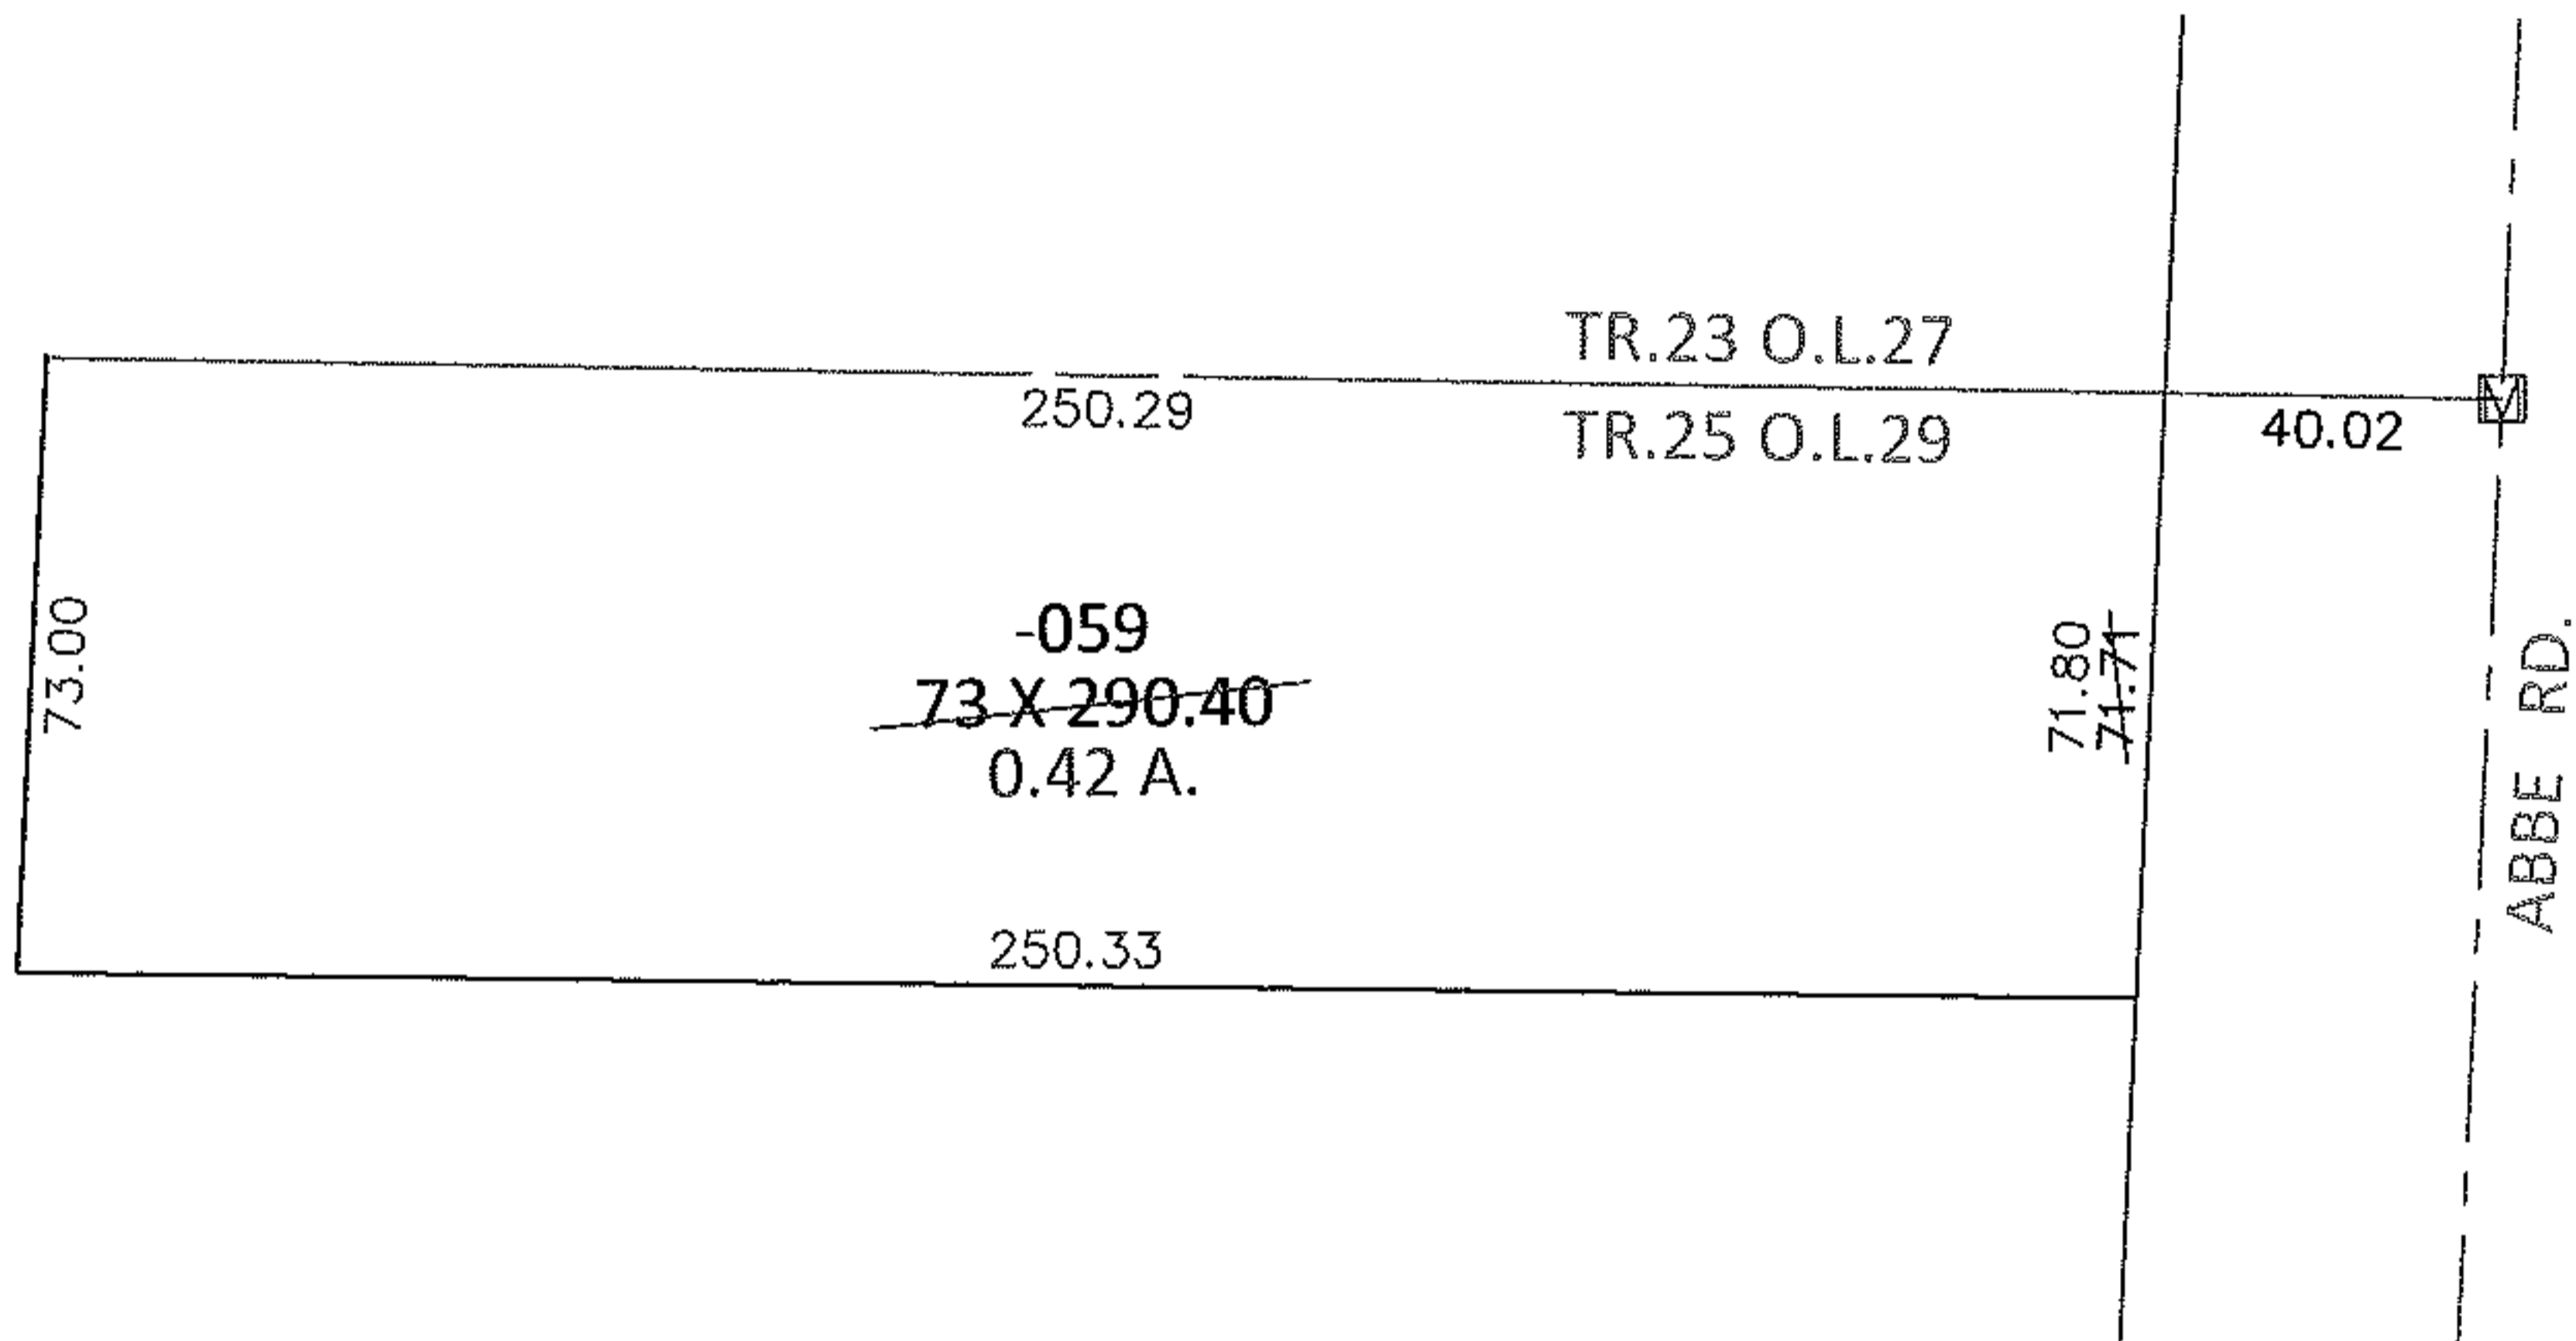


PARENT PARCEL: 06-25-029-104-059

CHILD PARCEL: \_\_\_\_\_

STARTING POINT: AT A MON BOX AT THE INTERSECTION OF C/L OF ABBE RD. AND NORTH LINE OF TR.25 O.L.29

12-02619-C

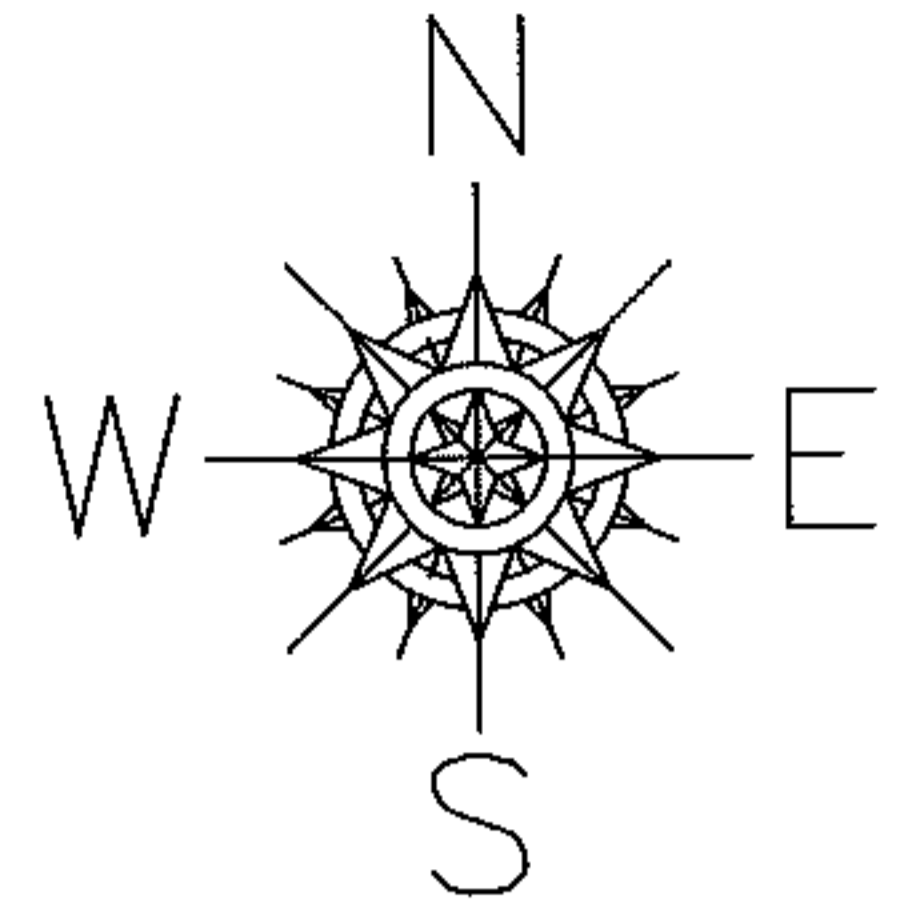

**SPLITS/DEEDS PROCESSED**

LORAIN COUNTY TAX MAP DEPARTMENT  
226 MIDDLE AVE. ELYRIA, OHIO

SURVEYED BY: THOMAS A. SIMON

CLOSURE: .01:10,000

MAP PAGE(S): 6-52

APPROVED BY: RRM DATE: 11-20-12

SCALE: 1"= 50' PRIOR INST.: 20030939745