



RASTER

PARENT PARCEL: 04-00-022-103-033, -006

CHILD PARCEL: 04-00-022-103-055, -056

STARTING POINT: CENTERLINE OF DETROIT RD & JAYCOX RD

08-02621

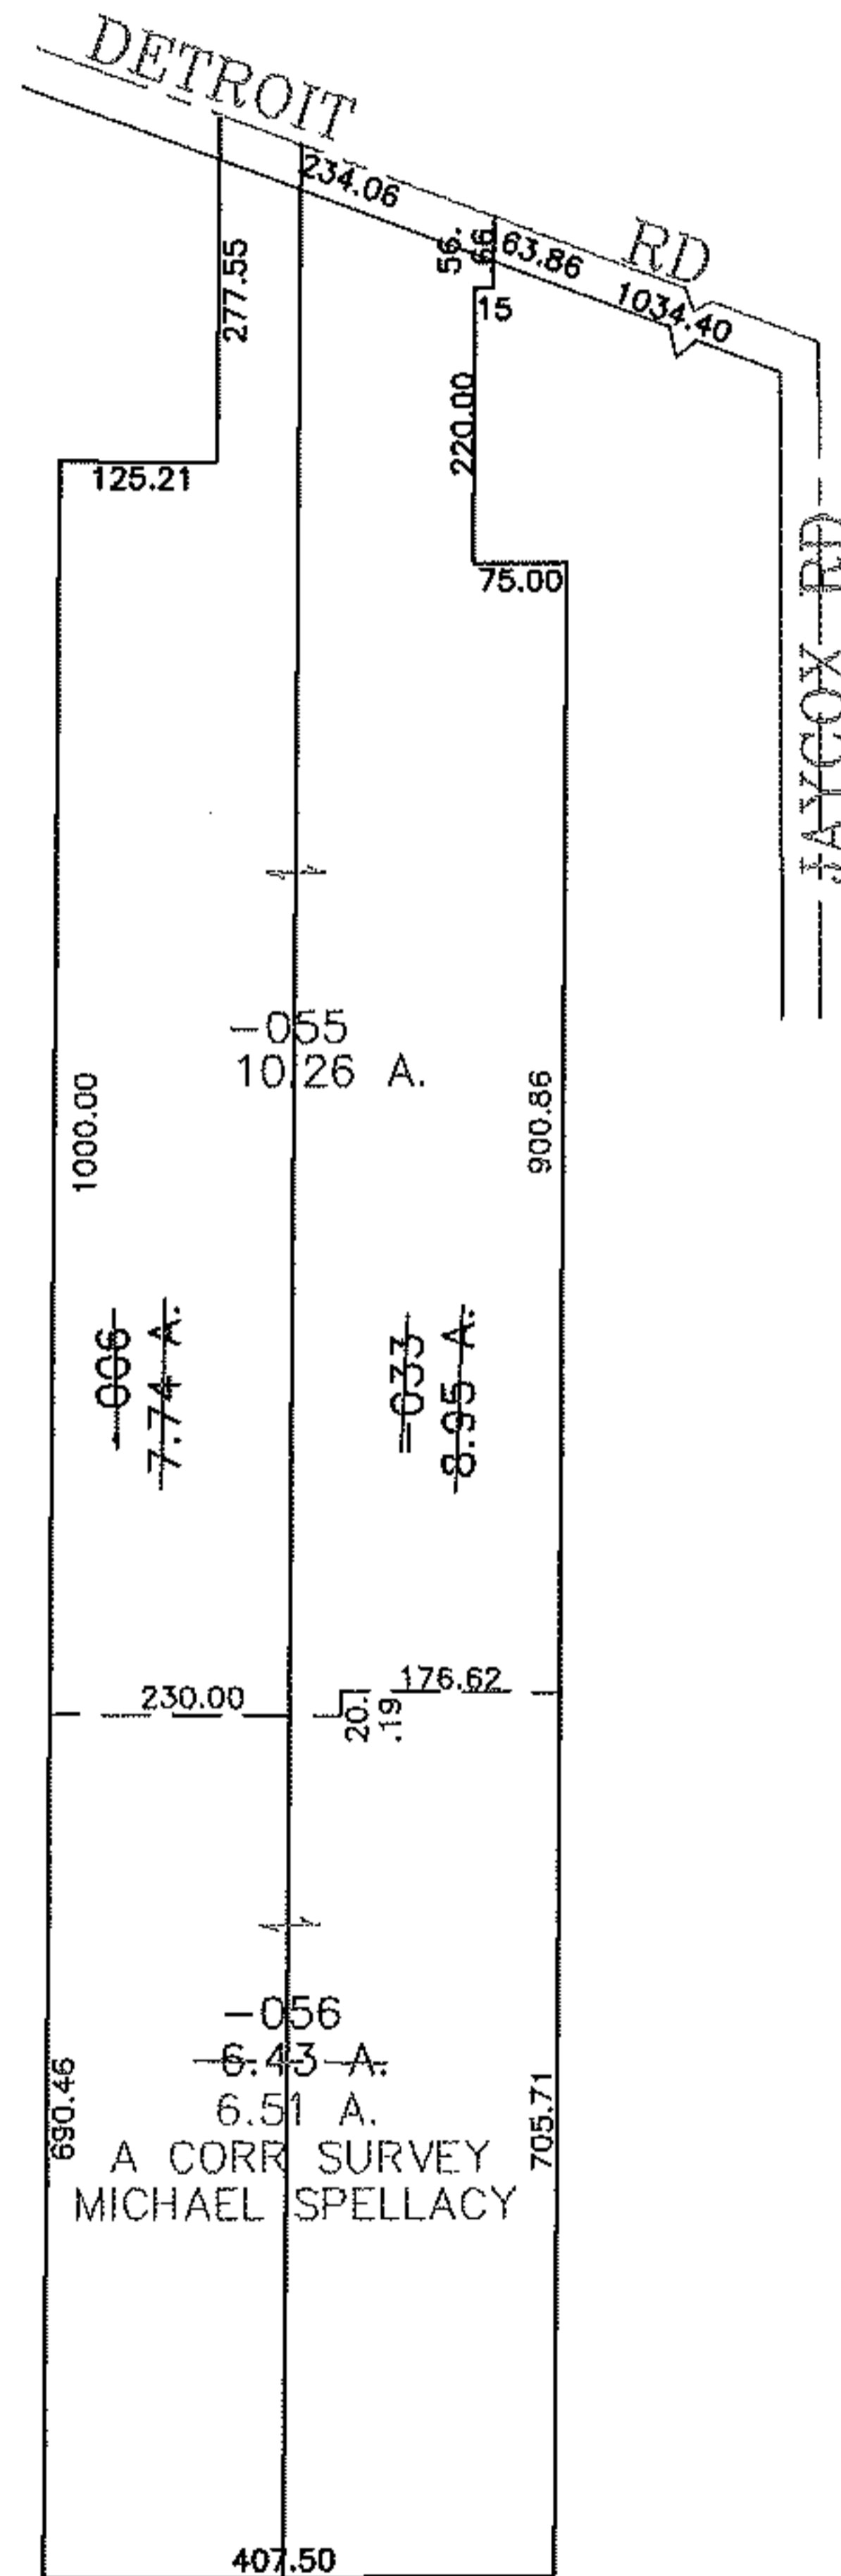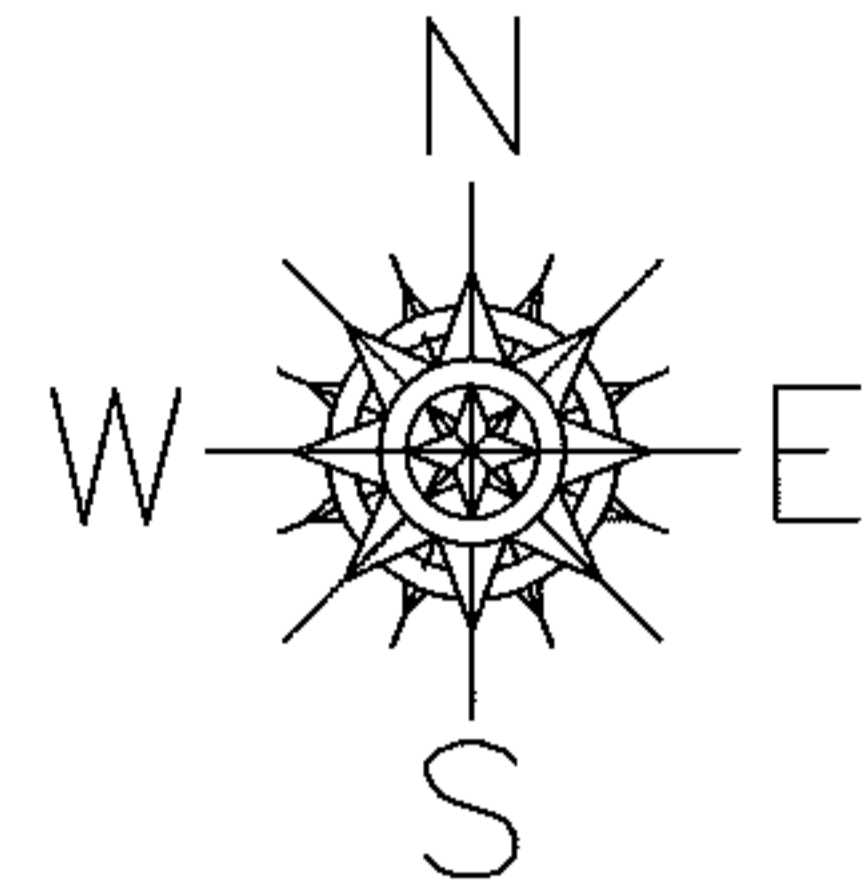

SPLITS/DEEDS PROCESSED

LORAIN COUNTY TAX MAP DEPARTMENT
226 MIDDLE AVE. ELYRIA, OHIO

SURVEYED BY: MICHAEL SPELLACY

CLOSURE: 0.00 : 10.000

MAP PAGE(S): 04-00-022-E

APPROVED BY: JAH DATE: 10-13-08

SCALE: 1" = 300 PRIOR INSTRUMENT: 20040048344