




RASTER

PARENT PARCEL: 04-00-029-000-409

CHILD PARCEL: 04-00-029-000-921 THRU -923

STARTING POINT: CENTERLINE OF LEAR NAGEL RD & KREBS RD

08-02622

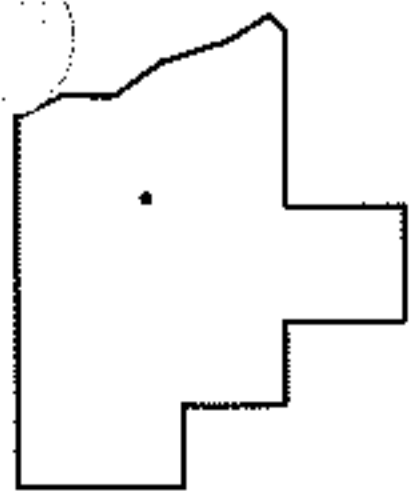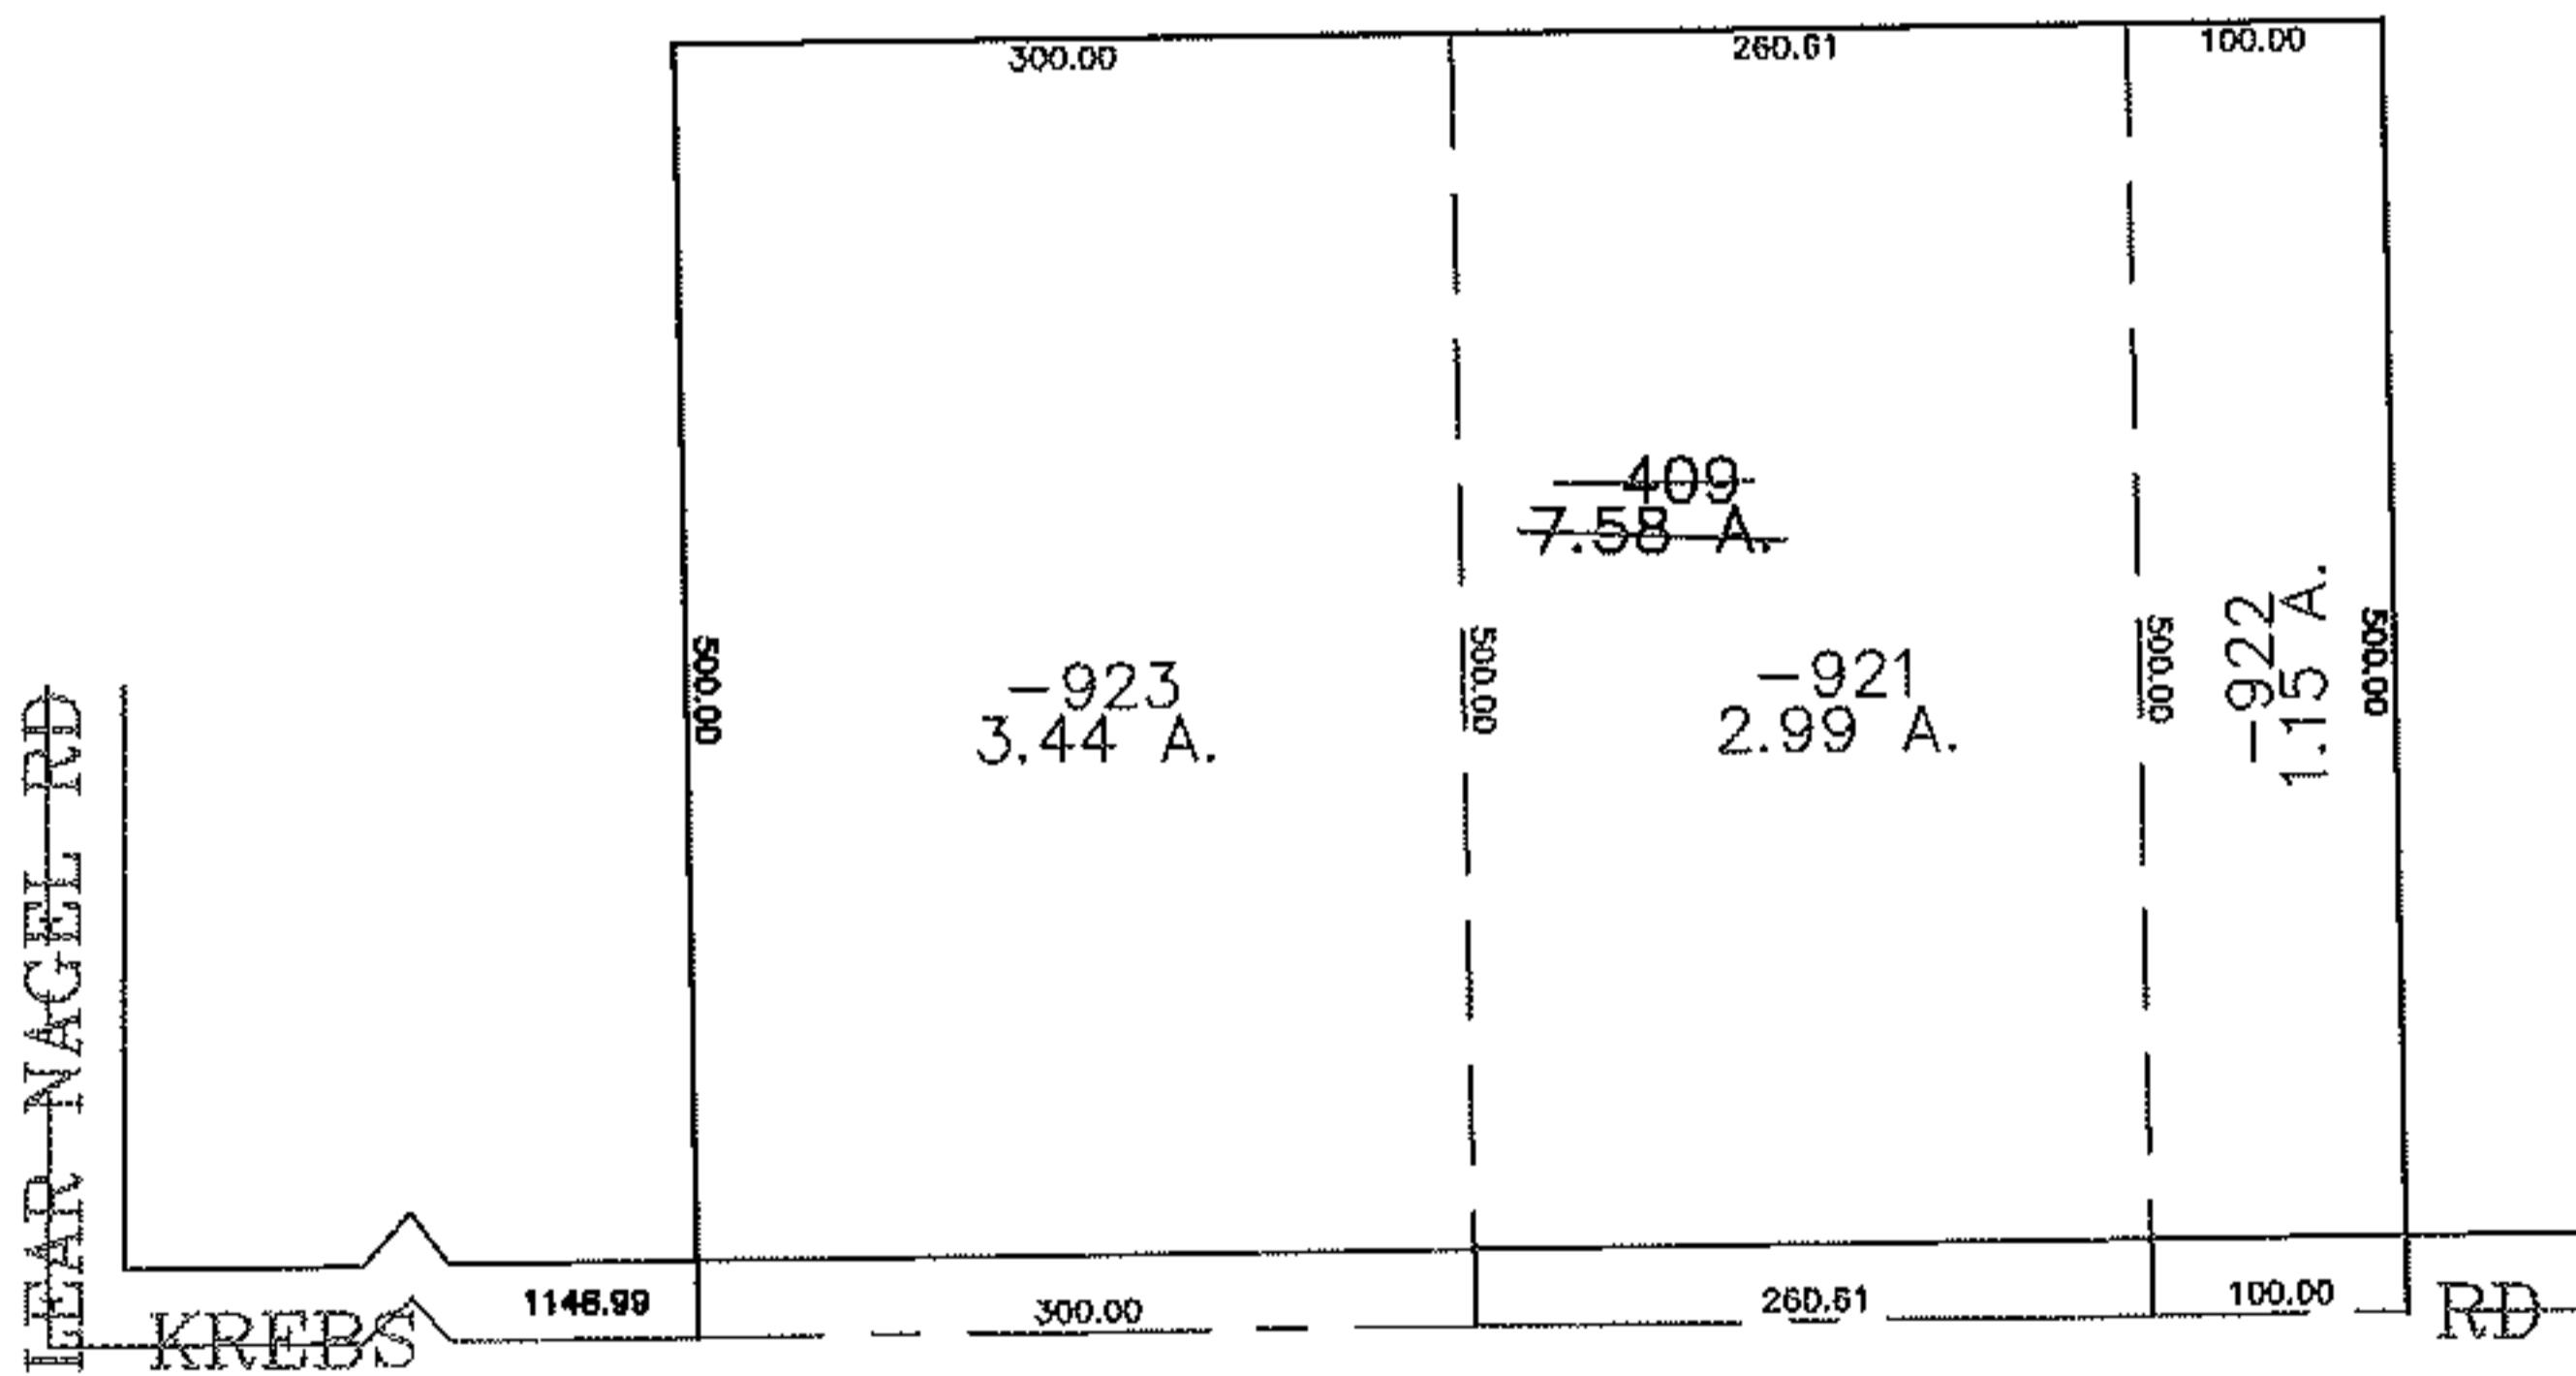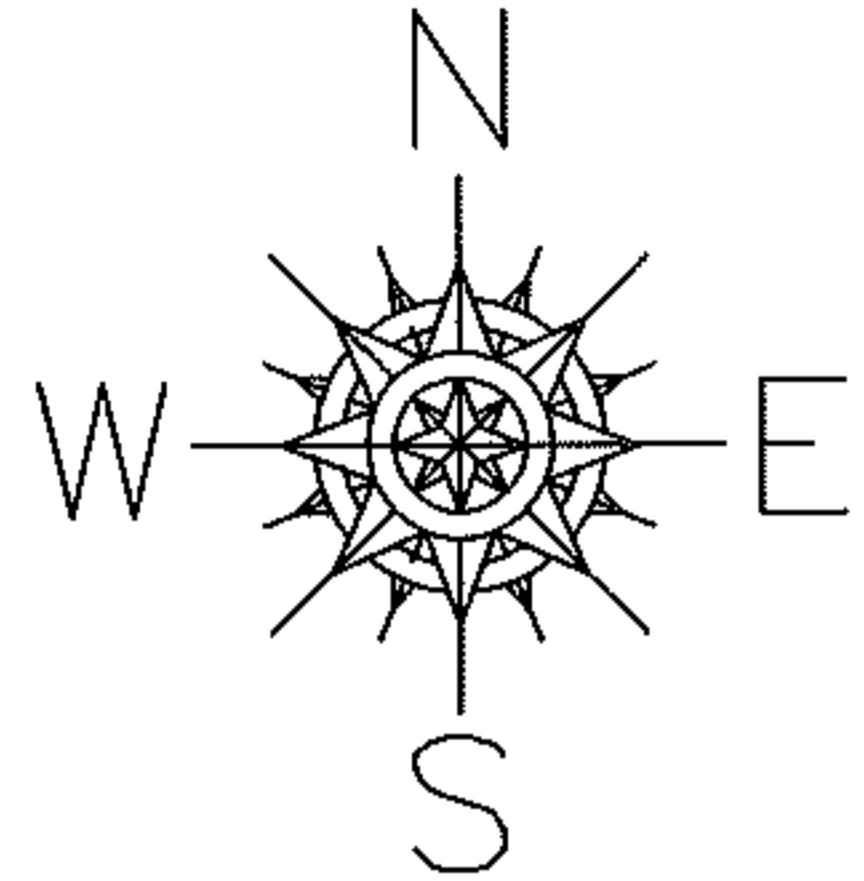

SPLITS/DEEDS PROCESSED
 LORAIN COUNTY TAX MAP DEPARTMENT
 226 MIDDLE AVE. ELYRIA, OHIO

SURVEYED BY: CHRISTOPHER HIRZEL
 CLOSURE: 0.00 : 10.000
 MAP PAGE(S): 04-00-029-F
 APPROVED BY: JAH DATE: 10-15-08
 SCALE: 1" = 200 PRIOR INSTRUMENT: 20020871078