




RASTER

PARENT PARCEL: 04-00-002-101-243 THRU -245

CHILD PARCEL: 04-00-002-101-259 THRU -264

STARTING POINT: SIDELINE OF MOON RD & WOODLAND TRAIL

08-02623

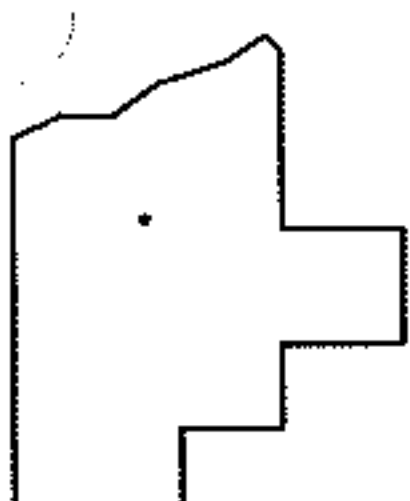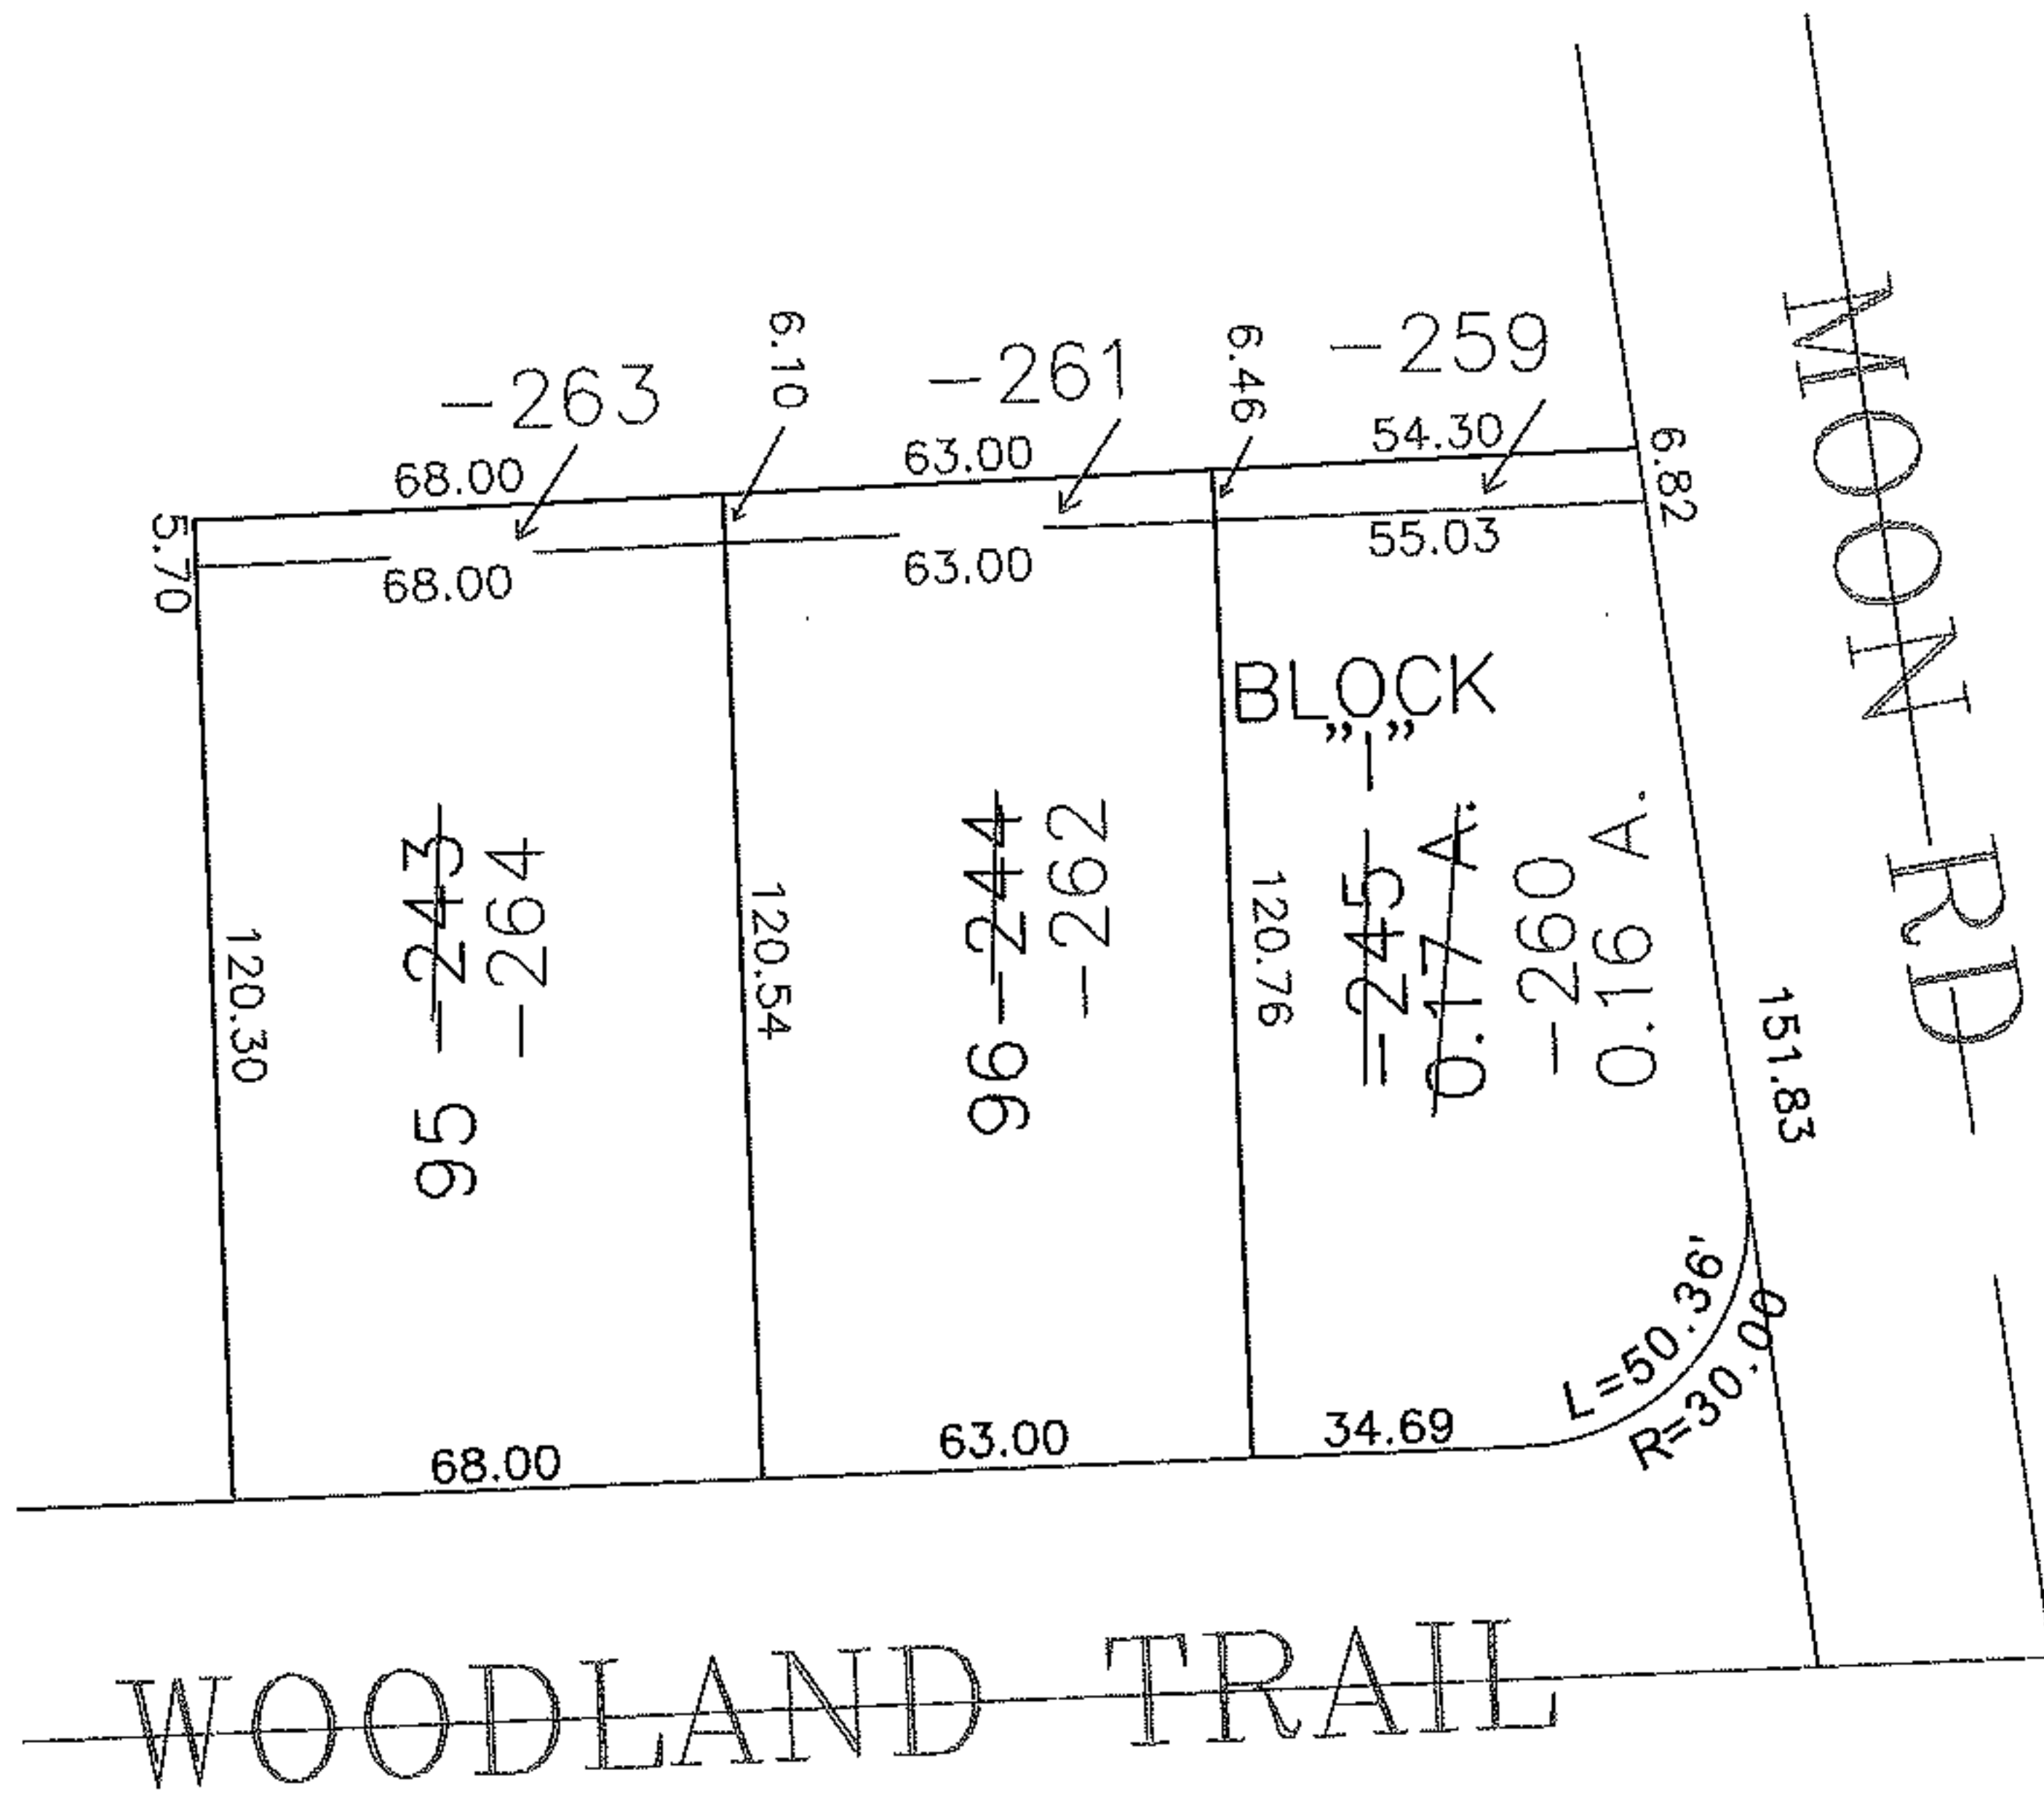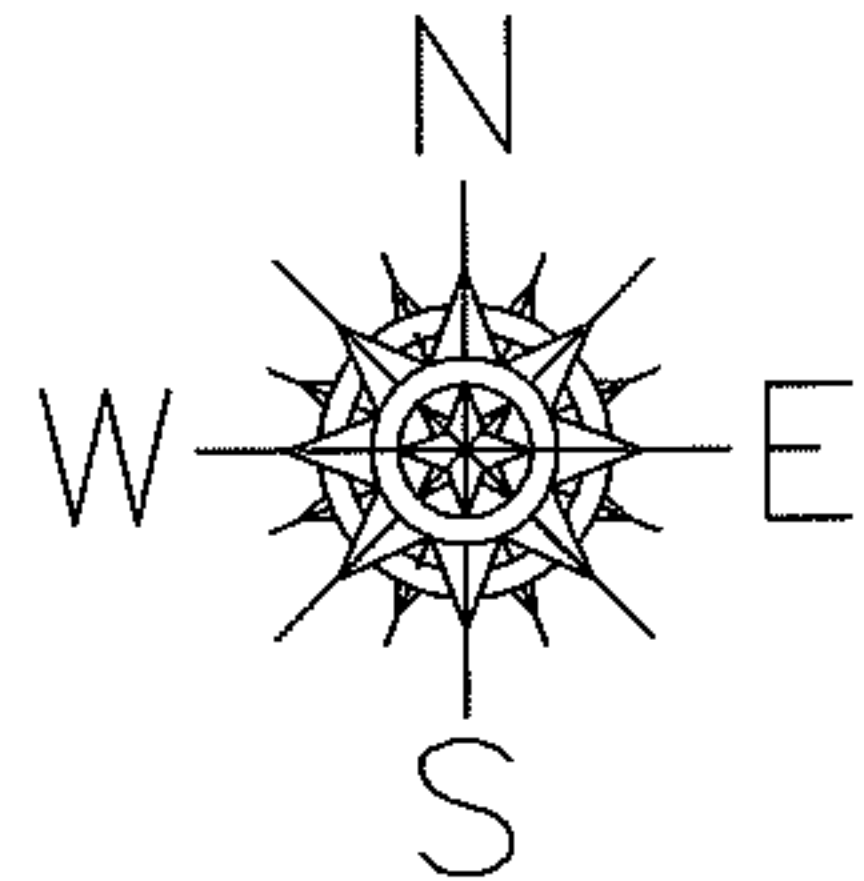

SPLITS/DEEDS PROCESSED

LORAIN COUNTY TAX MAP DEPARTMENT  
226 MIDDLE AVE. ELYRIA, OHIO

SURVEYED BY: JAMES T SAYLER

CLOSURE: 0.00 : 10,000

MAP PAGE(S): 04-00-002-B

APPROVED BY: JAH DATE: 10-20-08

SCALE: 1"= 100 PRIOR INSTRUMENT: 20050118886