
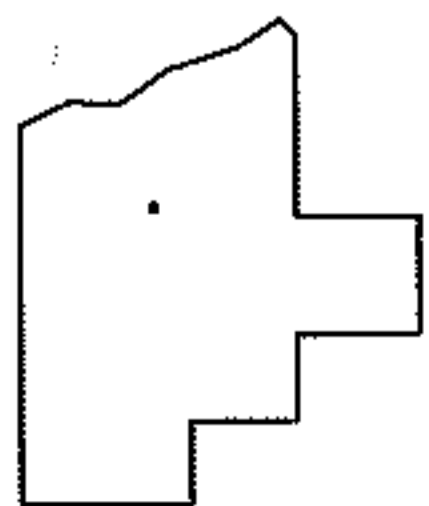
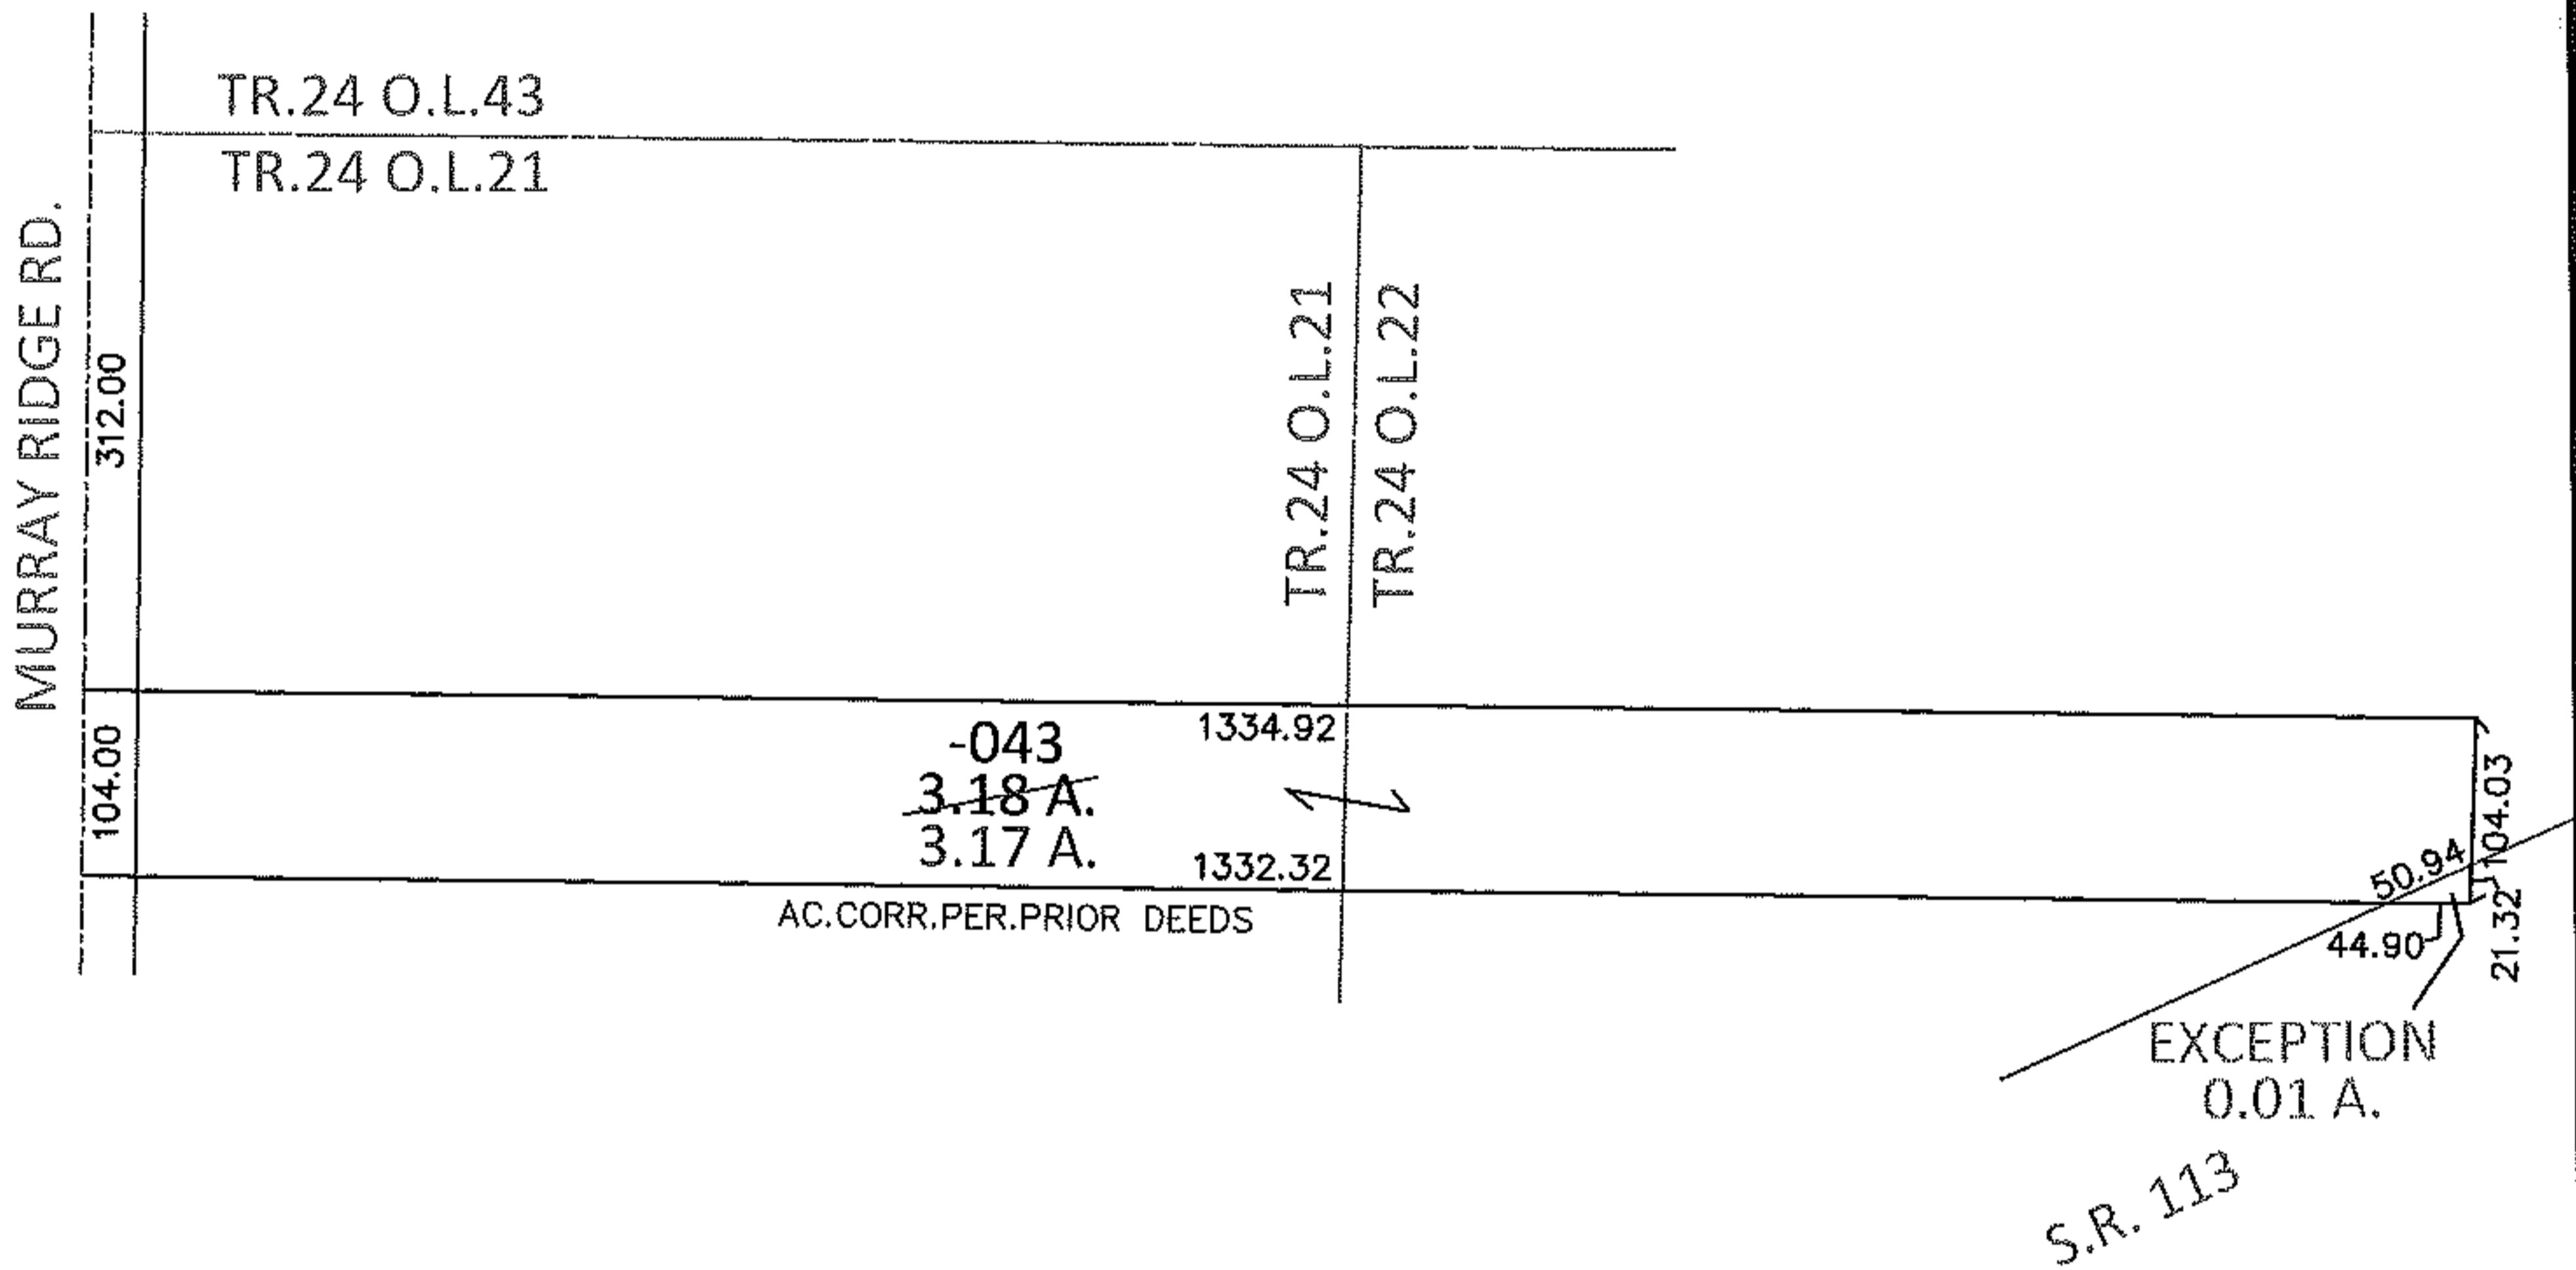


PARENT PARCEL: 06-24-021-000-043

12-02626-A

CHILD PARCEL: _____

STARTING POINT: INTERSECTION OF C/L OF MURRAY RIDGE RD. AND NORTH LINE OF TR.24 O.L.21

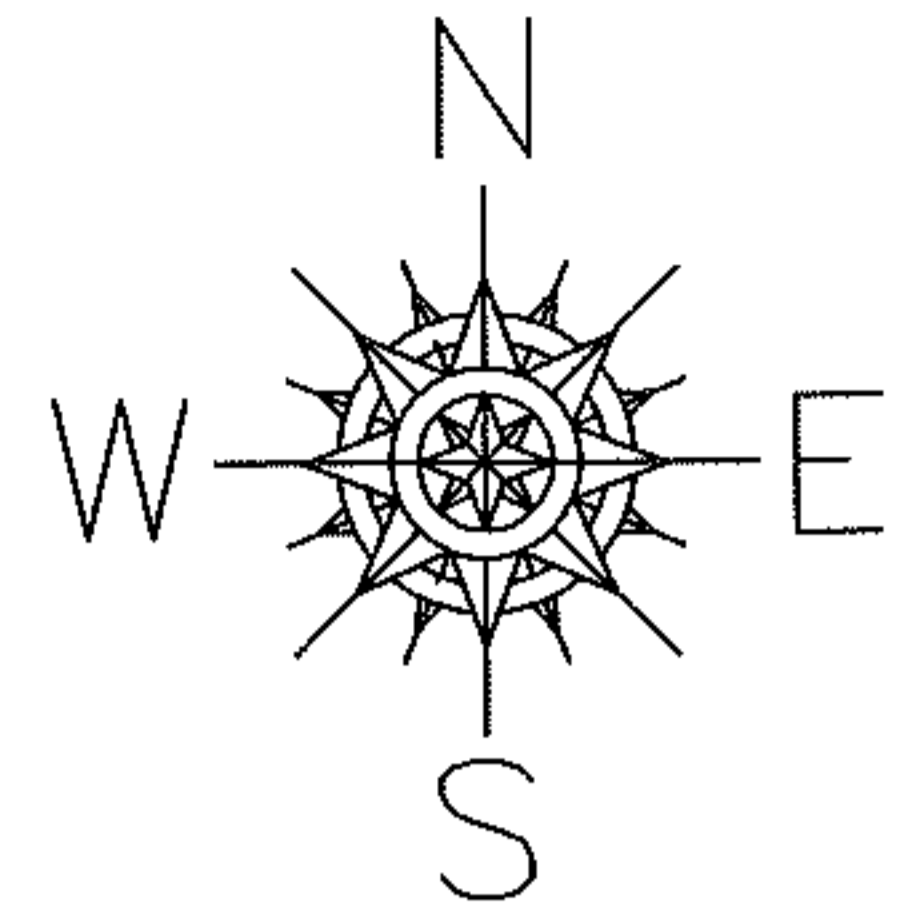

SPLITS/DEEDS PROCESSED

LORAIN COUNTY TAX MAP DEPARTMENT
226 MIDDLE AVE. ELYRIA, OHIO

SURVEYED BY: N/A

CLOSURE: .01:10,000

MAP PAGE(S): 6-75, 6-76

APPROVED BY: RRM DATE: 3-14-13

SCALE: 1"= 200 PRIOR INST.: OR 905/612