


RASTER

PARENT PARCEL: 09-00-086-102-058, -061, -062, -105, -108, -109

CHILD PARCEL: 09-00-086-102-110


STARTING POINT: DRILL HOLE, INTERSECTION OF THE WESTERLY R.O.W. OF S. PLEASANT ST. & SOUTHERLY R.O.W. OF EAST COLLEGE STREET.

NO. 08-02628

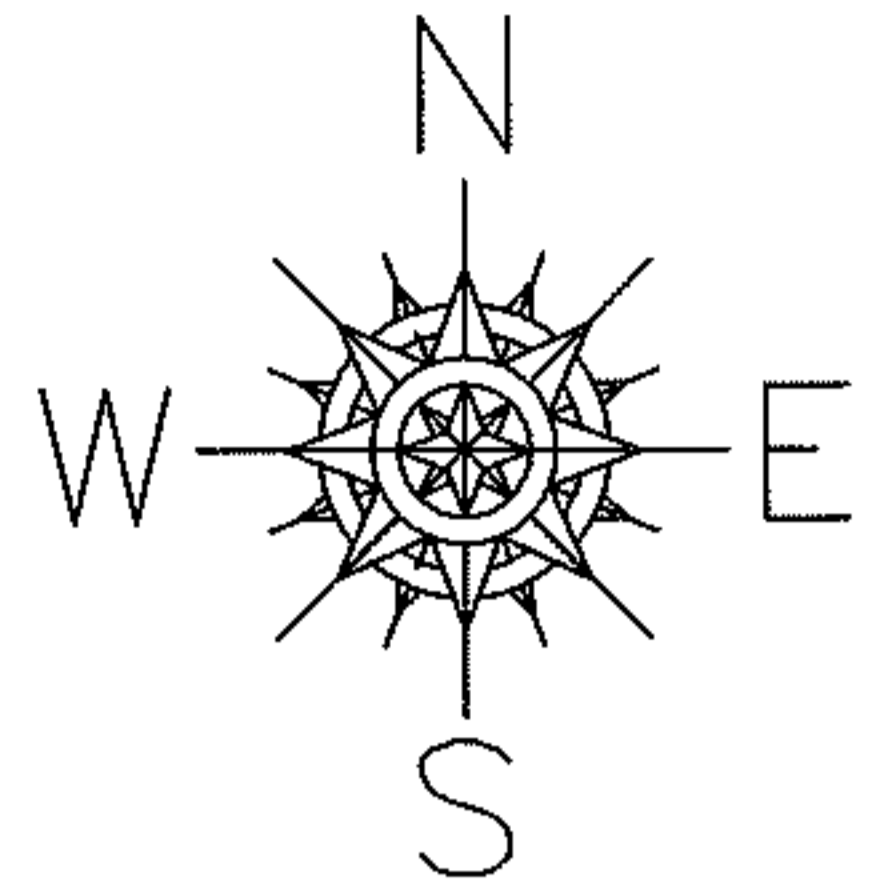

EAST COLLEGE ST. 60'

P.P.B. DRILL HOLE FD.

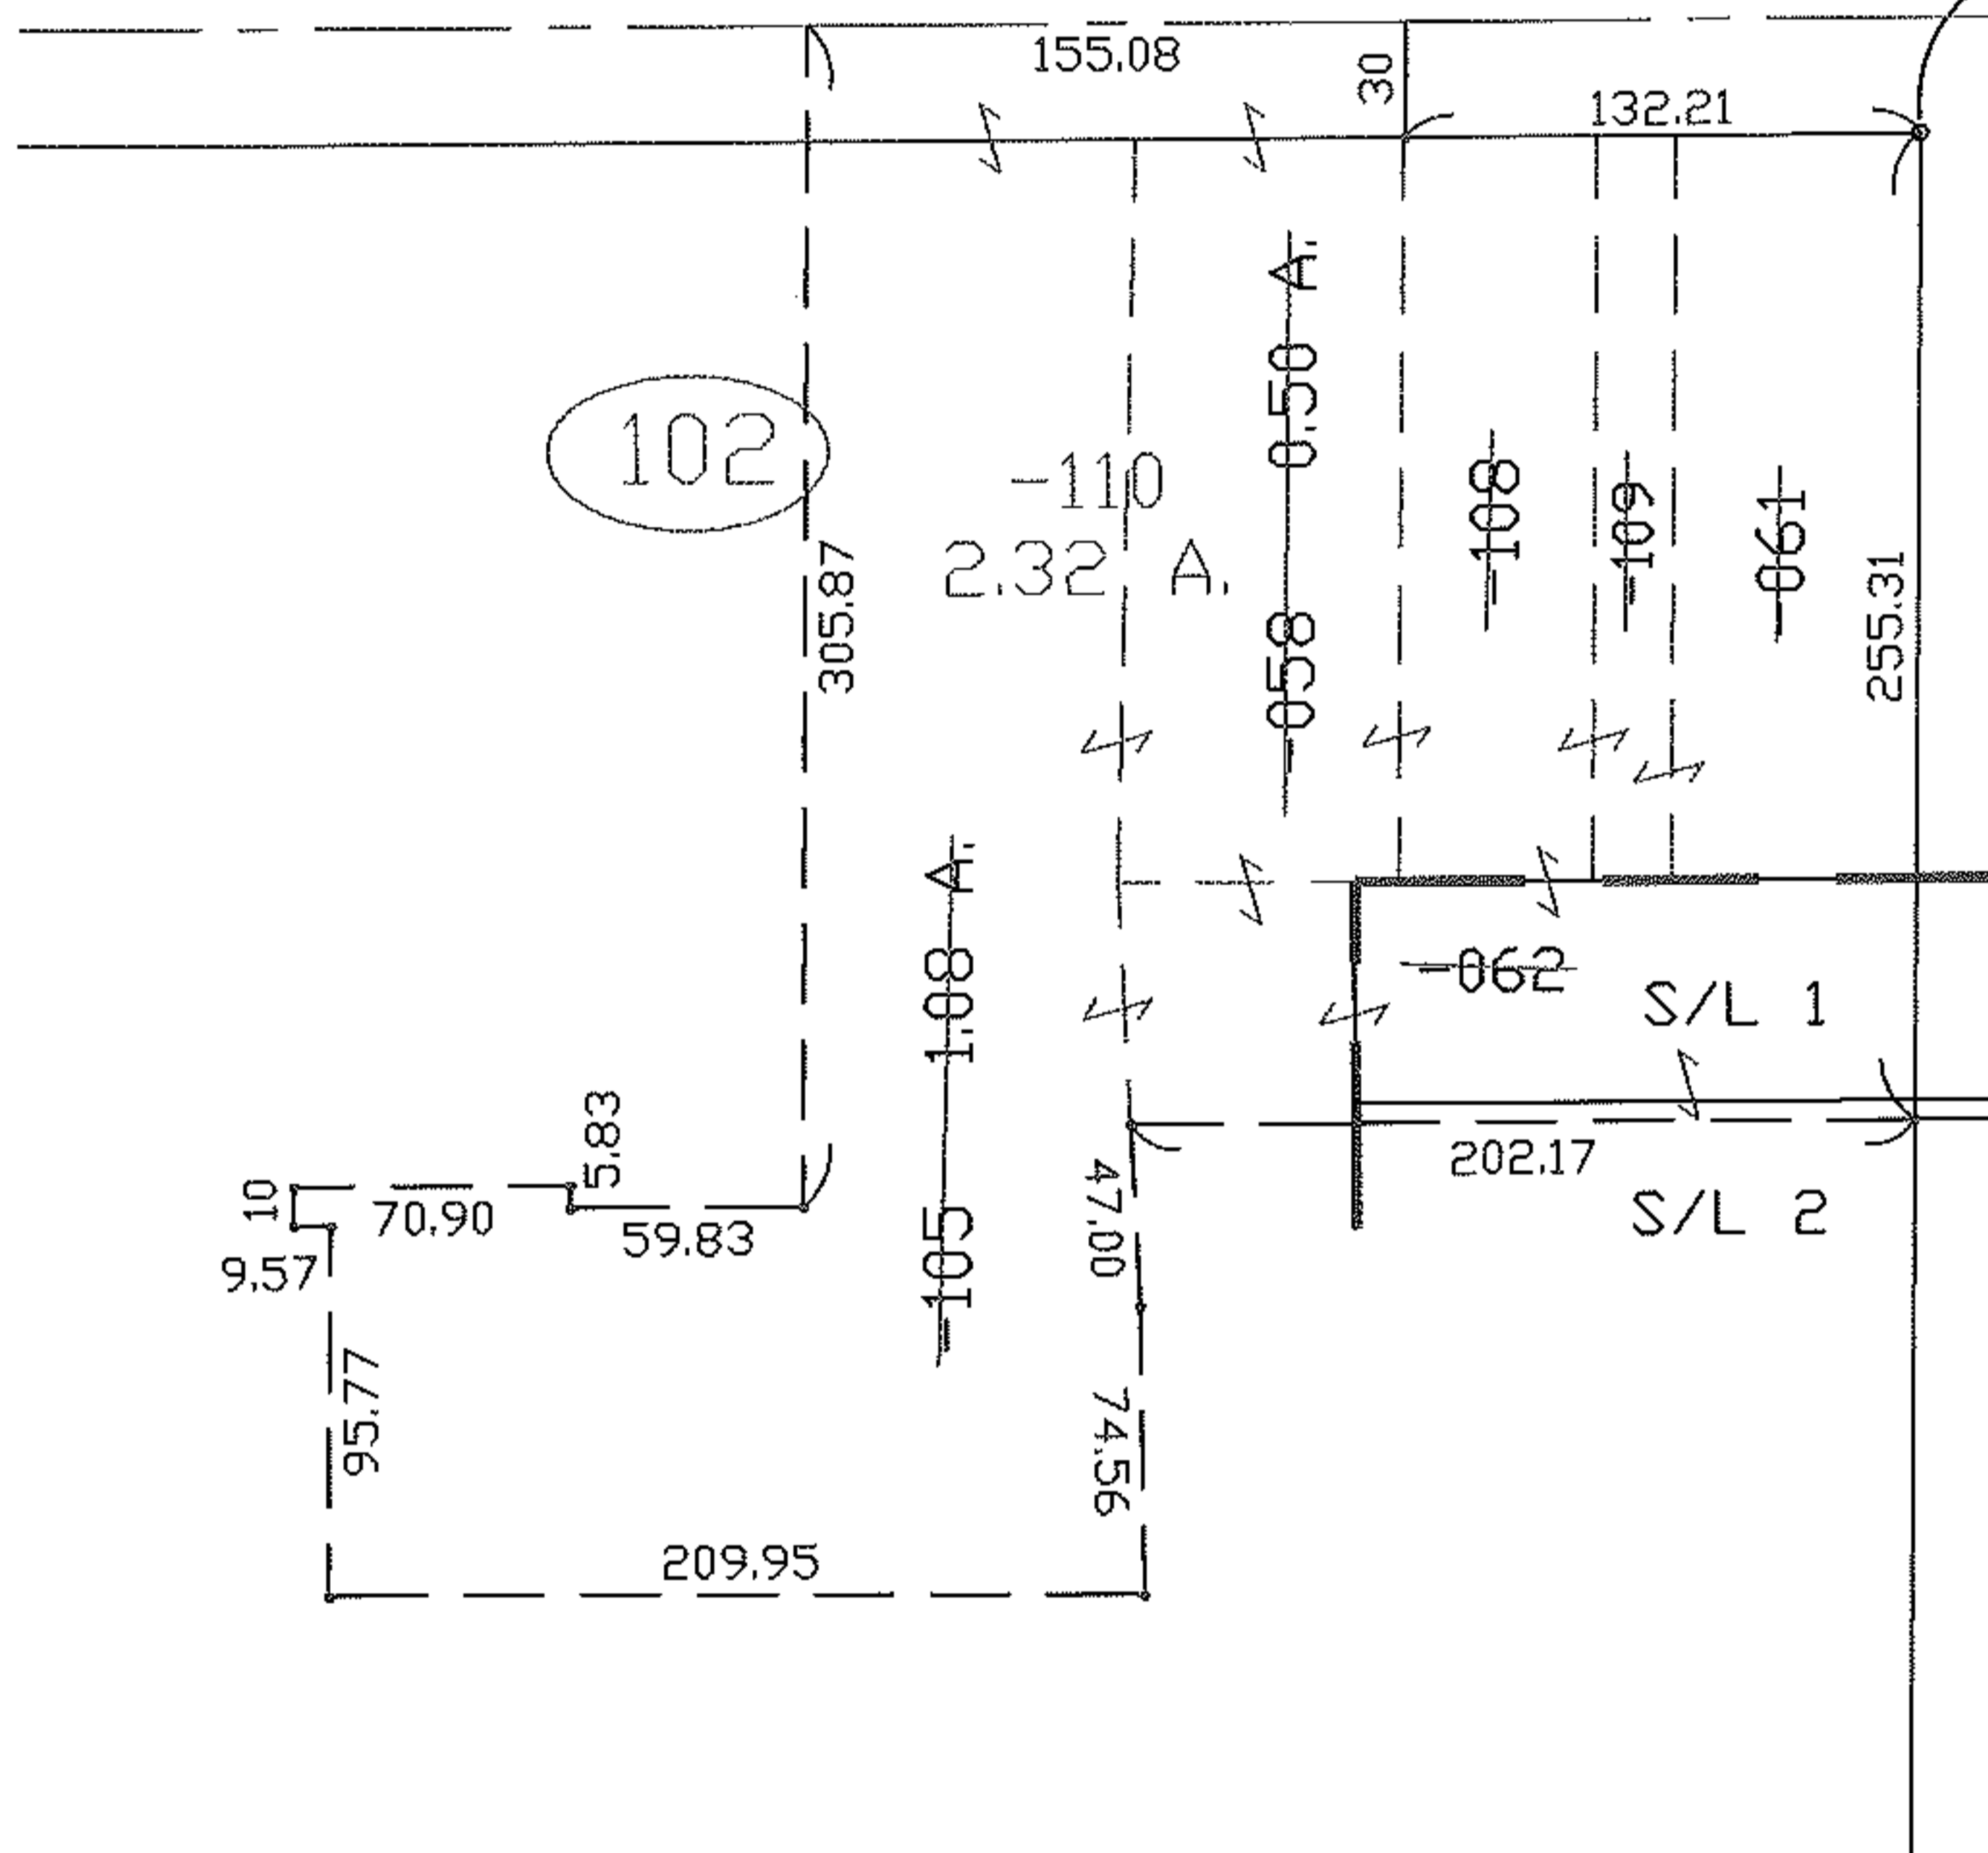

S. PLEASANT ST. 46.20'

PRIOR INSTRUMENT: 20050094943

PRIOR INSTRUMENT: 20030962280

PRIOR INSTRUMENT: 2004015750

SPLITS/DEEDS PROCESSED

LORAIN COUNTY TAX MAP DEPARTMENT
226 MIDDLE AVE. ELYRIA, OHIO

SURVEYED BY: DAVID ELWELL

CLOSURE: 1: 10.978

MAP PAGE(S): 09-00-086-A

APPROVED BY: IJS DATE: 10/31/08

SCALE: 1" = 100