


RASTER

PARENT PARCEL: 08-00-103-000-040

CHILD PARCEL: 08-00-103-000-046, -047



STARTING POINT: CENTERLINE OF RUSSIA RD & BAUMHART RD

08-02630

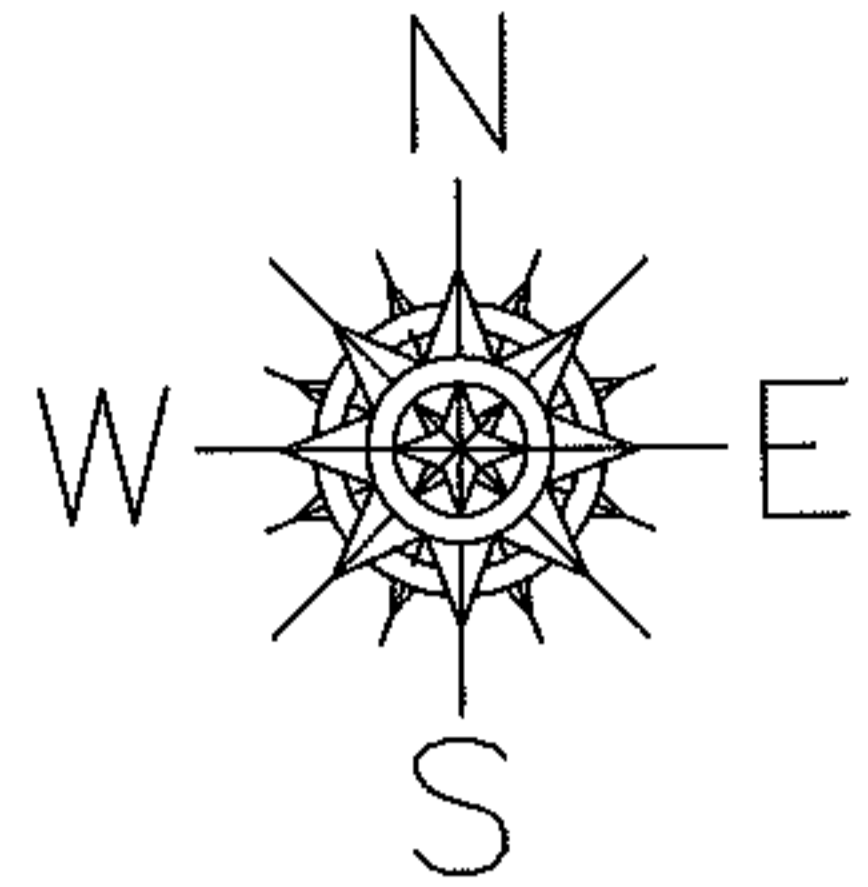

RUSSIA RD

BAUMHART RD

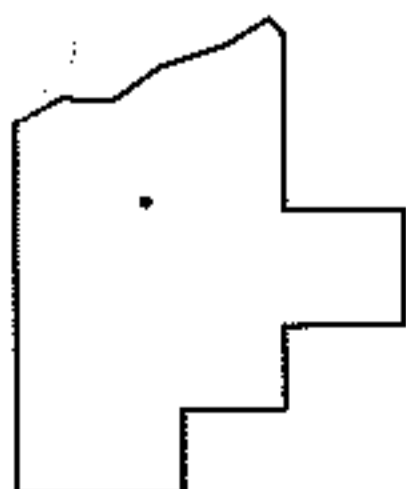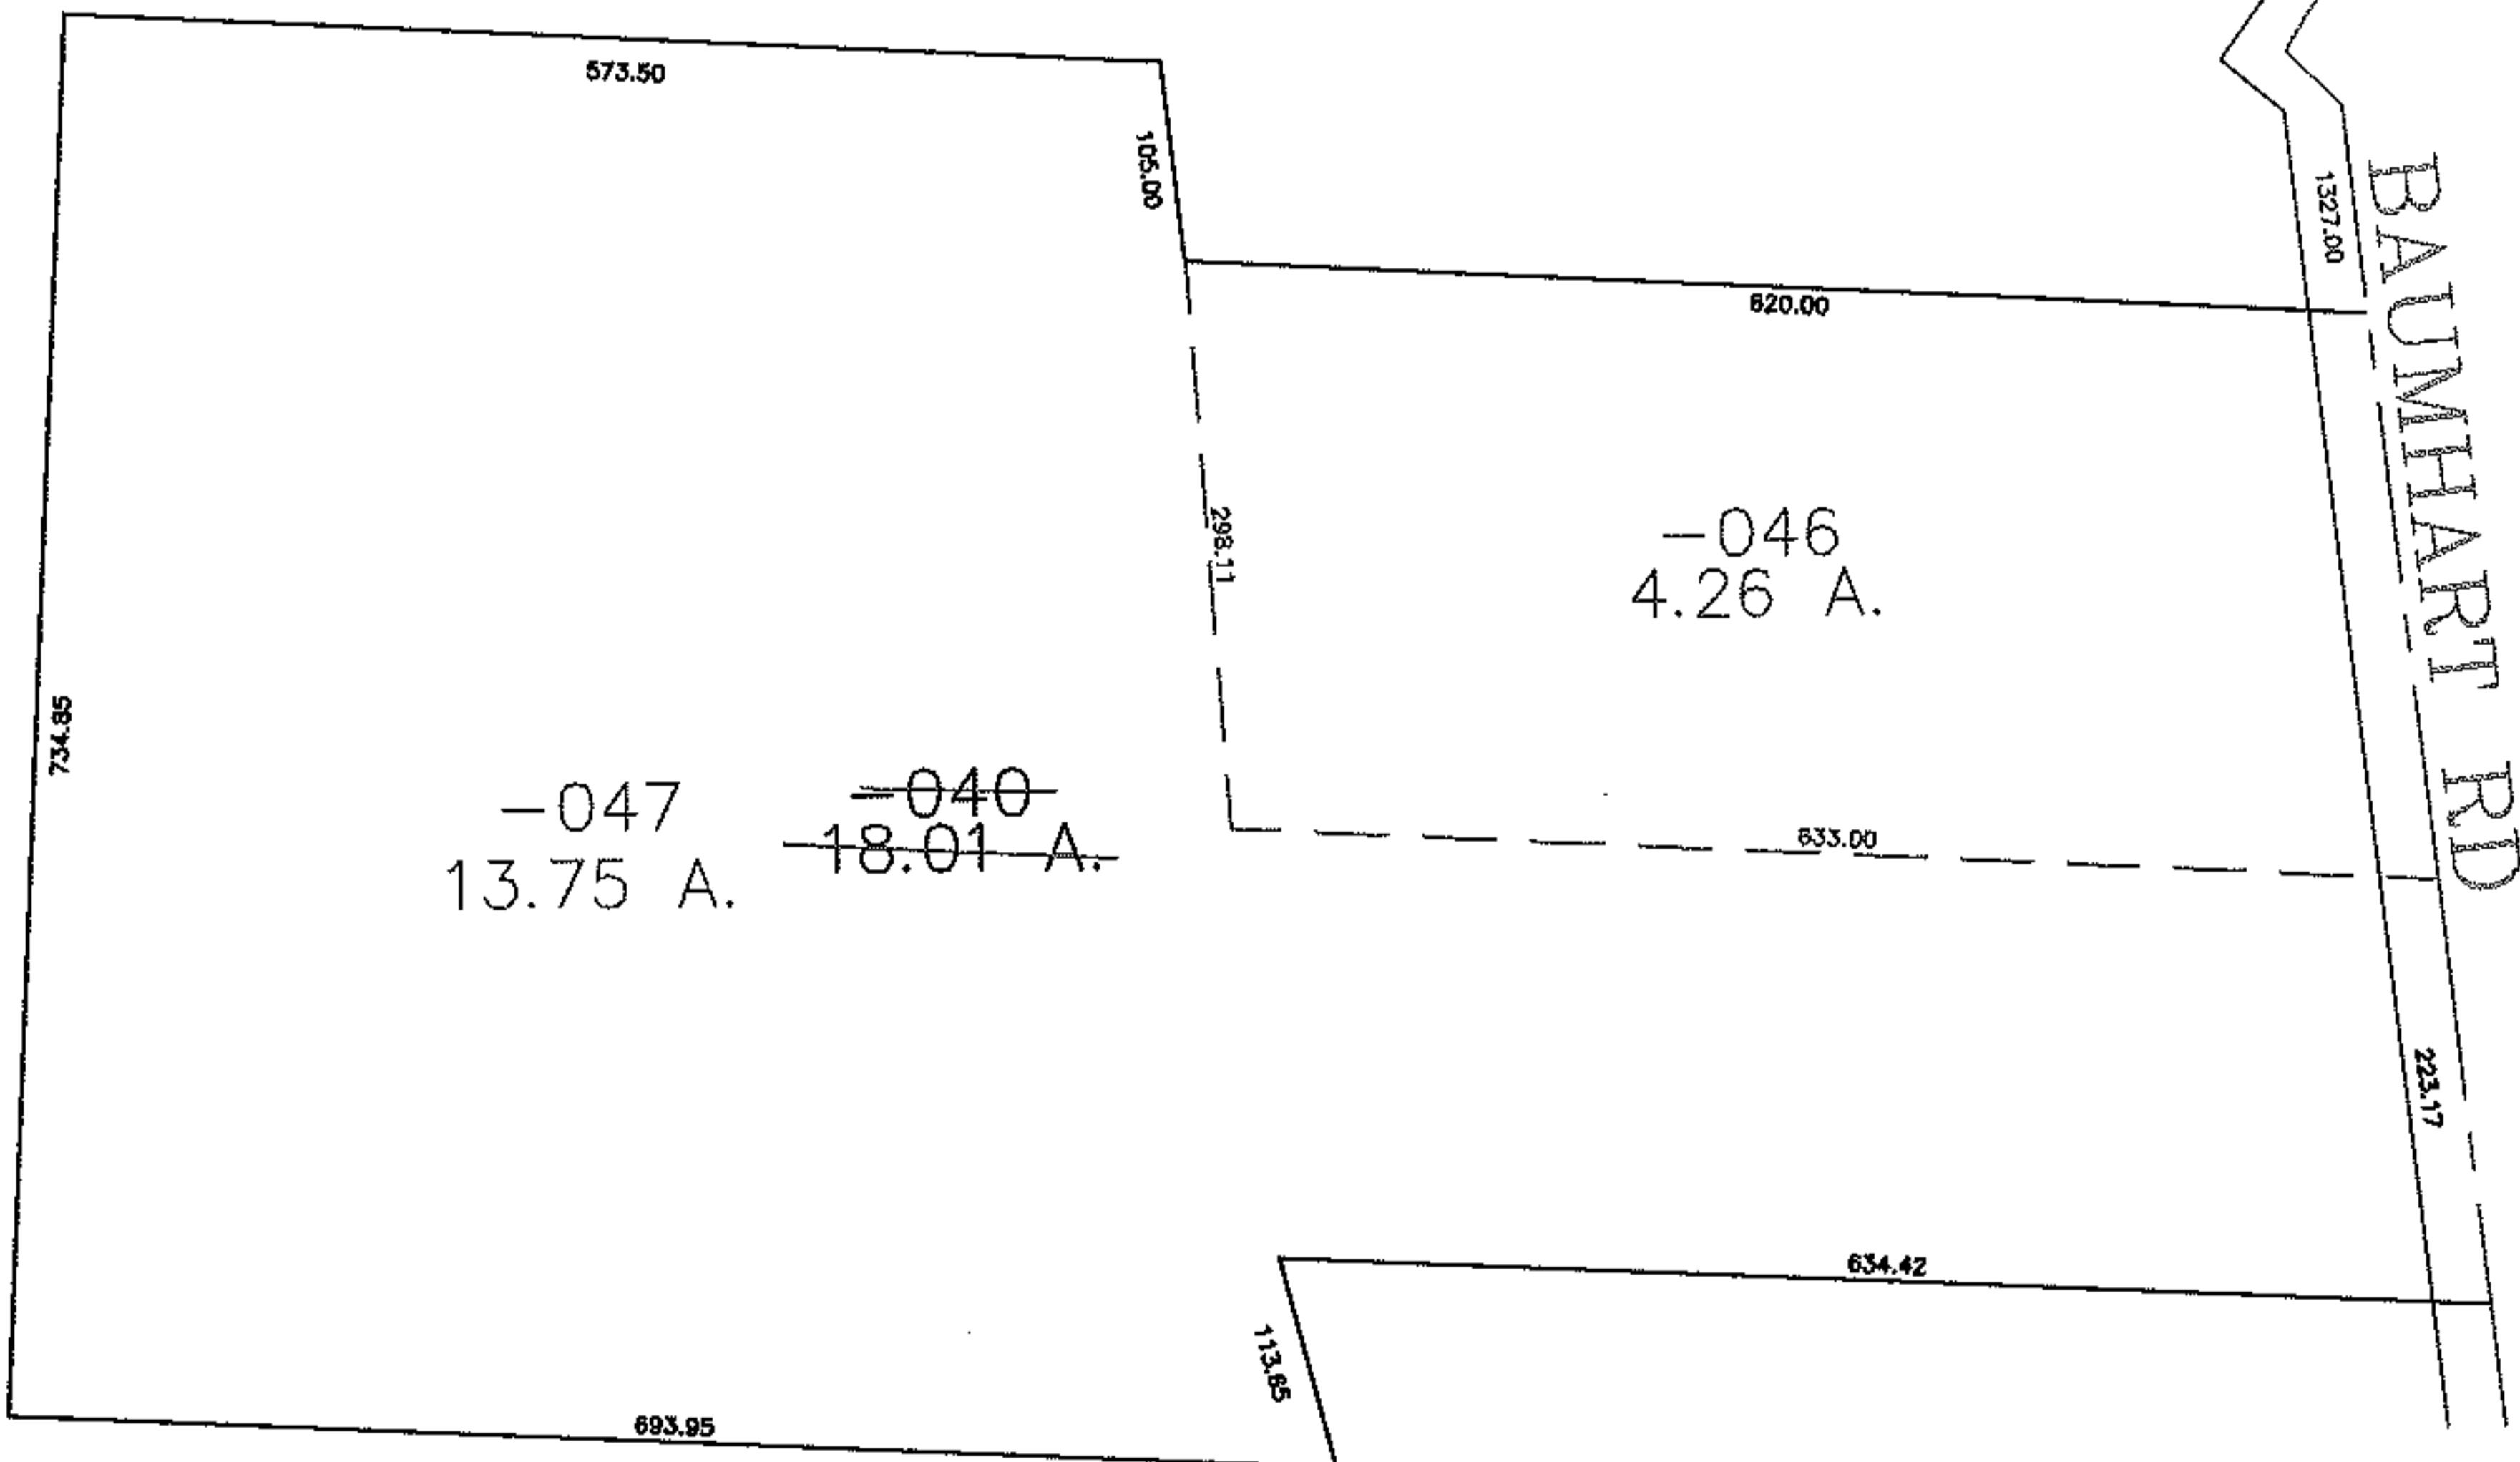

SPLITS/DEEDS PROCESSED
 LORAIN COUNTY TAX MAP DEPARTMENT
 226 MIDDLE AVE. ELYRIA, OHIO

SURVEYED BY: THOMAS SIMON
 CLOSURE: 0.00 : 10.000
 MAP PAGE(S): 8-D
 APPROVED BY: JAH DATE: 11-4-08
 SCALE: 1" = 200' PRIOR INSTRUMENT: 19970492894