


RASTER

PARENT PARCEL: 04-00-023-101-006



CHILD PARCEL: 04-00-023-101-050, -051

STARTING POINT: CENTERLINE OF DETROIT RD & JAYCOX RD

08-02632

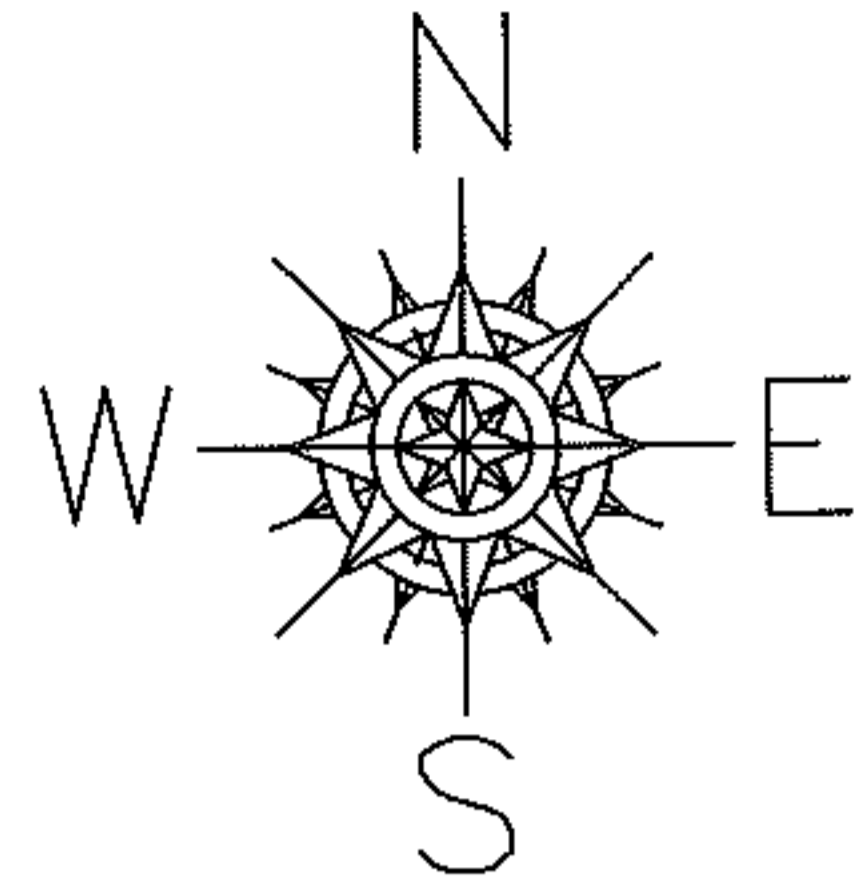

--- DETROIT RD ---

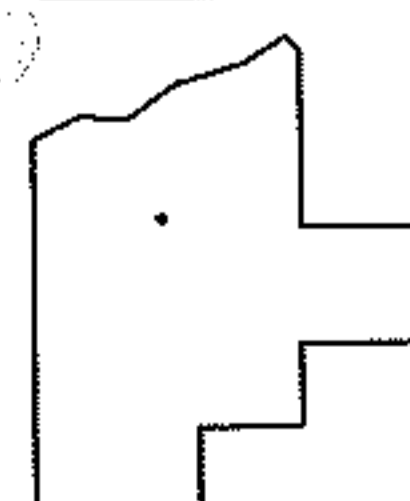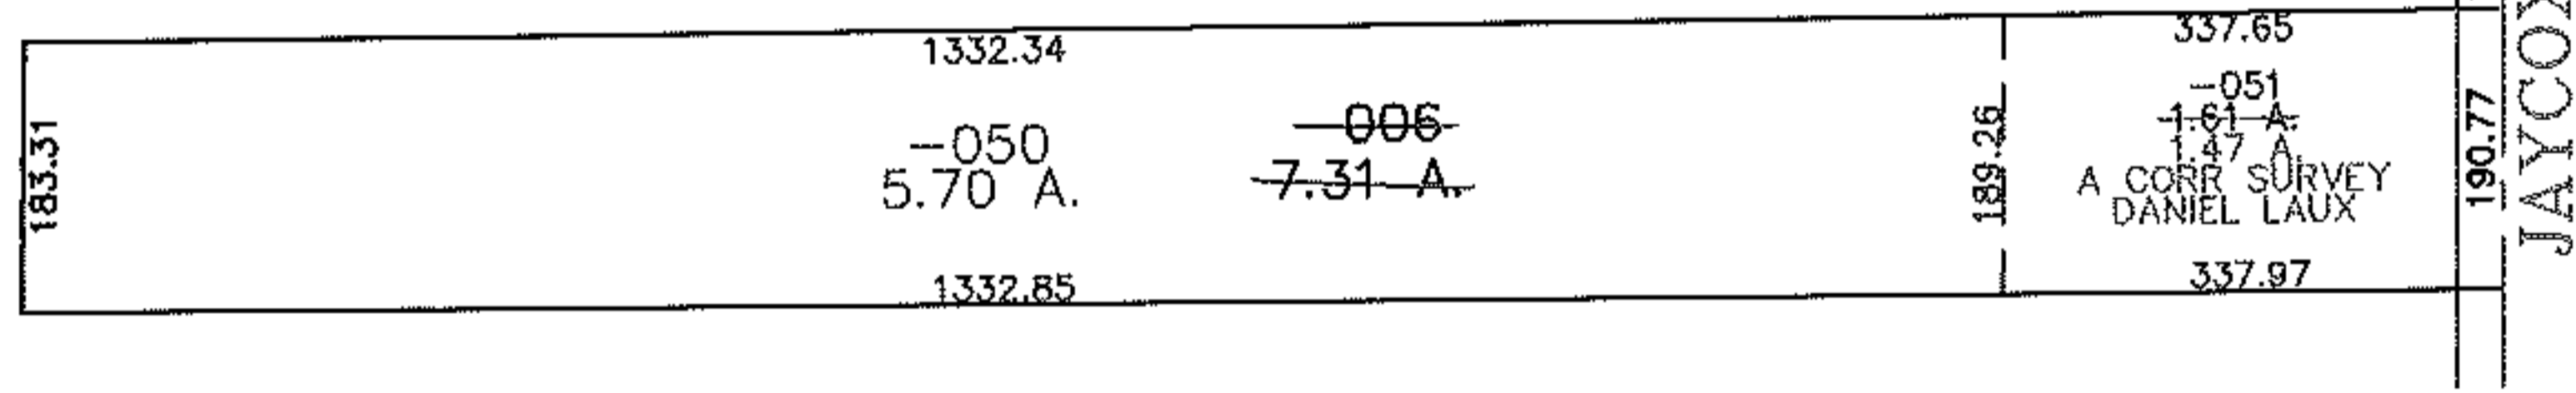

SPLITS/DEEDS PROCESSED
 LORAIN COUNTY TAX MAP DEPARTMENT
 226 MIDDLE AVE. ELYRIA, OHIO

SURVEYED BY: DANIEL LAUX
 CLOSURE: 0.00 : 10.000
 MAP PAGE(S): 04-00-023-B
 APPROVED BY: JAH DATE: 11-7-08
 SCALE: 1" = 300 PRIOR INSTRUMENT: OR 1057/881