



RASTER

PARENT PARCEL: 07-00-039-000-042, -045, -046, -047


CHILD PARCEL: 07-00-039-000-085 THRU -088

STARTING POINT: CENTERLINE OF RACE RD & O.L. 39

08-02634

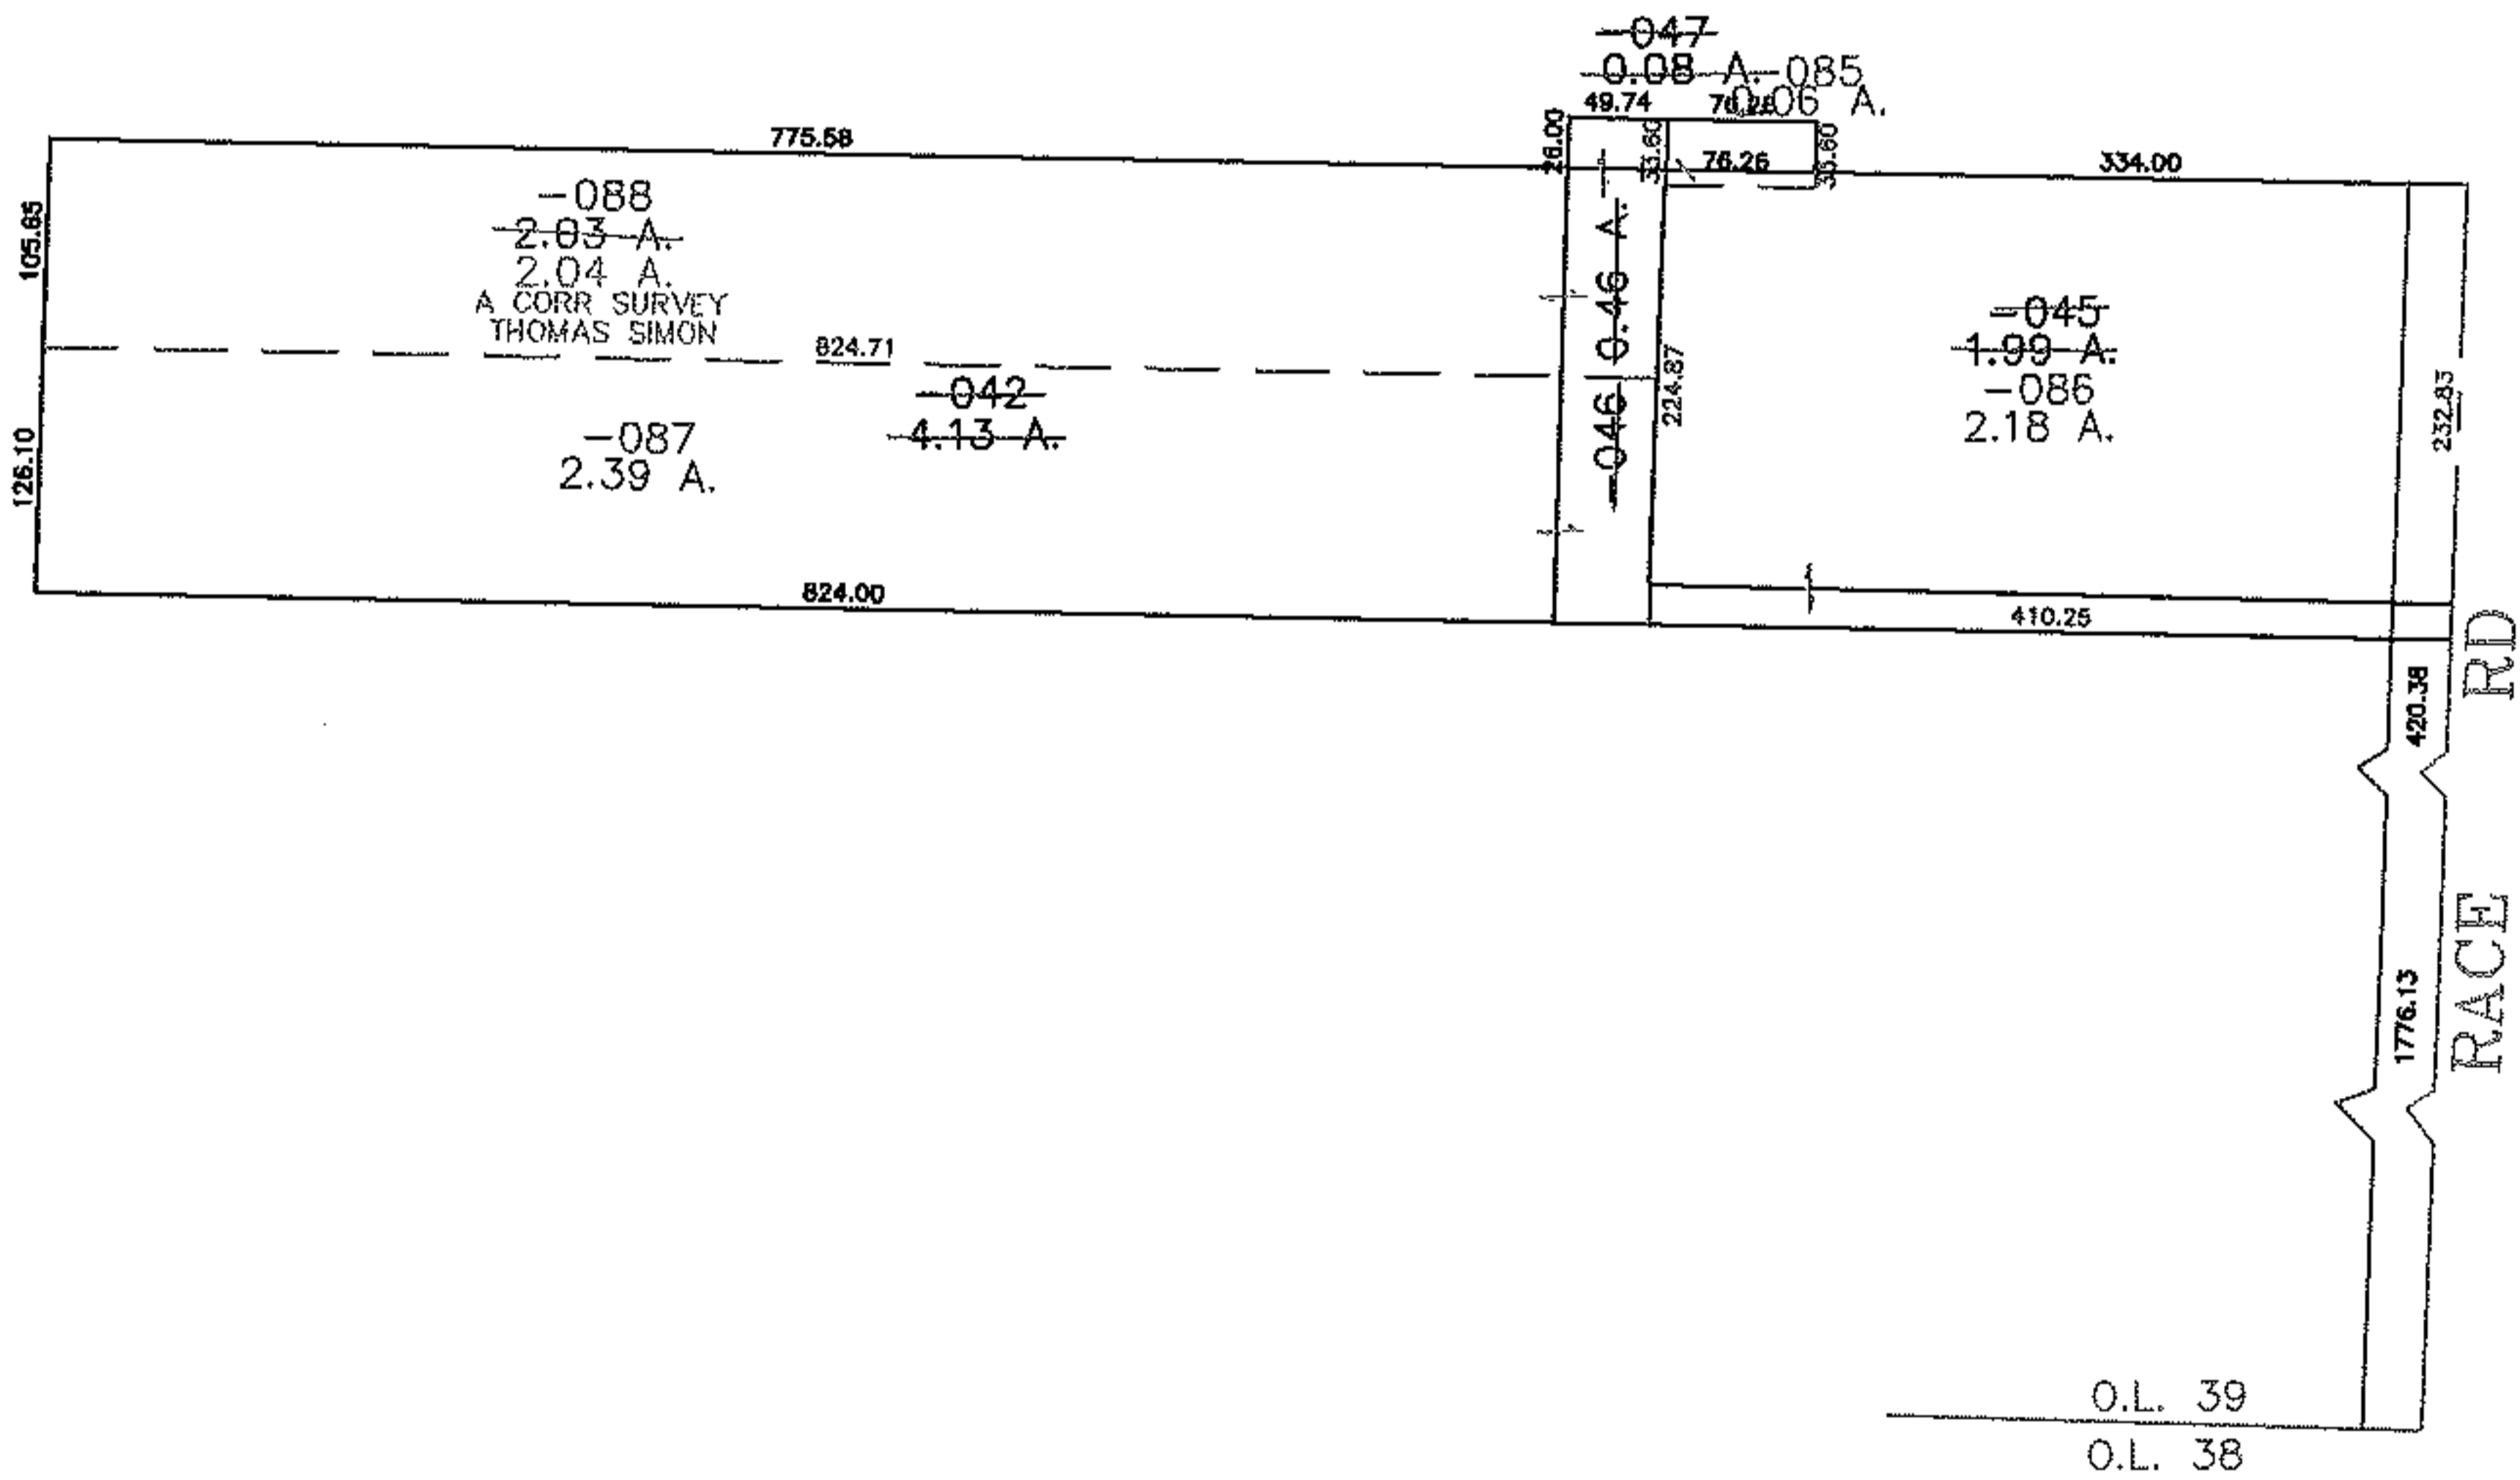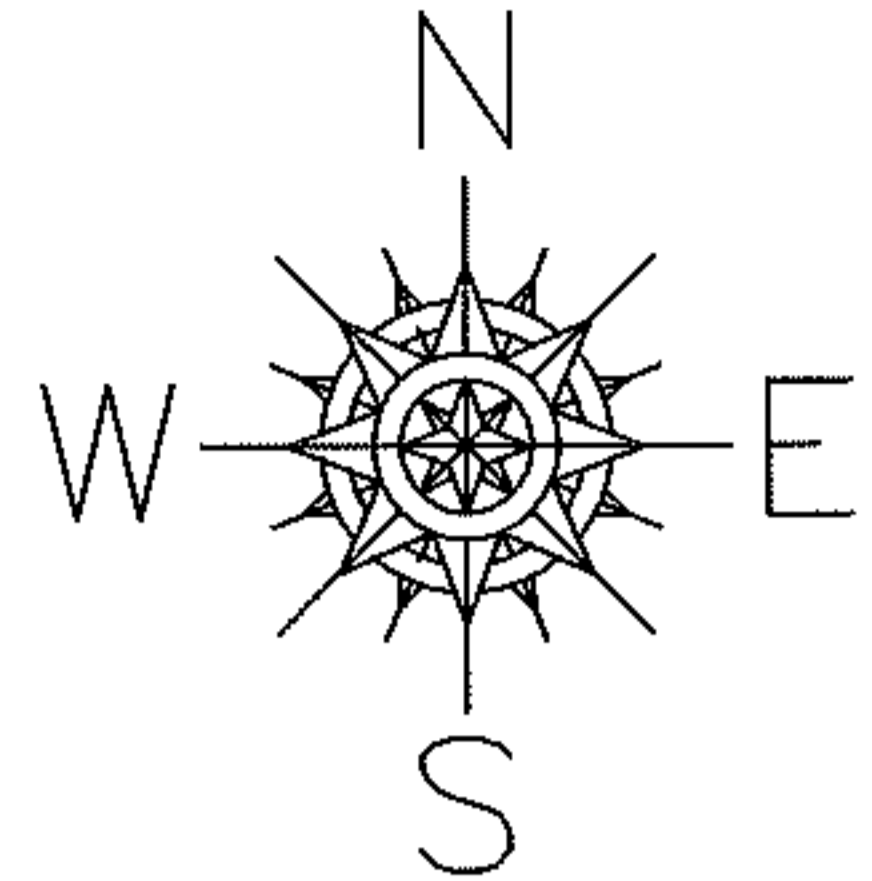

O.L. 39
O.L. 38

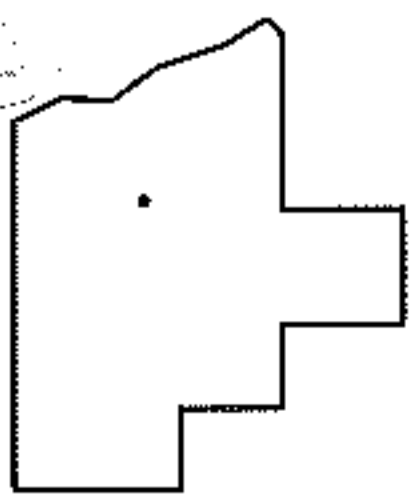

SPLITS/DEEDS PROCESSED
LORAIN COUNTY TAX MAP DEPARTMENT
226 MIDDLE AVE. ELYRIA, OHIO

SURVEYED BY: THOMAS SIMON
CLOSURE: 0.00 : 10,000
MAP PAGE(S): 07-00-039-D
APPROVED BY: JAH DATE: 11-13-08
SCALE: 1" = 200 PRIOR INSTRUMENT: 19910156140