
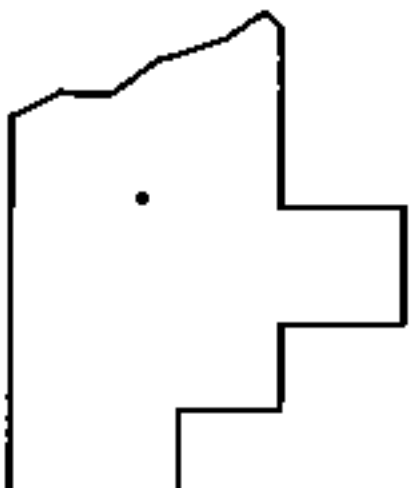
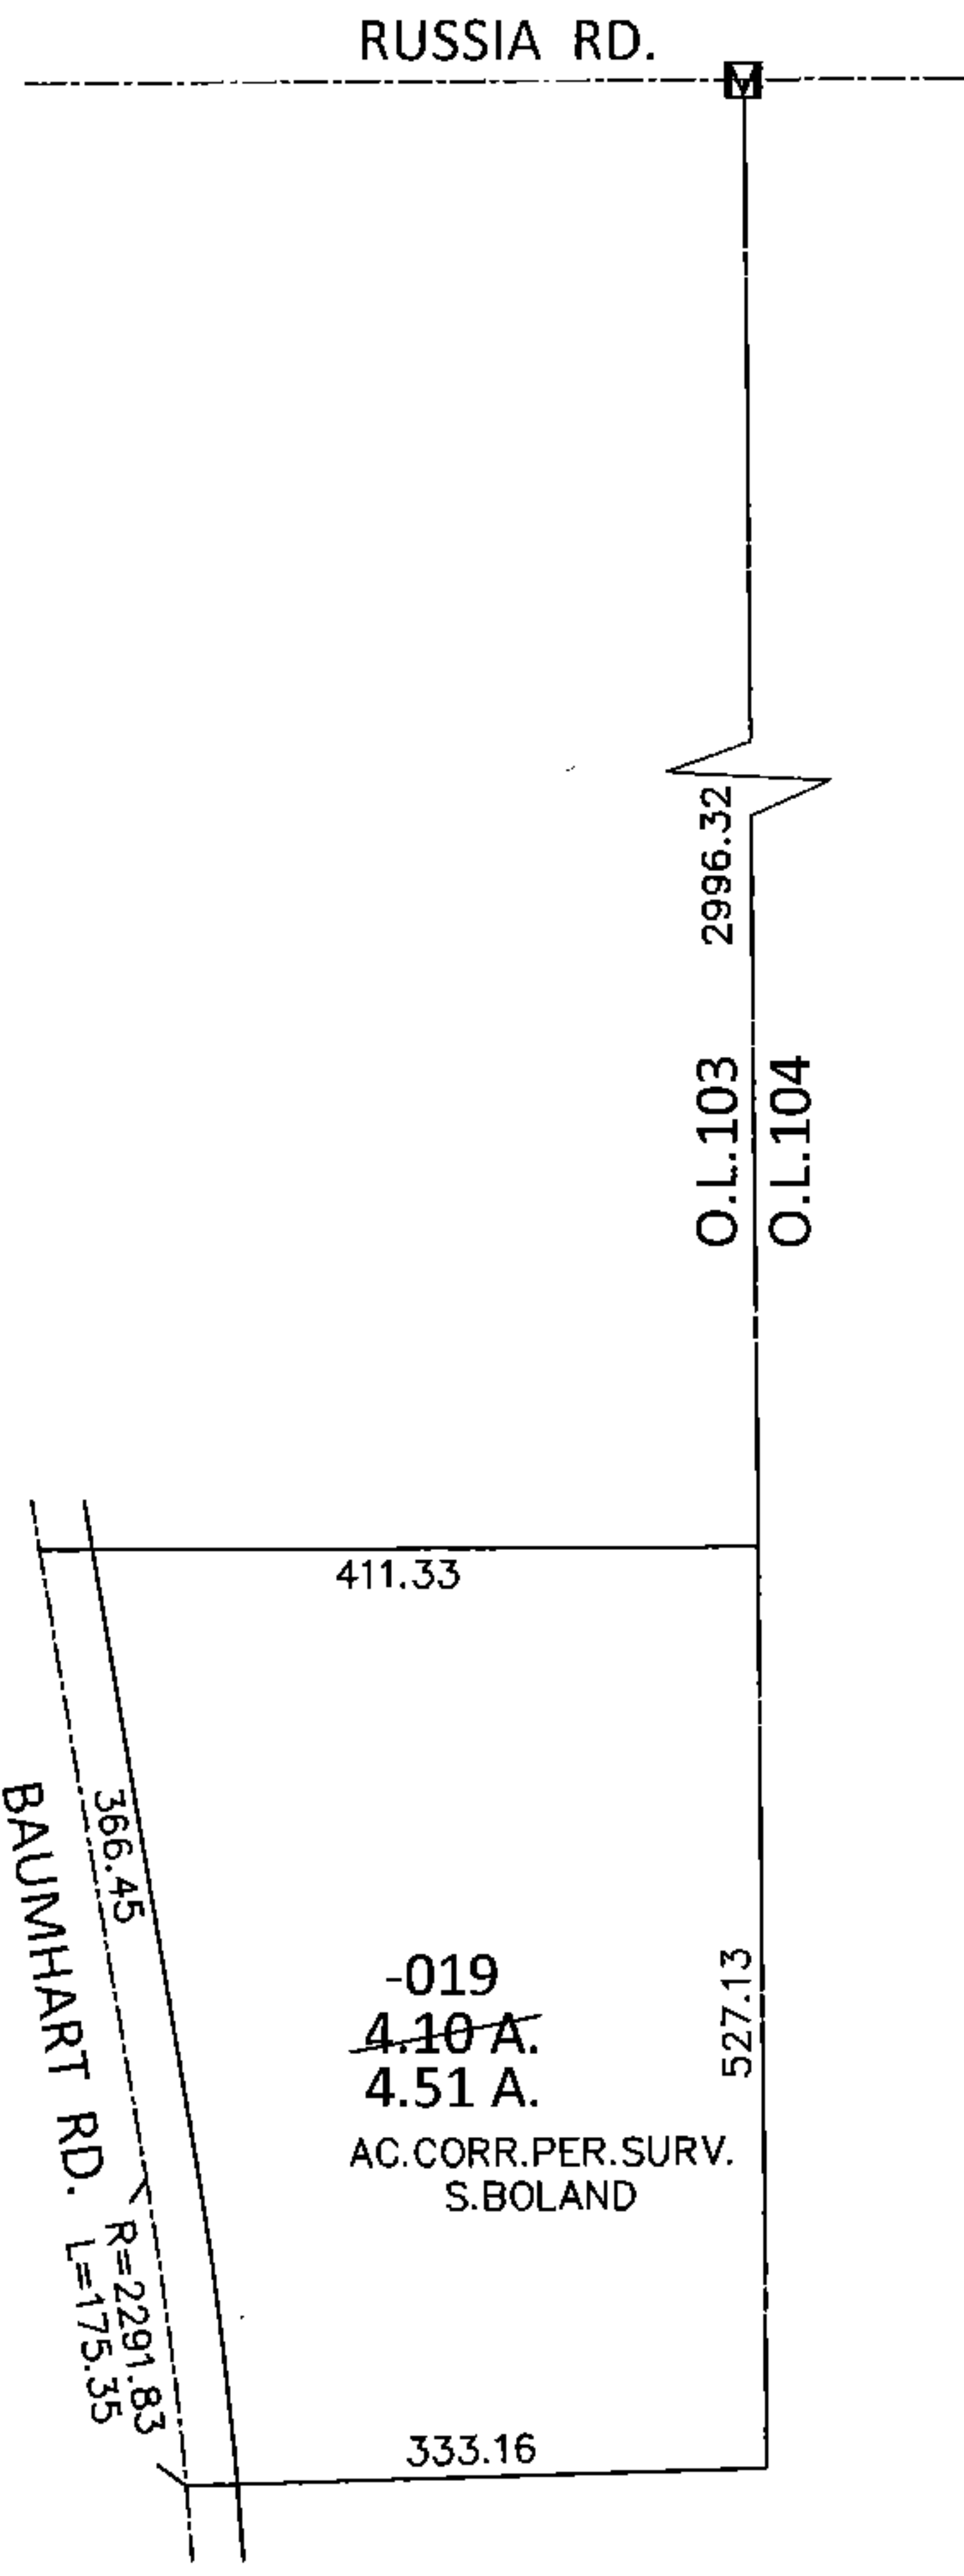


PARENT PARCEL: 08-00-103-000-019

CHILD PARCEL: \_\_\_\_\_

STARTING POINT: AT A MON BOX AT THE INTERSECTION OF C/L OF RUSSIA RD. AND EAST LINE OF O.L.103

12-02635-A

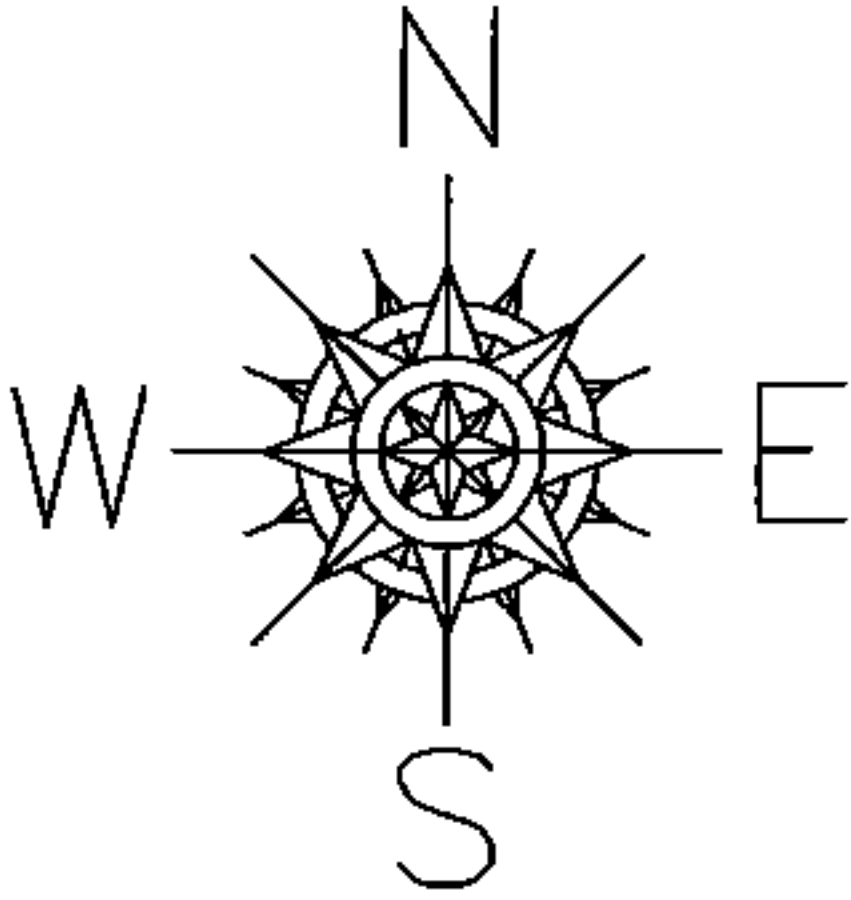

**SPLITS/DEEDS PROCESSED**

LORAIN COUNTY TAX MAP DEPARTMENT  
226 MIDDLE AVE. ELYRIA, OHIO

SURVEYED BY: SEAN A. BOLAND  
 CLOSURE: .01:10,000  
 MAP PAGE(S): 8-D  
 APPROVED BY: RRM DATE: 12-18-12  
 SCALE: 1"= 200 PRIOR INST.: 20060147364