



RASTER

PARENT PARCEL: 07-00-034-000-113, -116, -118-, 120, -070

CHILD PARCEL: 07-00-034-000-134


STARTING POINT: CENTERLINE OF RACE RD & O.L. 34

08-02637

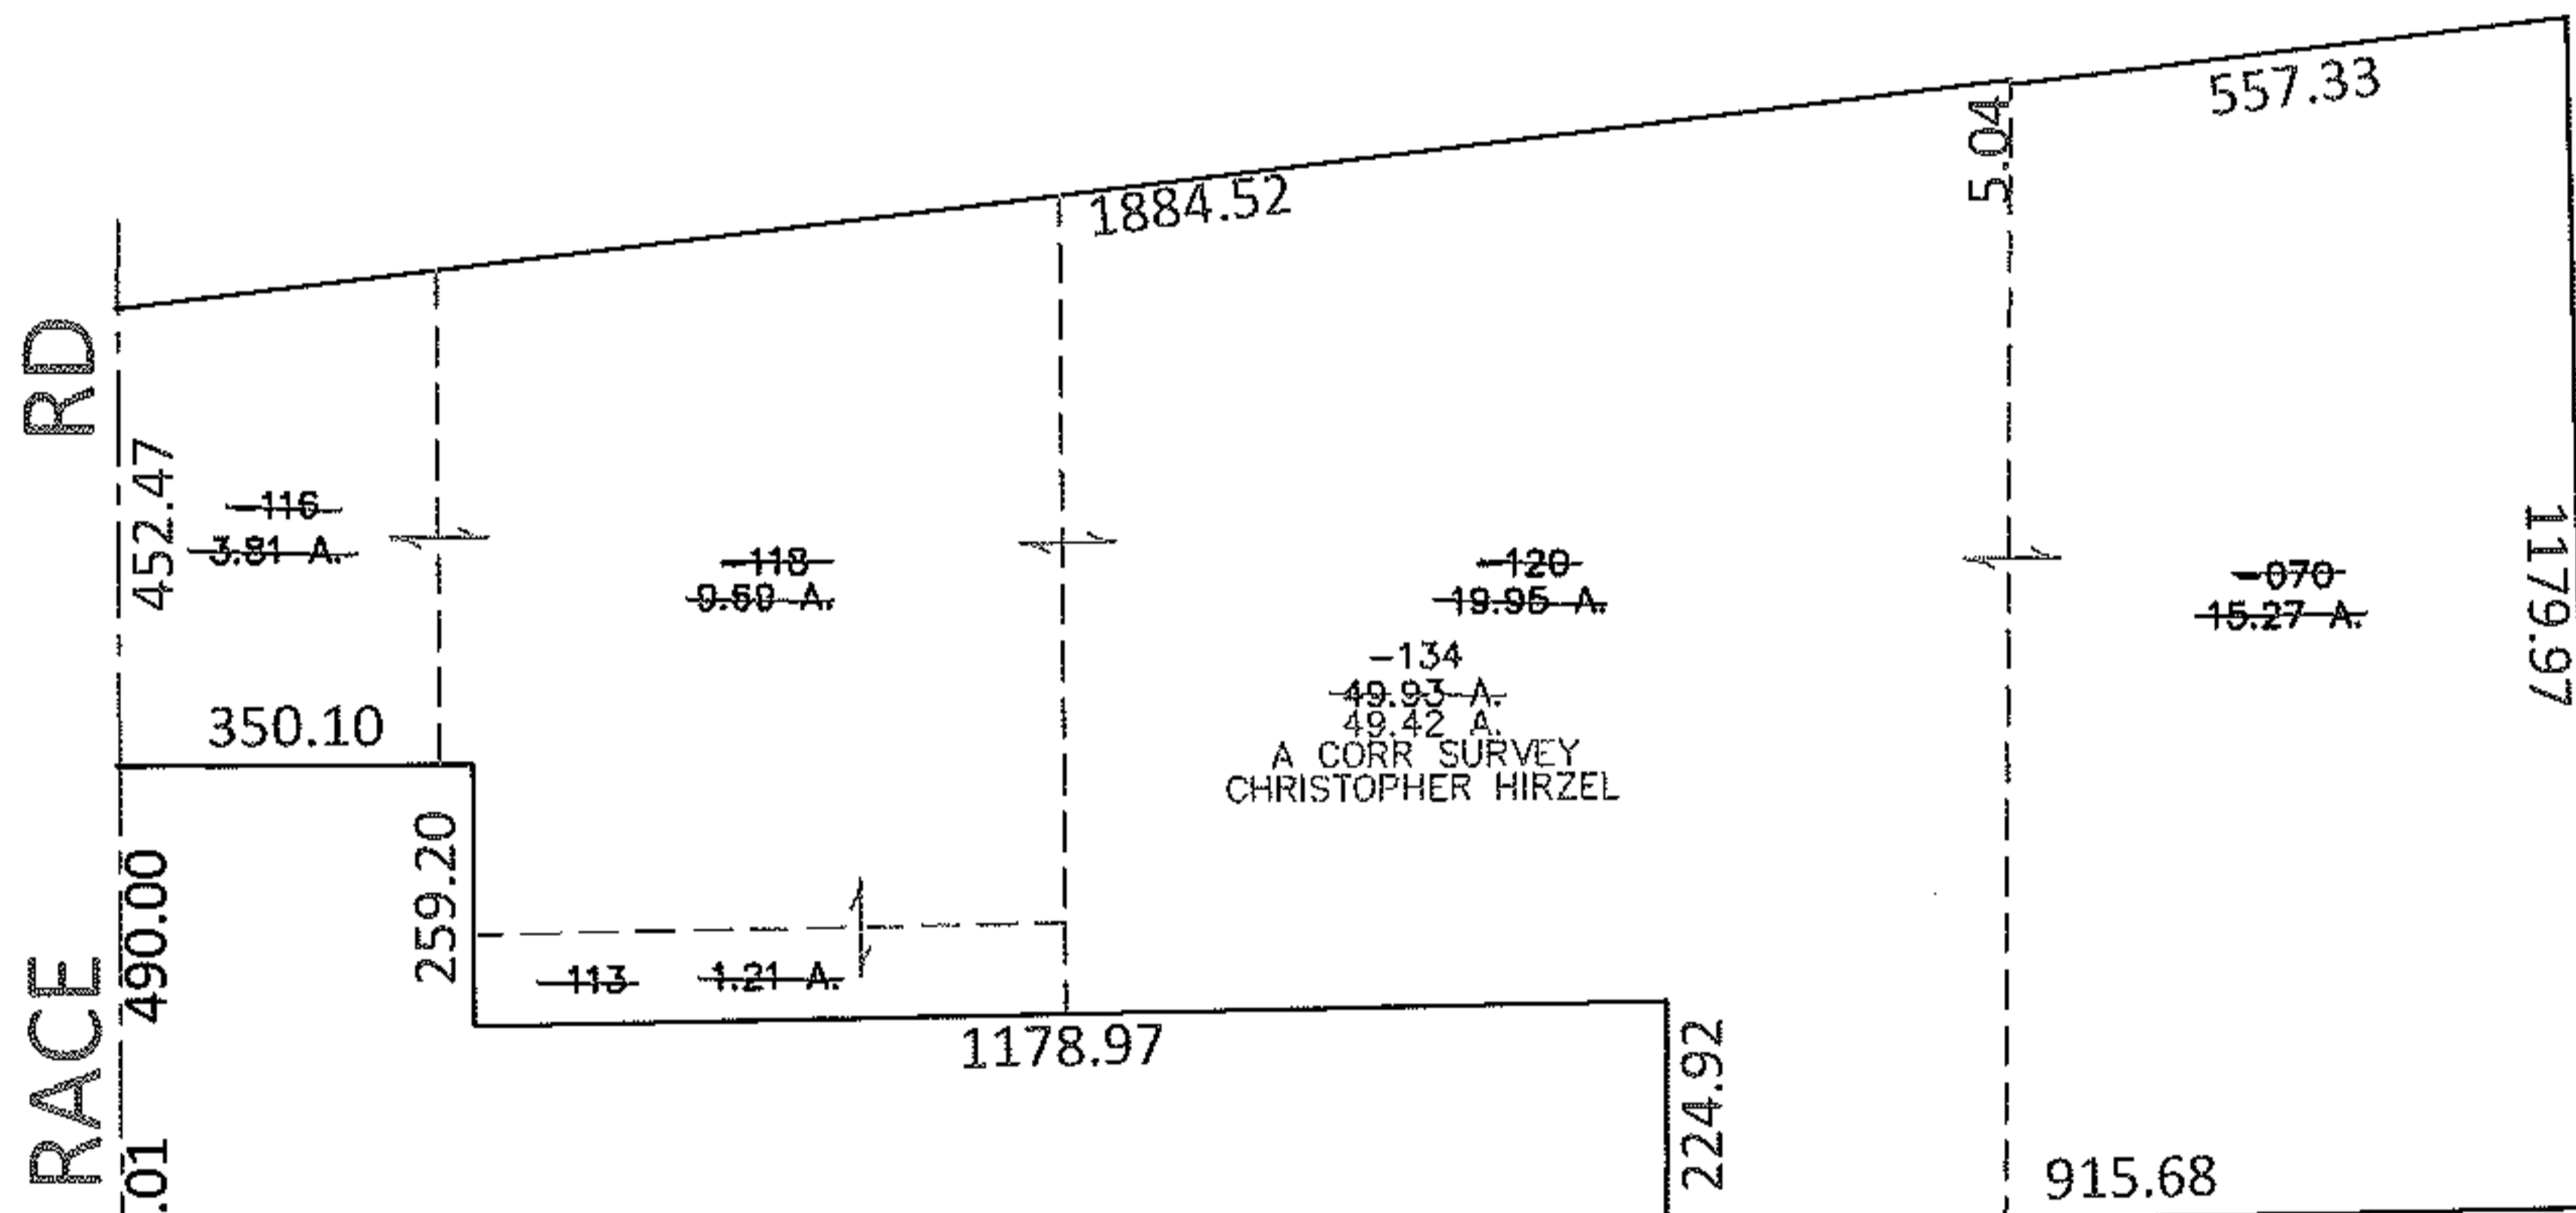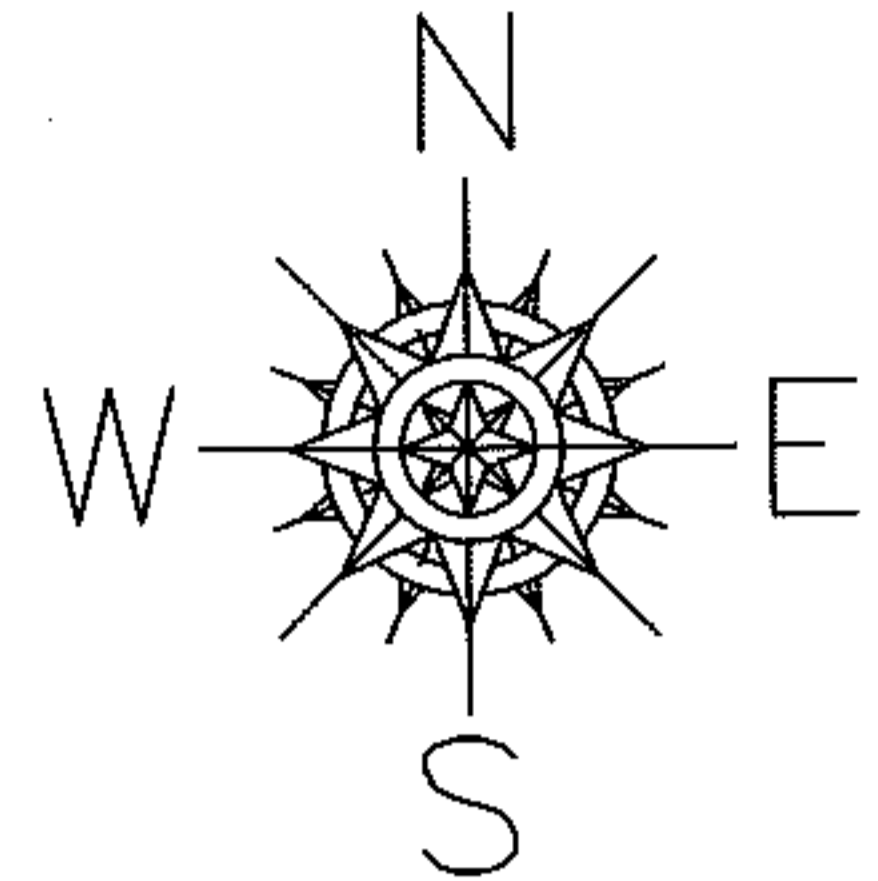

A CORR SURVEY
CHRISTOPHER HIRZEL

O.L. 39 O.L. 34
O.L. 38 O.L. 35 - PENNSYLVANIA LINES LLC

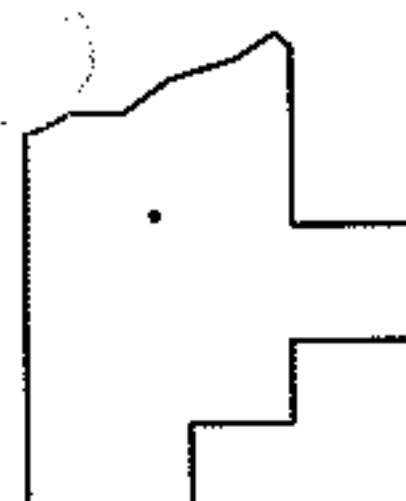

SPLITS/DEEDS PROCESSED
LORAIN COUNTY TAX MAP DEPARTMENT
226 MIDDLE AVE. ELYRIA, OHIO

SURVEYED BY: CHRISTOPHER HIRZEL
CLOSURE: 0.00 : 10,000
MAP PAGE(S): 07-00-034-C
APPROVED BY: JAH DATE: 11-18-08
SCALE: 1" = 400 PRIOR INSTRUMENT: 20070236135