



RASTER

PARENT PARCEL: 04-00-015-103-073, 069 008 006 019 023 036 047 076 026 070 081

CHILD PARCEL: 04-00-015-103-078 THRU -084

STARTING POINT: CENTERLINE OF DETROIT RD & MIDDLETON RD

08-02638

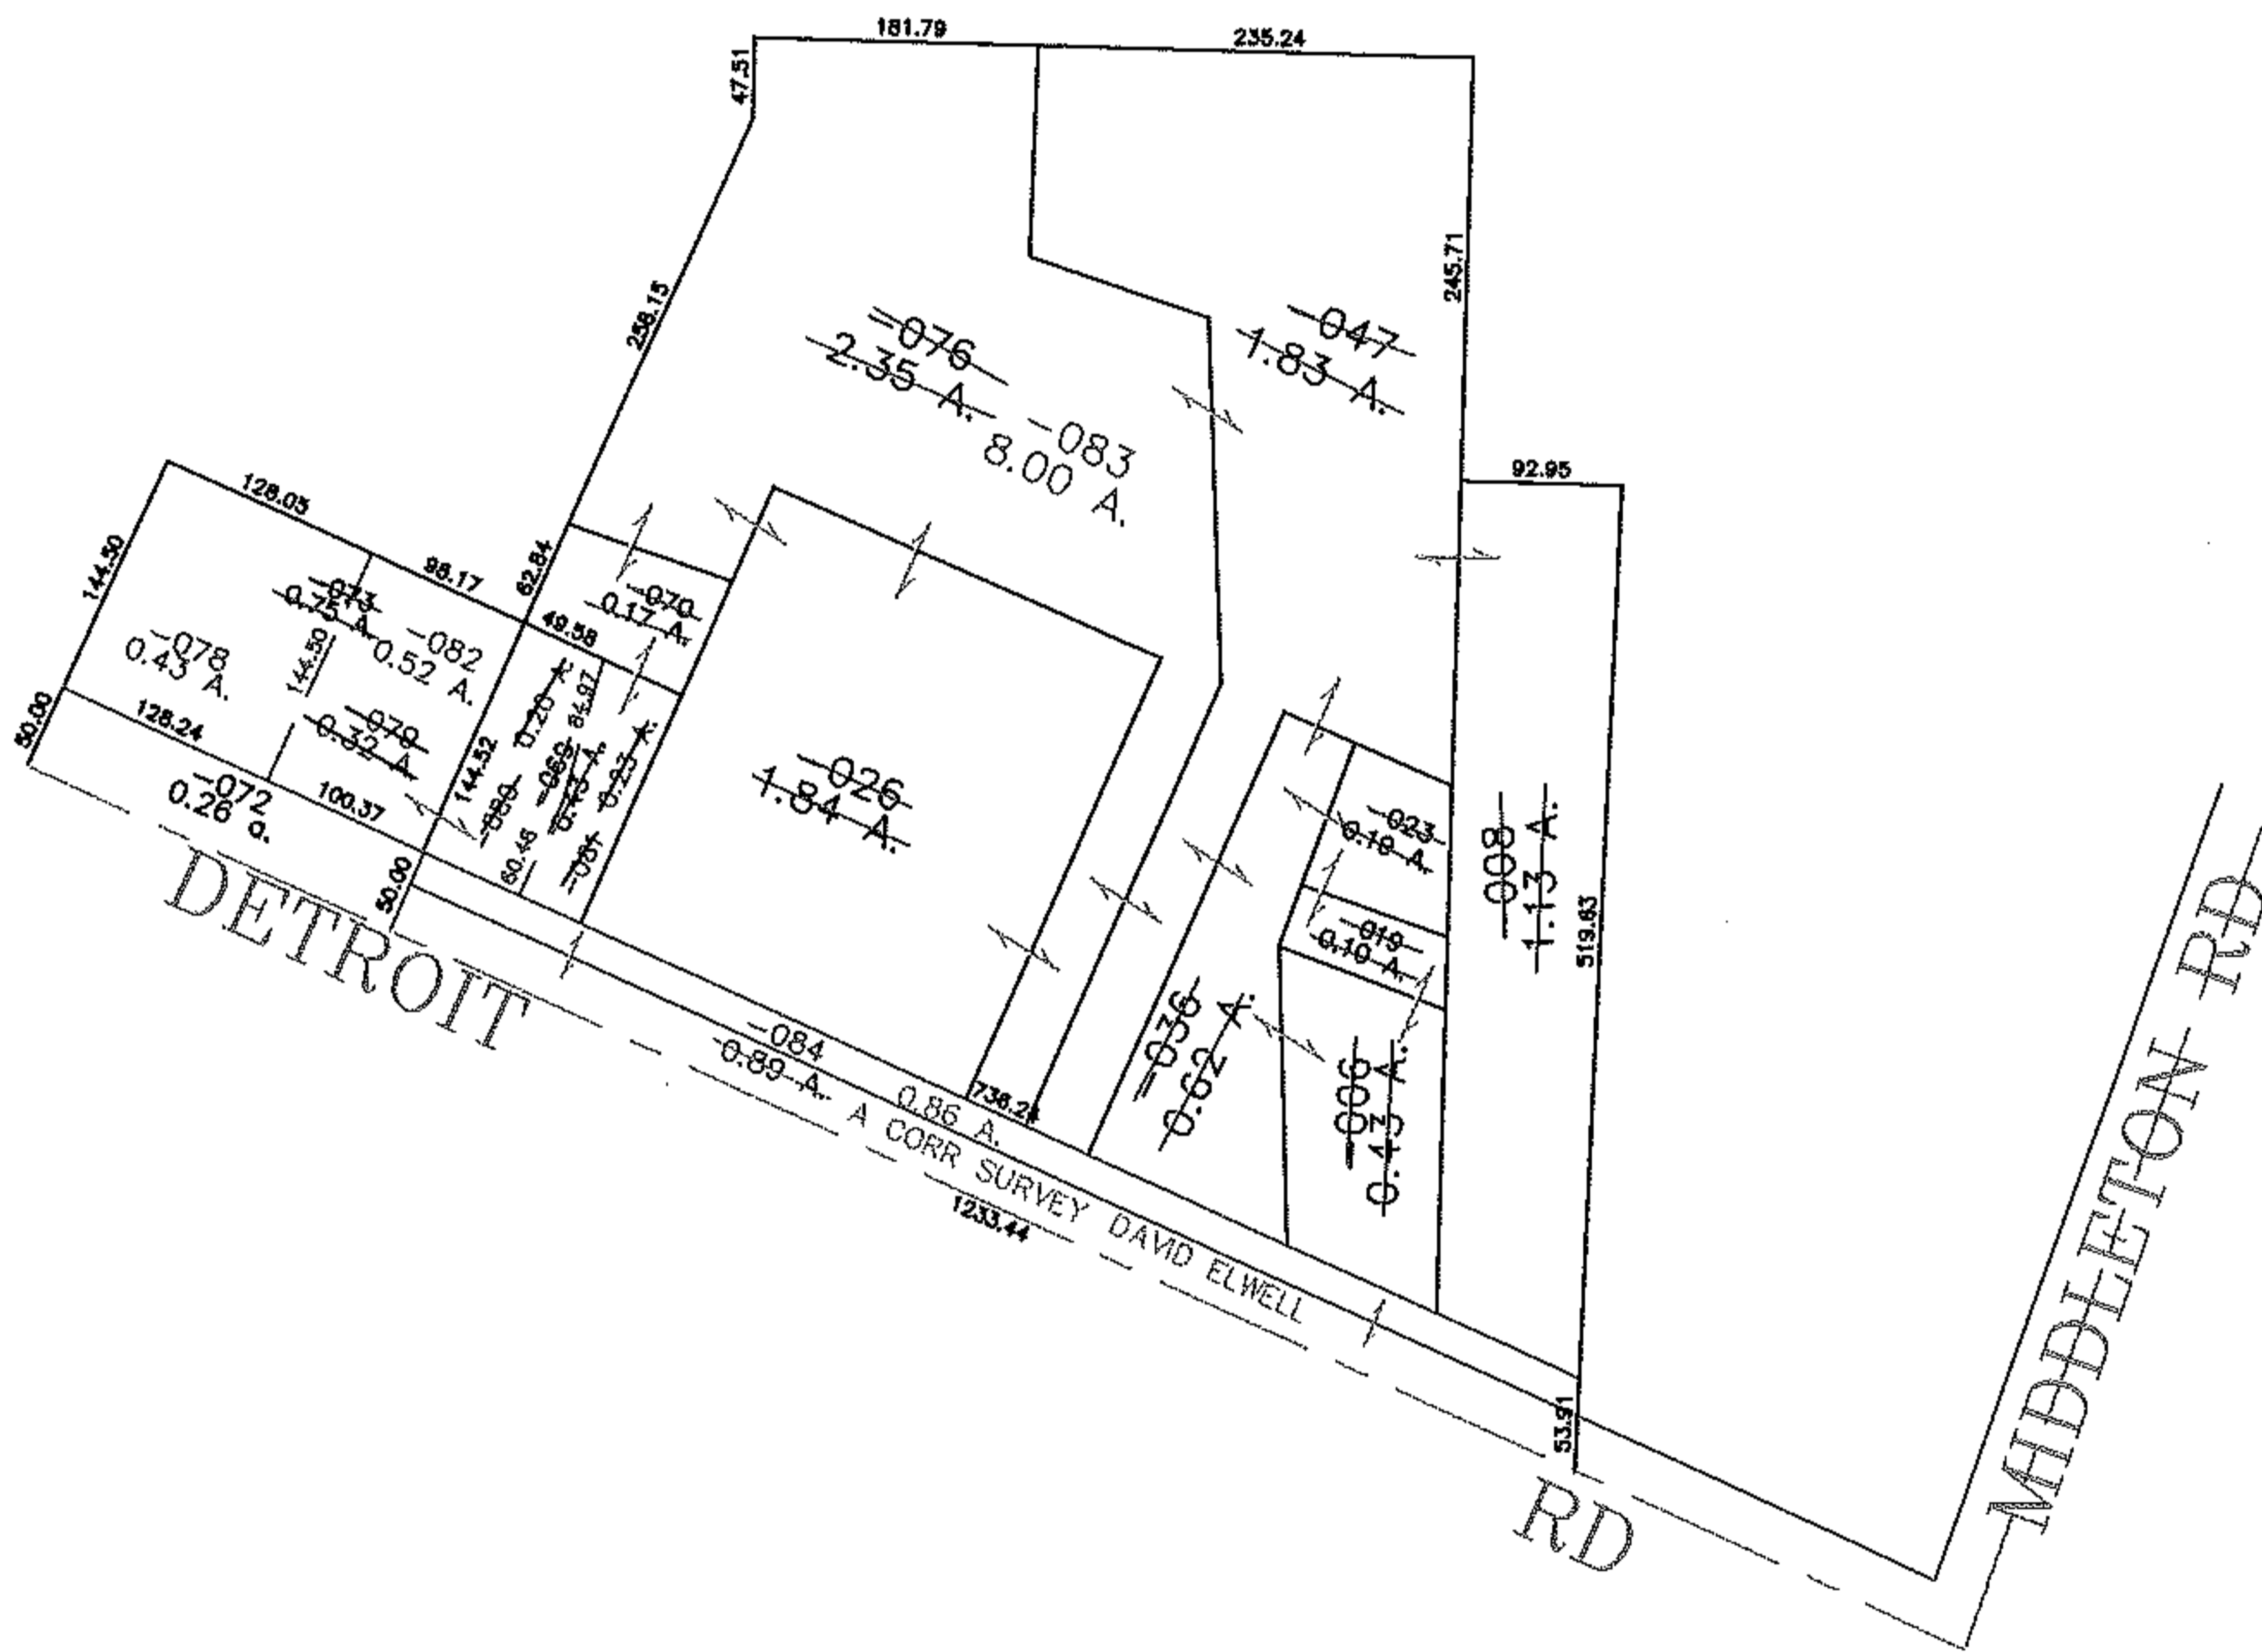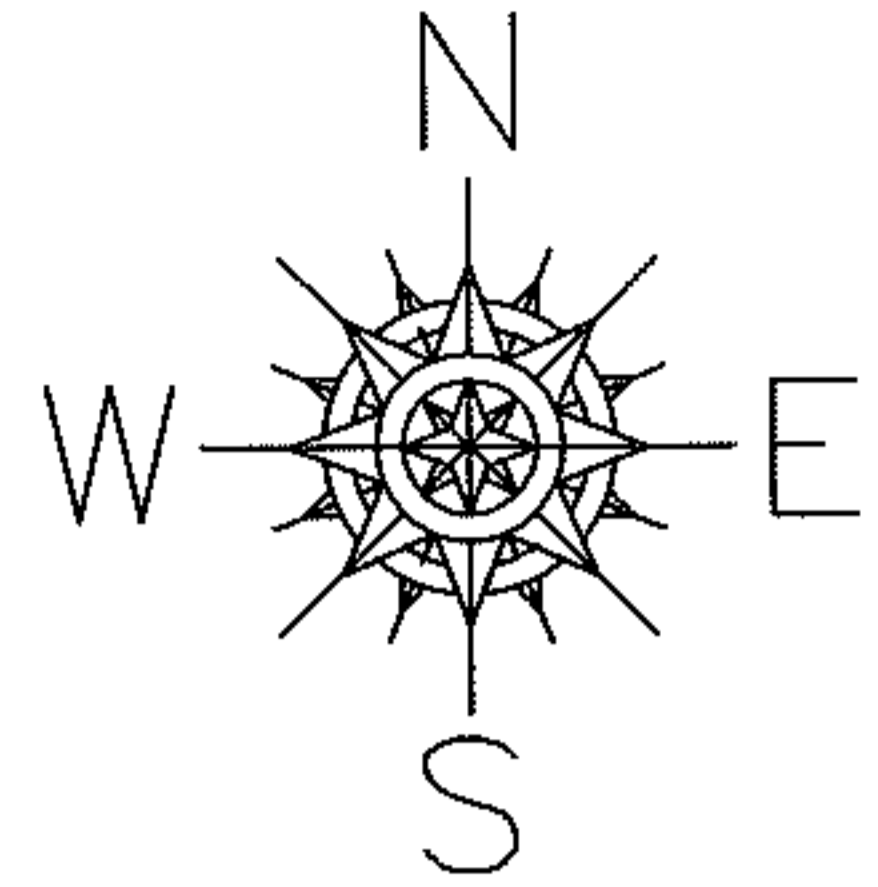

**SPLITS/DEEDS PROCESSED**

LORAIN COUNTY TAX MAP DEPARTMENT  
226 MIDDLE AVE. ELYRIA, OHIO

SURVEYED BY: DAVID ELWELL

CLOSURE: 0.00 : 10,000

MAP PAGE(S): 04-00-015-A

APPROVED BY: JAH DATE: 11-24-08

SCALE: 1" = 200 PRIOR INSTRUMENT: 20080266414