


PARENT PARCEL: 10-00-008-103-003

CHILD PARCEL: DROP FROM DUPLICATE

STARTING POINT: XXXXXX

12-02640-D

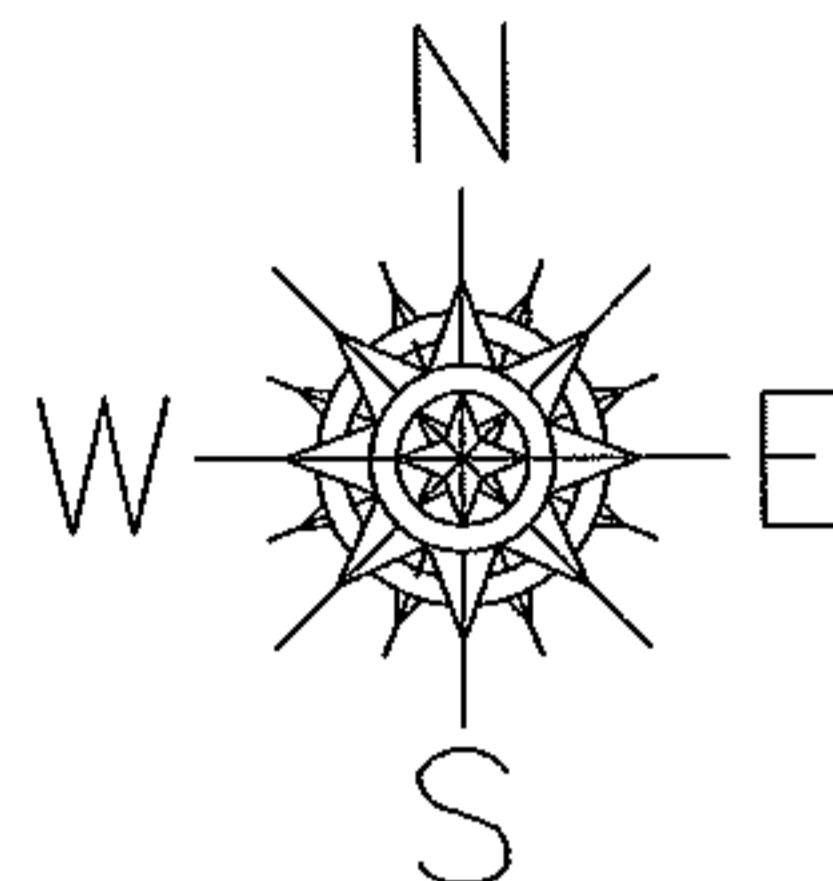

DROP FROM DUPLICATE

~~10-00-008-103-003~~


~~0.13 A.~~

DOUBLE ASSIGNED P.P.N.

EXISTS AS

10-00-009-108-002

0.25 A.

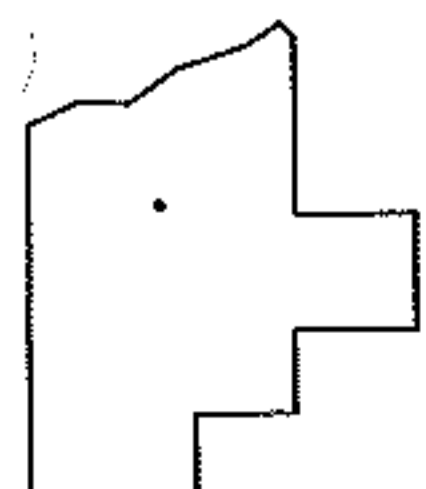

SPLITS/DEEDS PROCESSED

LORAIN COUNTY TAX MAP DEPARTMENT  
226 MIDDLE AVE. ELYRIA, OHIO

SURVEYED BY: NONE

CLOSURE: NONE

MAP PAGE(S): 10-00-009-D

APPROVED BY: TJS DATE: 12/27/12

SCALE: 1"=100 PRIOR INST.: DV 514/218