




RASTER

PARENT PARCEL: 15-00-024-000-052

CHILD PARCEL: 15-00-024-000-055 THRU -062

STARTING POINT: CENTERLINE OF BIGGS RD & WHITEHEAD RD

08-02640

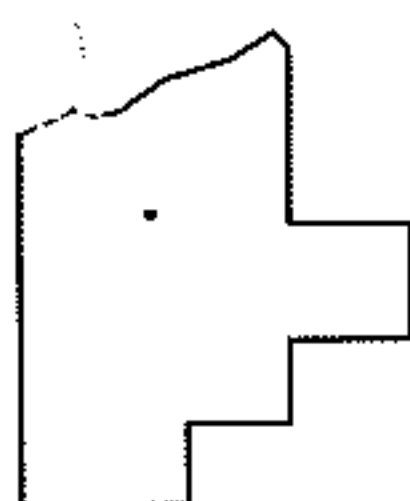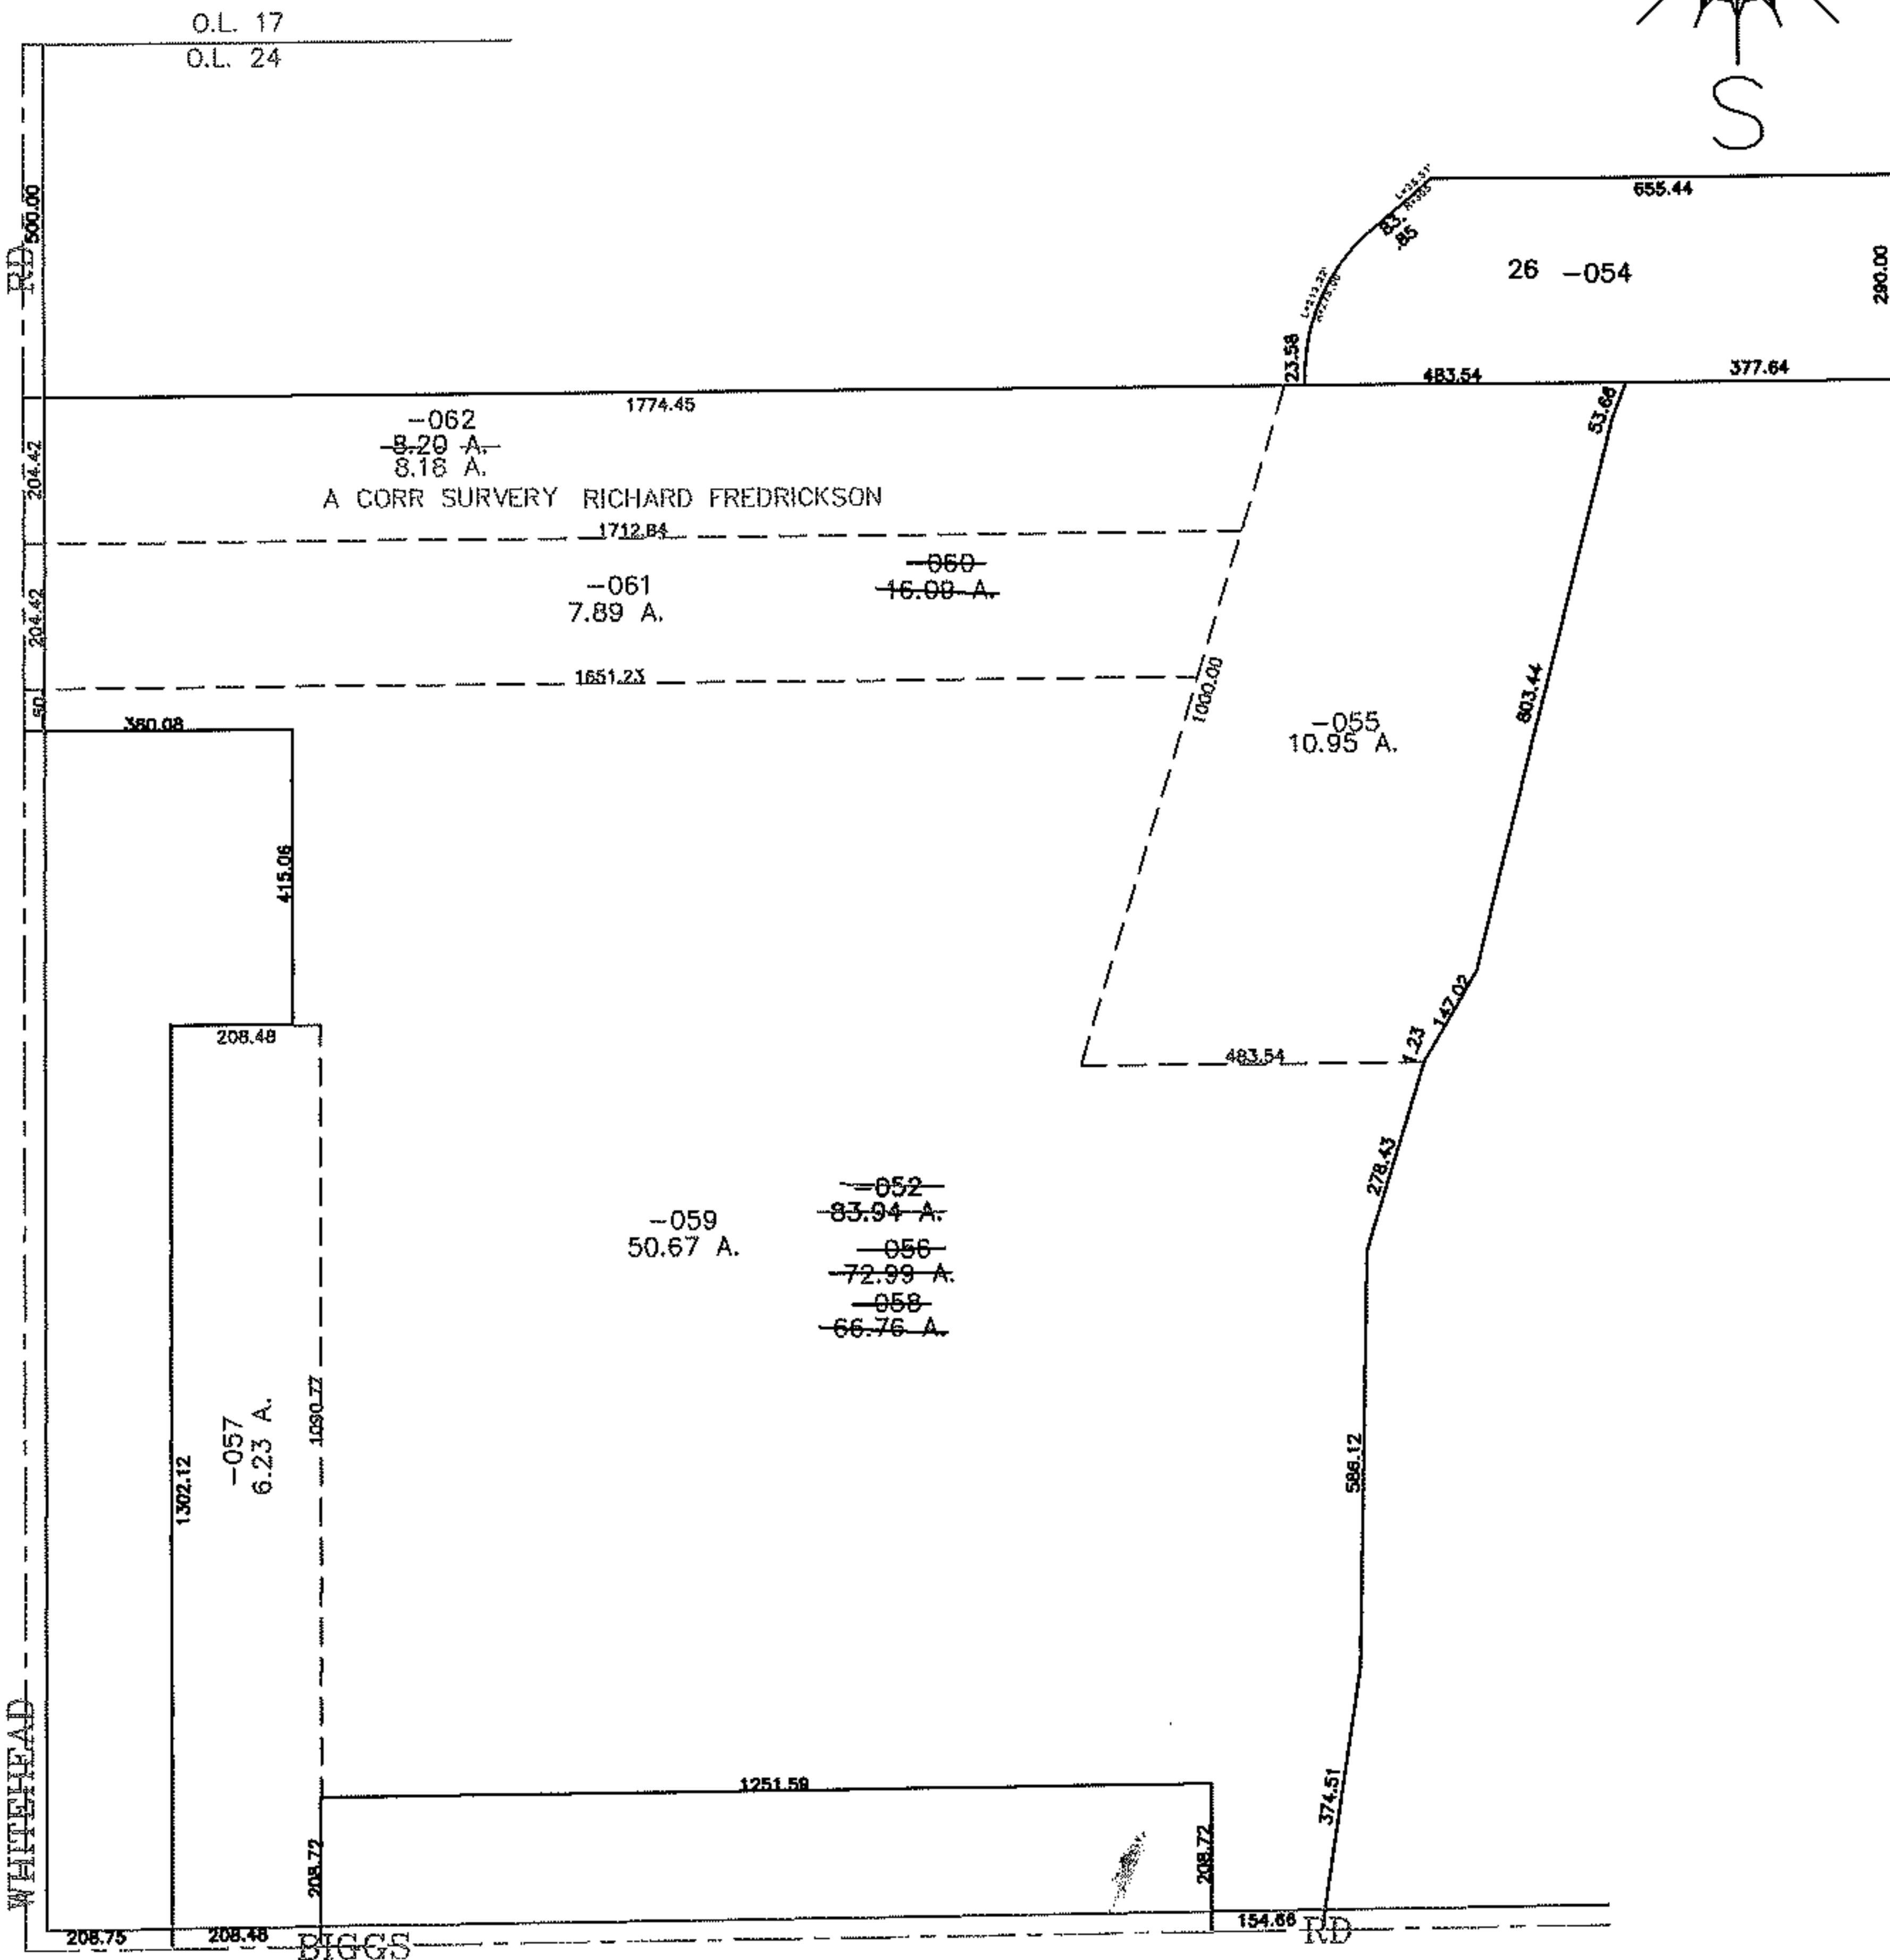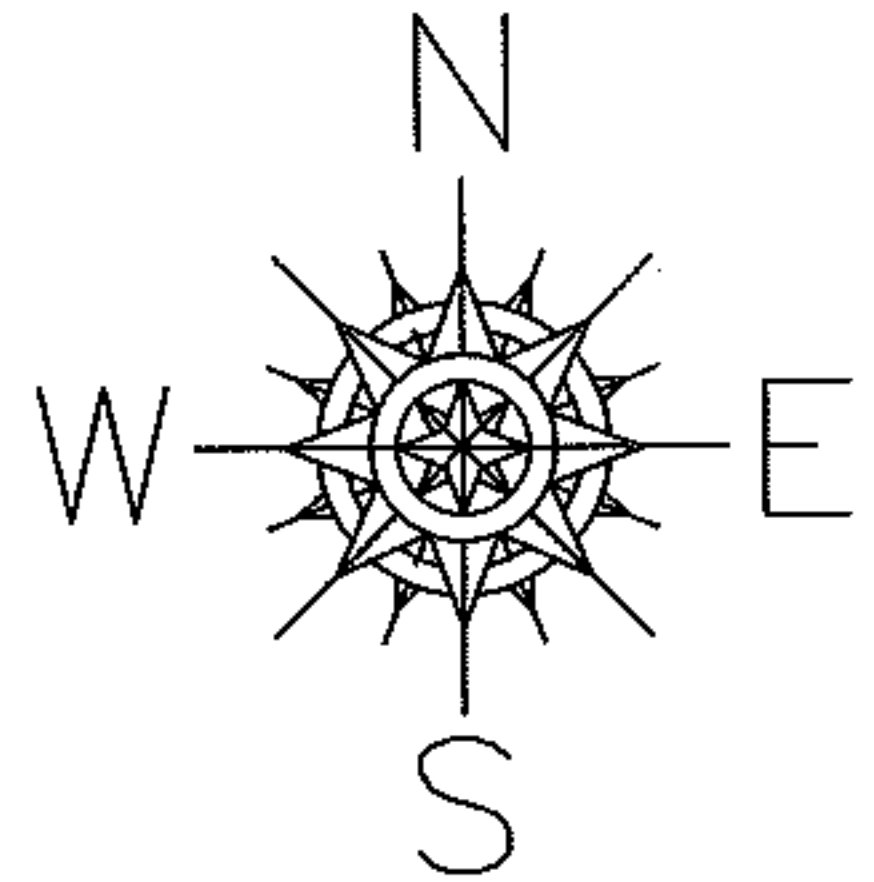

SPLITS/DEEDS PROCESSED

LORAIN COUNTY TAX MAP DEPARTMENT
226 MIDDLE AVE. ELYRIA, OHIO

SURVEYED BY: RICHARD FREDRICKSON

CLOSURE: 0.00 : 10.000

MAP PAGE(S): 15-B

APPROVED BY: JAH DATE: 11-25-08

SCALE: 1" = 100 PRIOR INSTRUMENT: 20030919141